GLEN WHITE COAL AND LUMBER CO.

MAP OF MINE IN
BROOKVILLE SEAM
AT GLEN WHITE

SCALE 1"=100' SEPT. 9, 1925

W.A. SILLIMAN.
ENGINEER.

C7B7-6

L-7

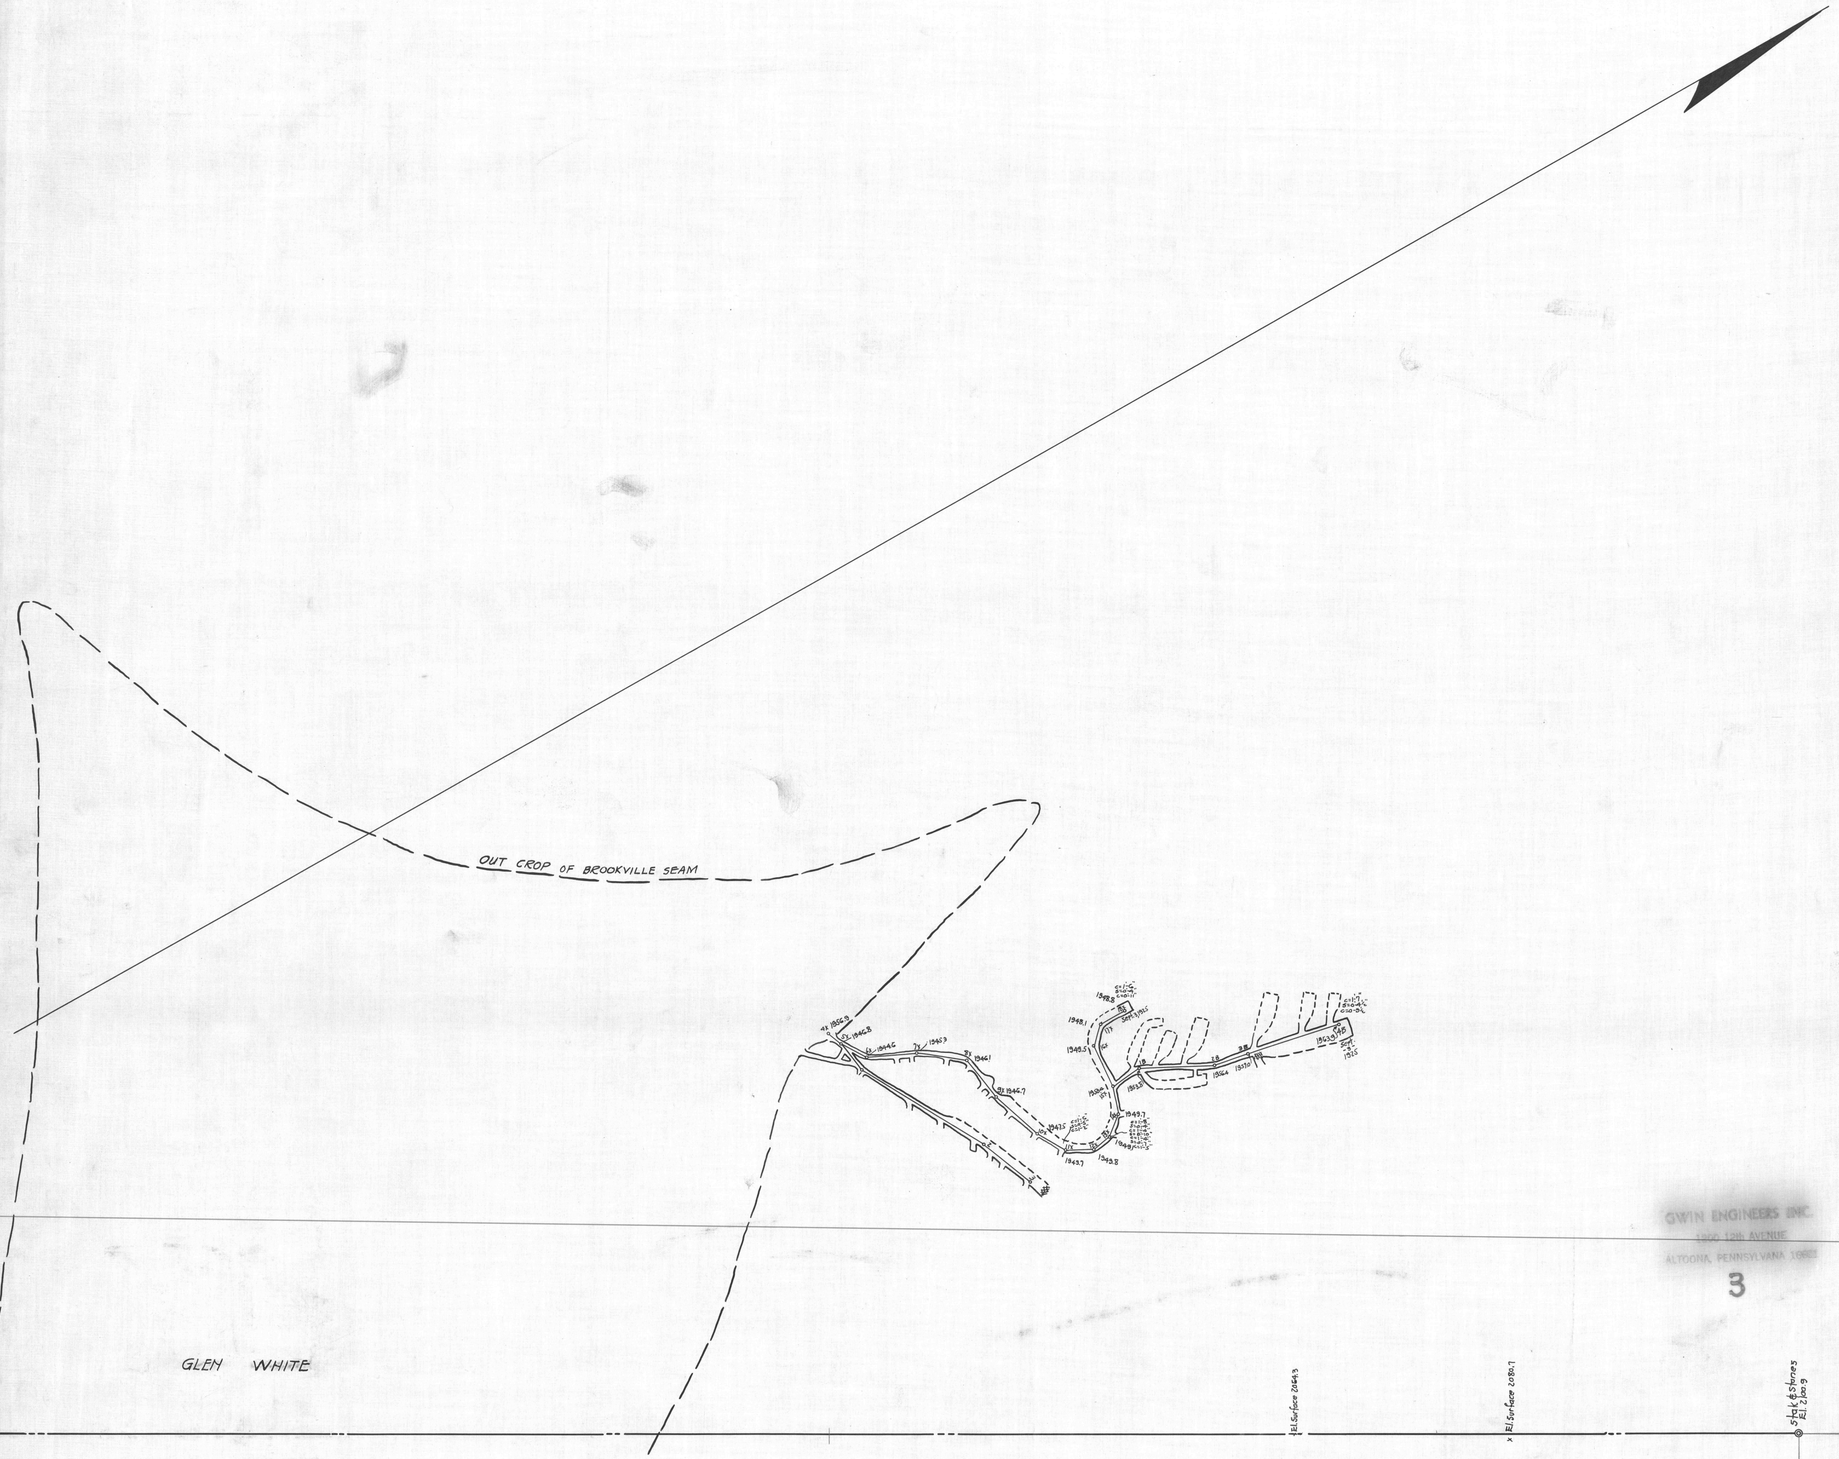

GWIN ENGINEERS INC.
1900 12th AVENUE
ALTOONA, PENNSYLVANIA 16601

3

L-7