


H-76

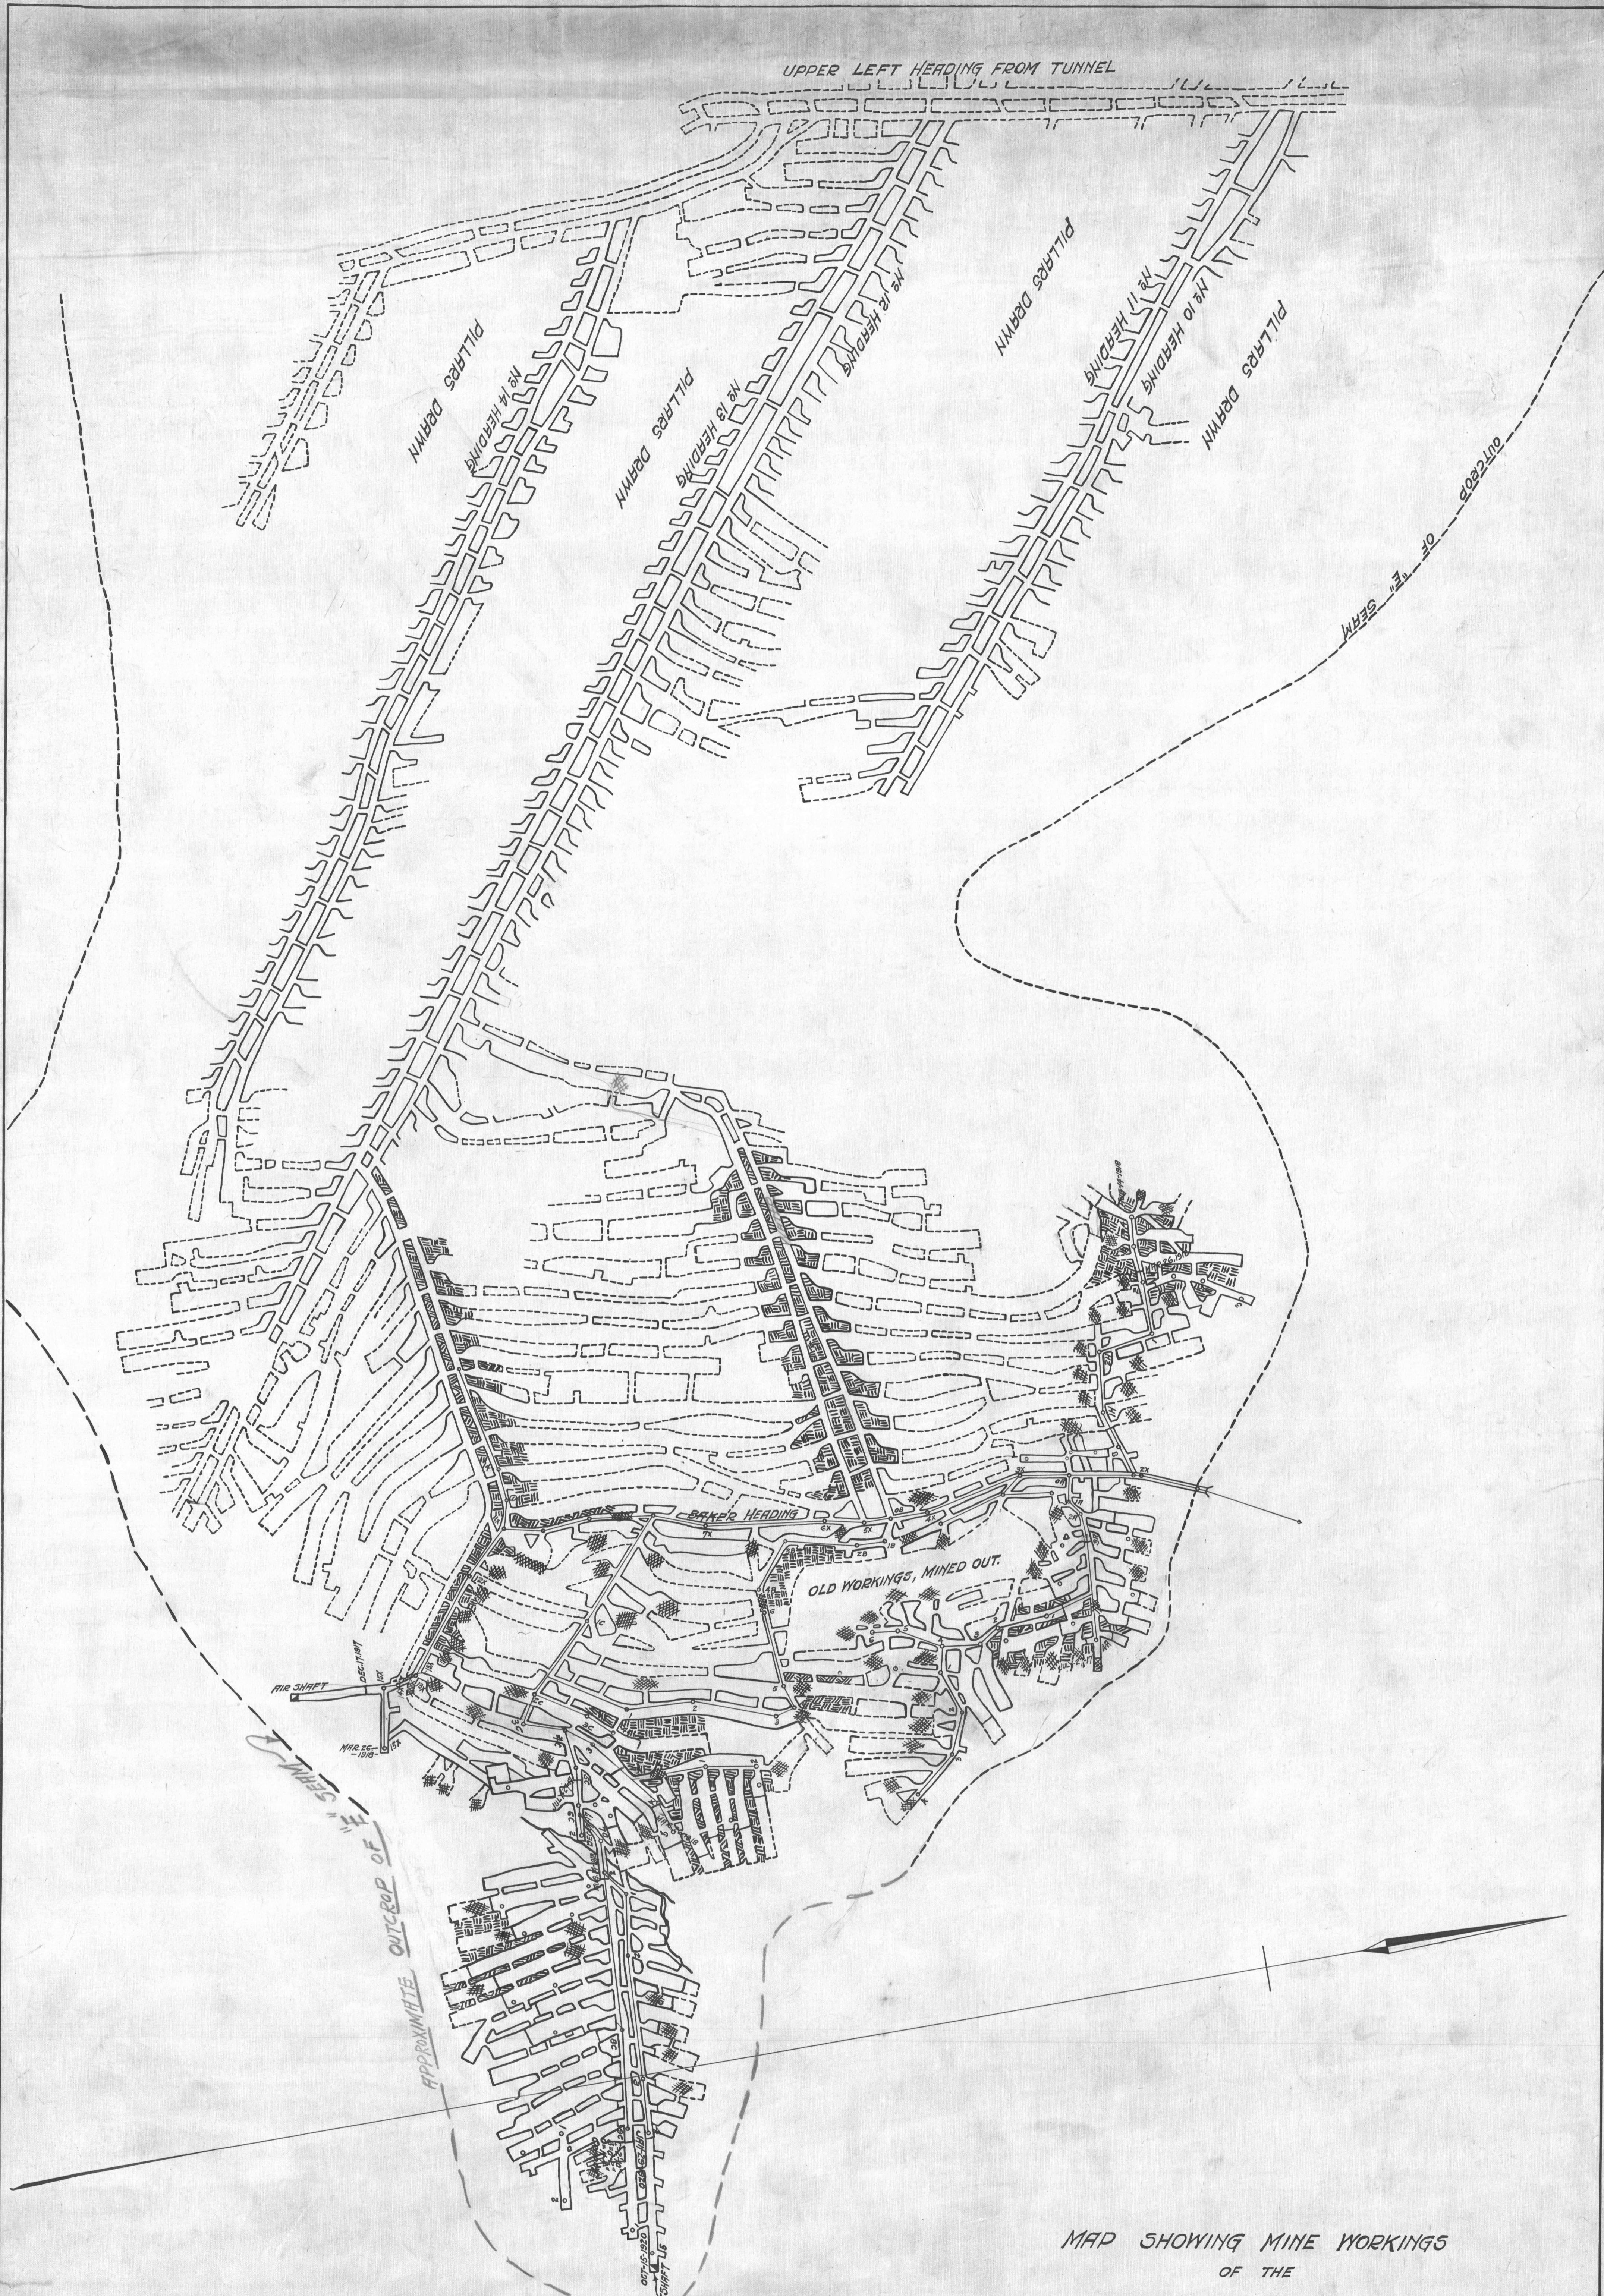

MAP SHOWING MINE WORKINGS  
 OF THE  
 OLD BAKER DRIFT  
 AND PART OF  
 TUNNEL WORKINGS OF ALTOONA COAL & COKE CO.  
 NEAR COUPON, BLAIR AND CAMBRIA CO'S. PENNA.  
 SCALE-1"=100'

J.S. SILLYMAN & CO.  
 ENGINEERS.

C7C1-5

H-76