


MAP SHOWING MINE WORKINGS  
IN THE "B" SEAM  
ON THE JOSIAH CHRISTY TRACT  
OF THE  
ALTONA COAL & COKE CO.  
GALLITZIN TWP, GRAMBLIN CO., PA  
U.S. SILVERMAN & CO.  
ENGINEERS

SCALE: 1"=100'

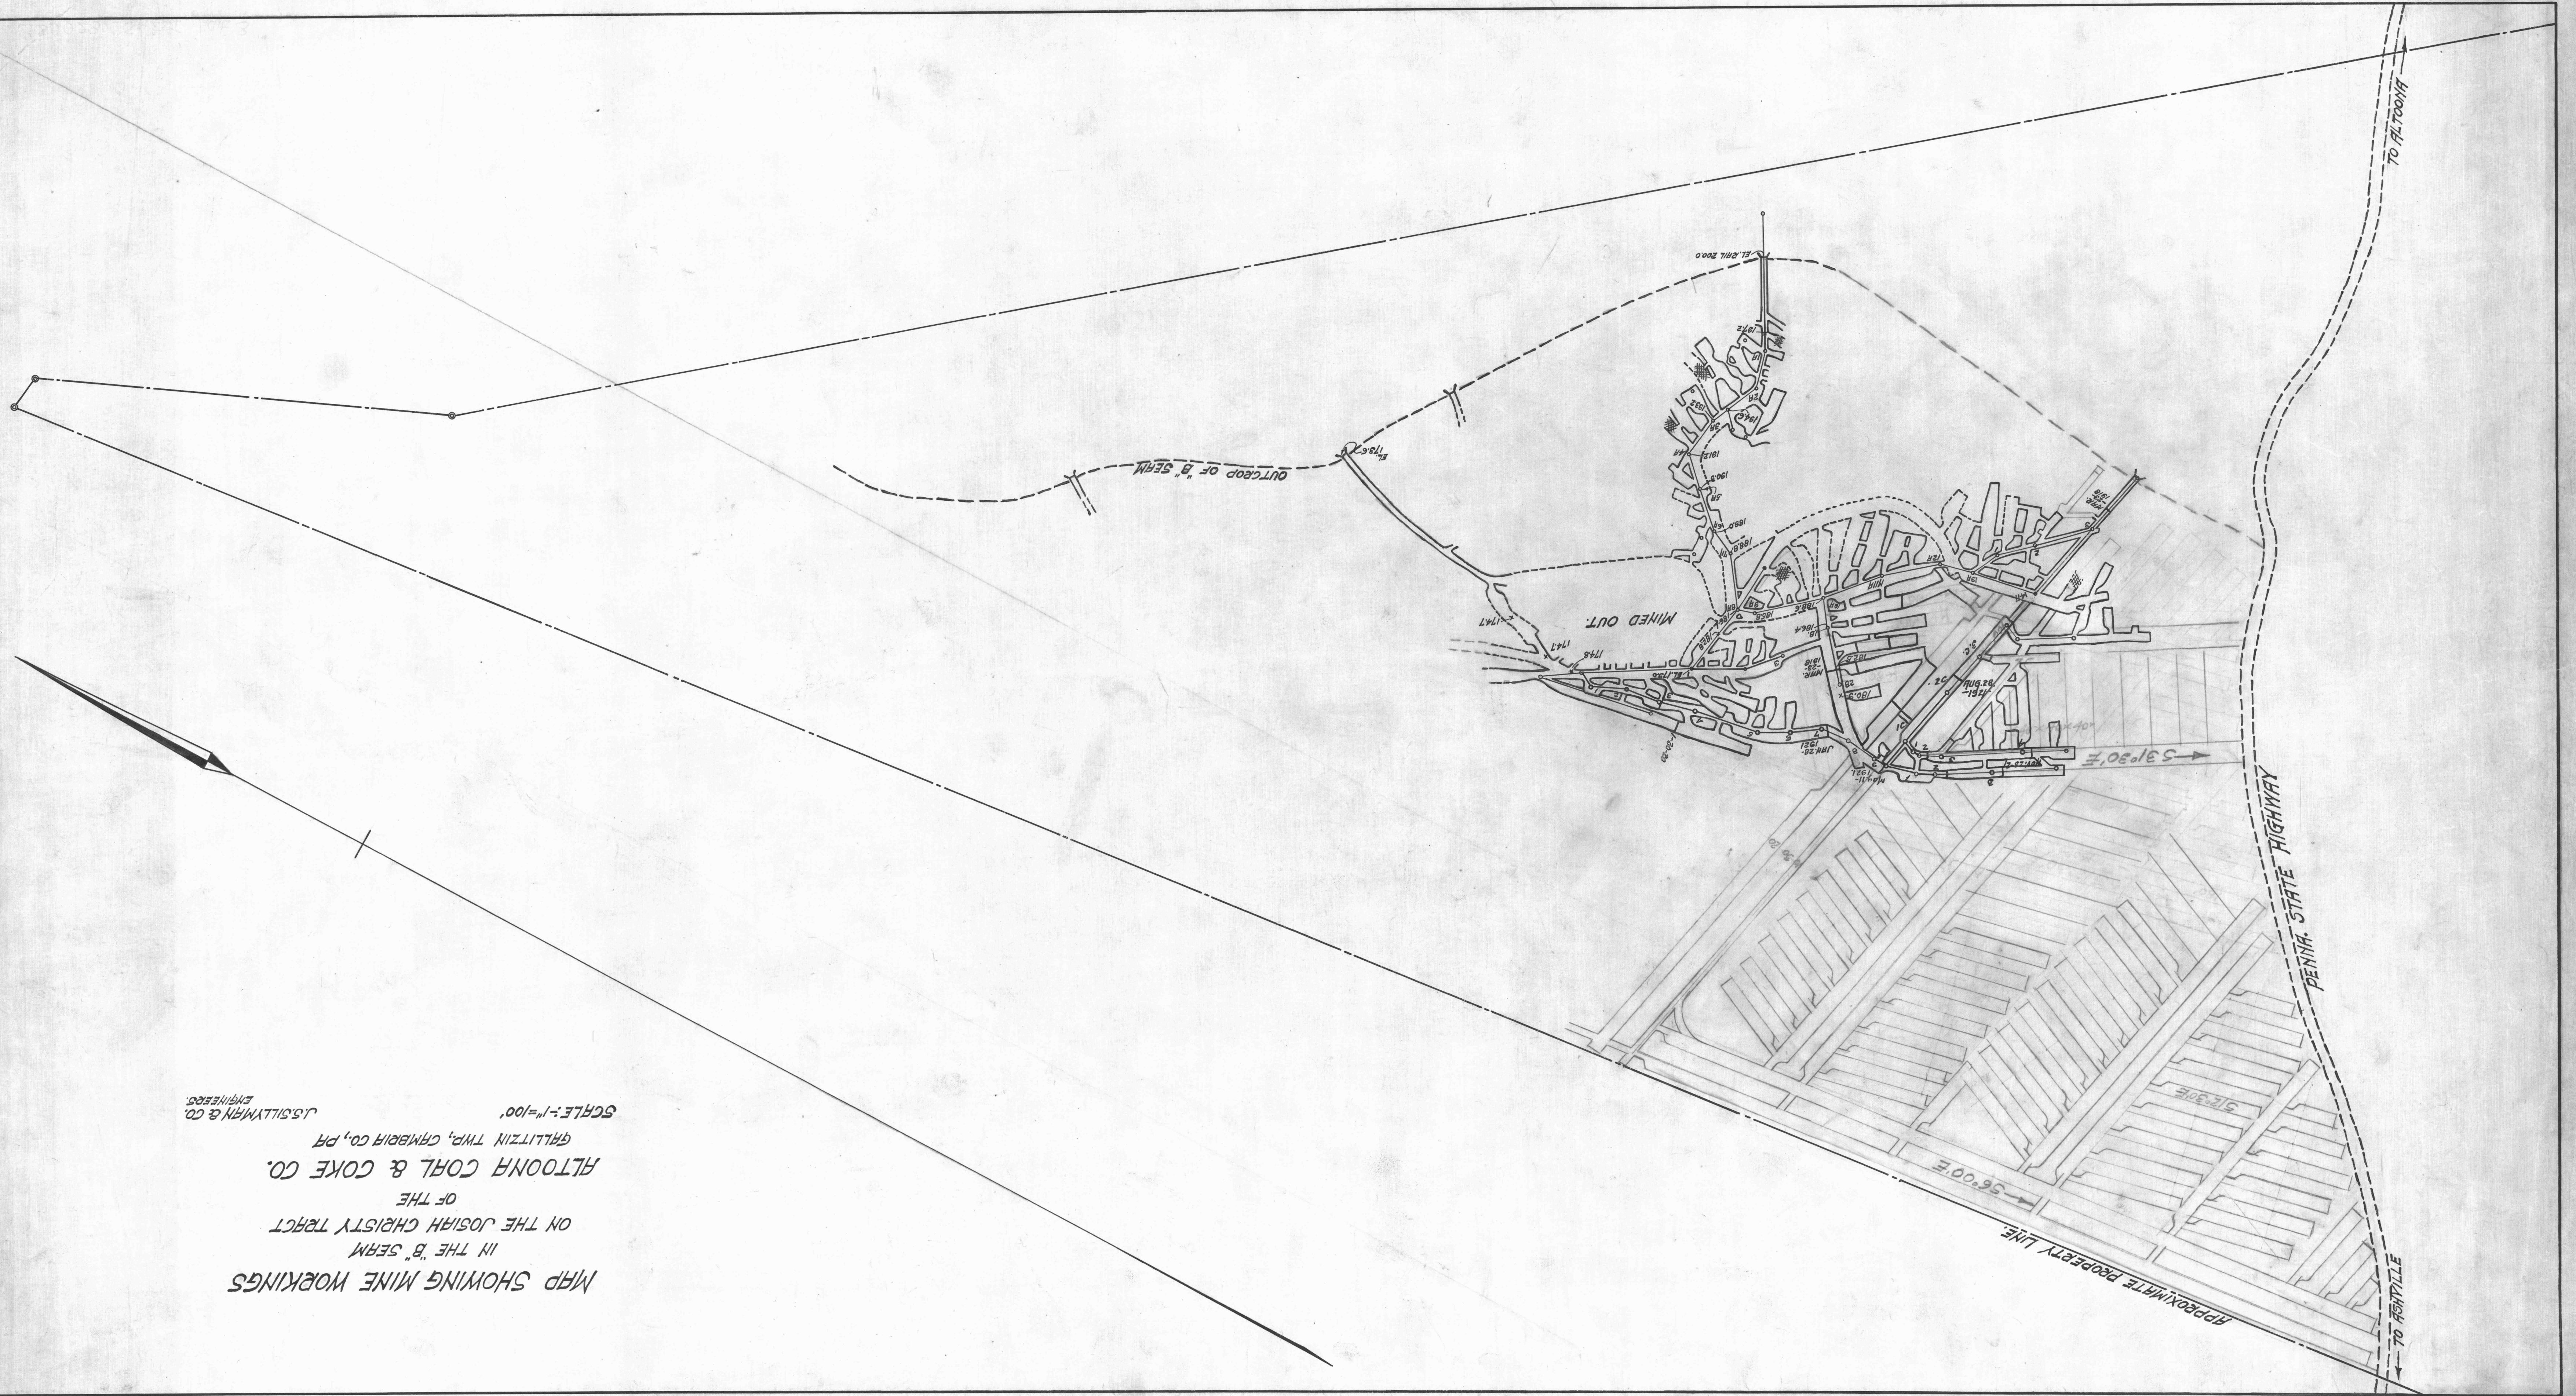

1894