


ANDREY GRAYDON Y/T.
 BLOSSBURG COAL COMPANY LANDS

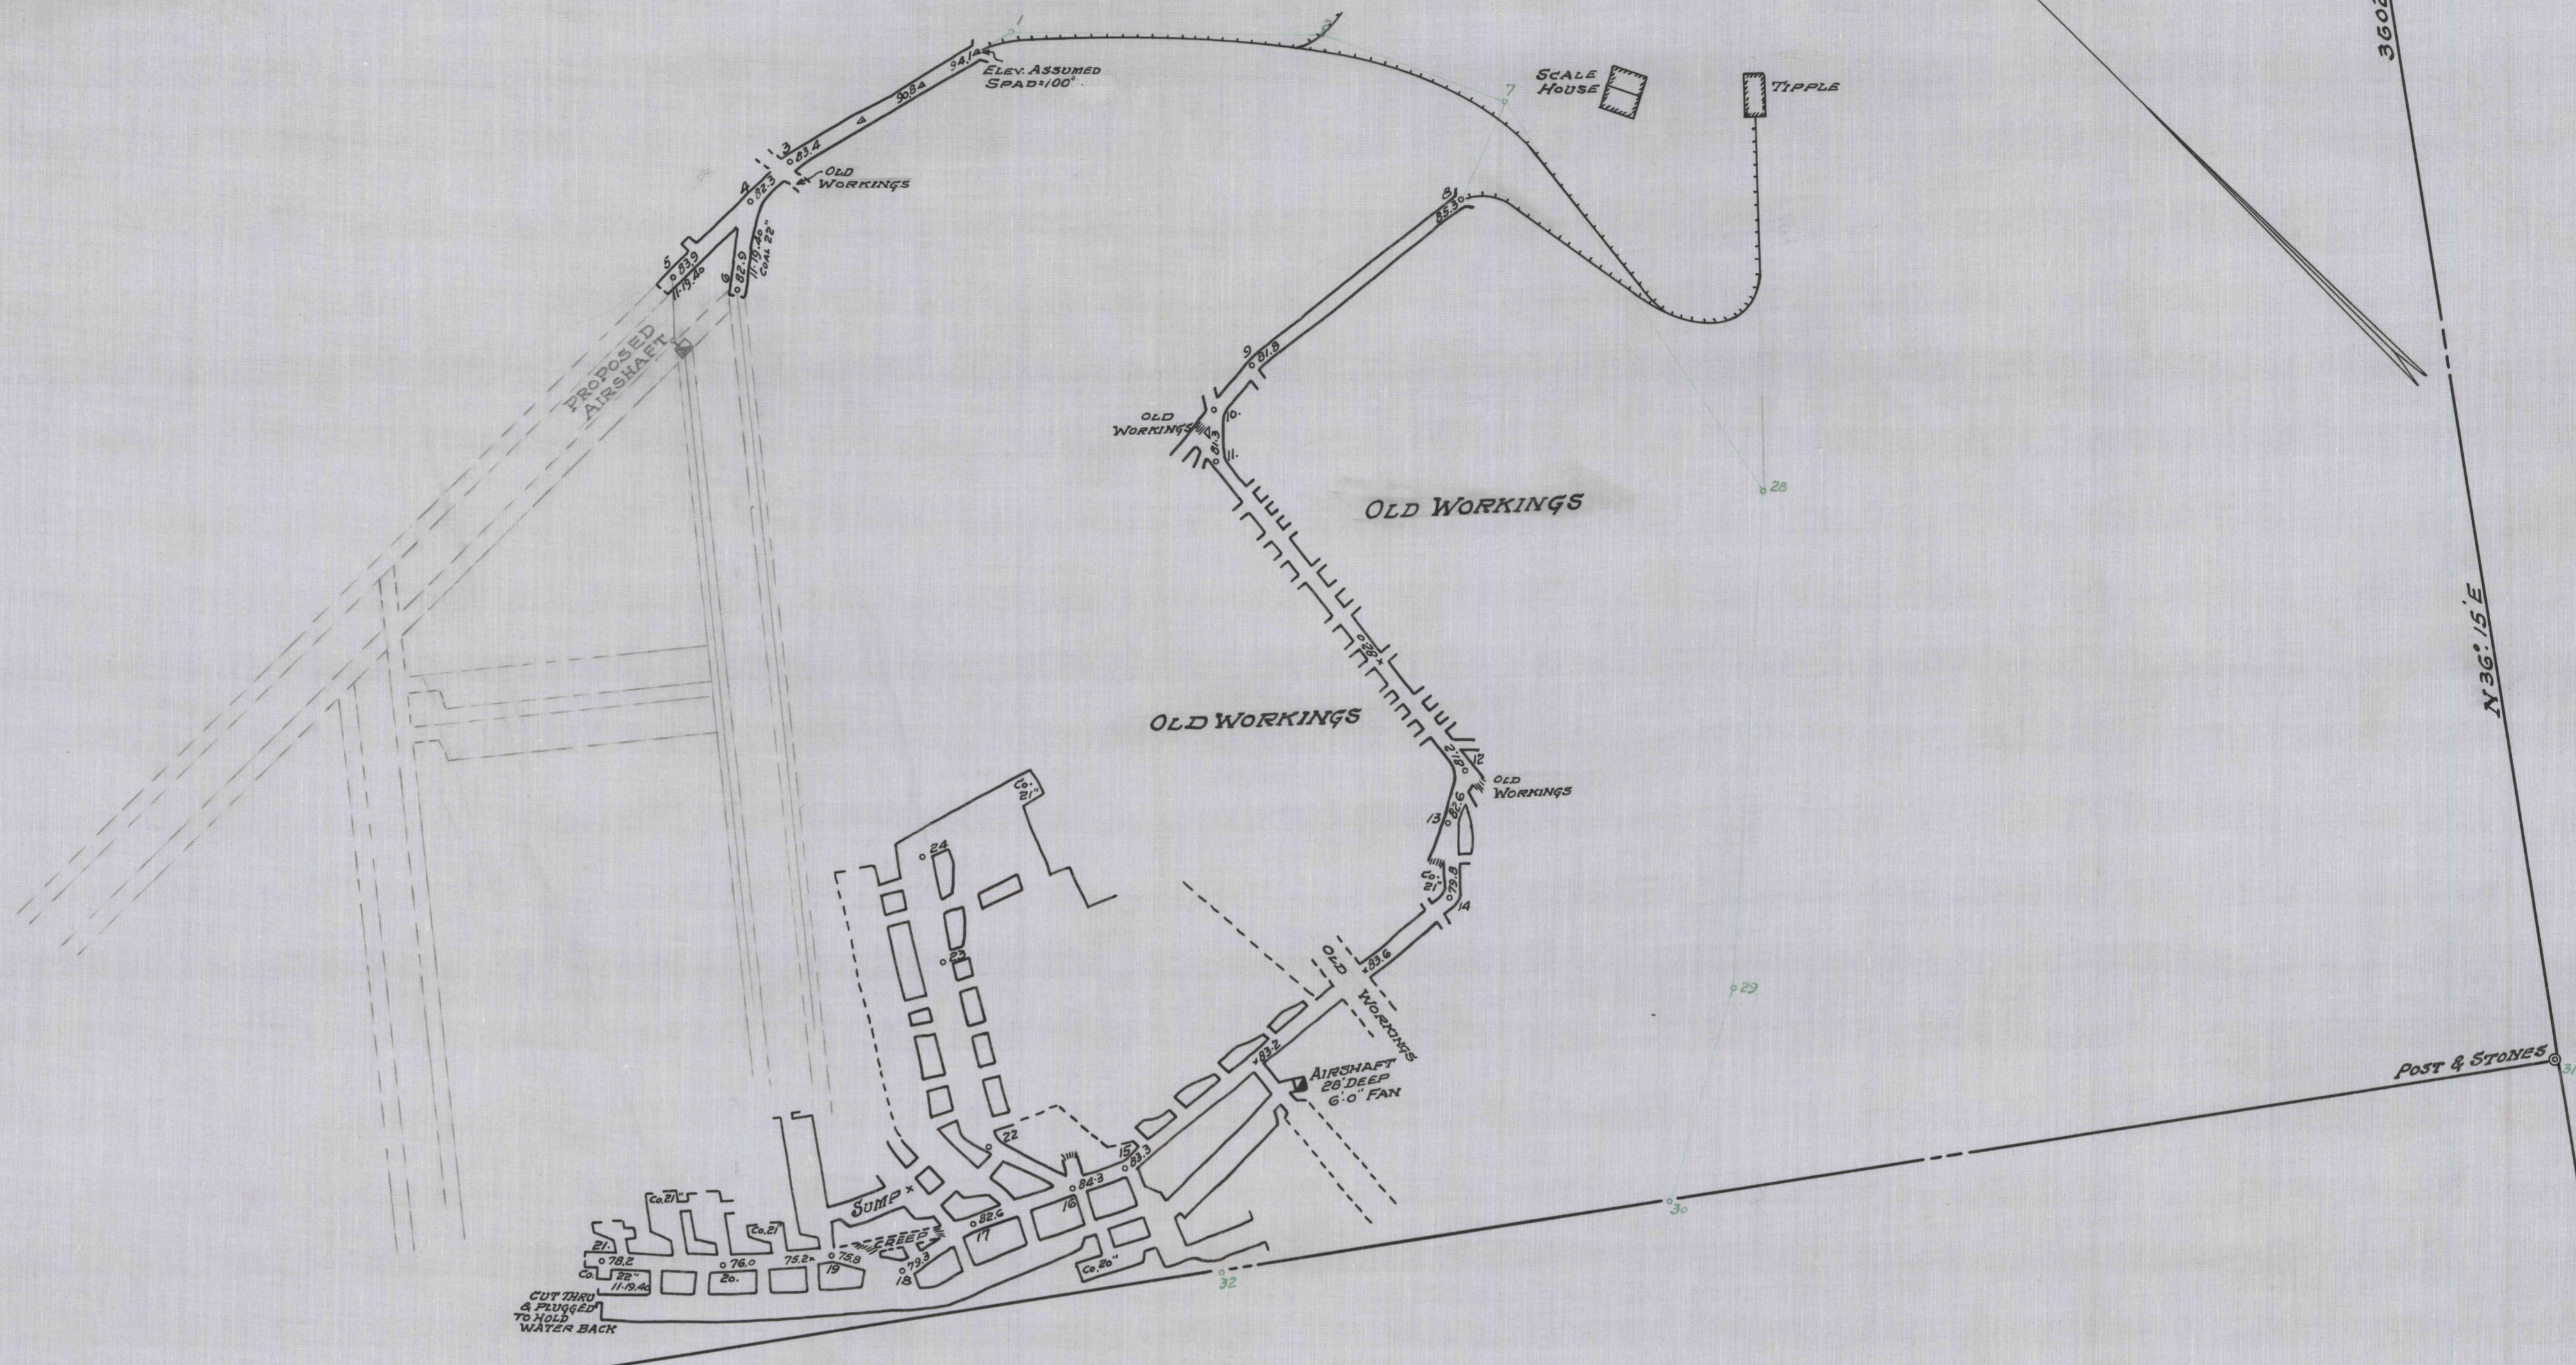

JACOB COX Y/T.
 STATE GAME LANDS No 12

SURVEYED BY F.C. KLINE Nov. 19. 1940

NORTHWESTERN MINING & EXCHANGE CO. BLOSSBURG COAL COMPANY OFFICE OF CHIEF ENGINEER, DUBOIS, PA.	
MAP OF JOSEPH PELTON MINE ON LANDS OF BLOSSBURG COAL CO BARCLAY TWP - BRADFORD CO. PA.	
DATE Nov. 19. 1940	SCALE 100' = 1"
CORRECT <i>J.C. Kline</i>	REISSUED
APPROVED <i>J.C. Kline</i>	DRAWING