


Mined out  
Steppings

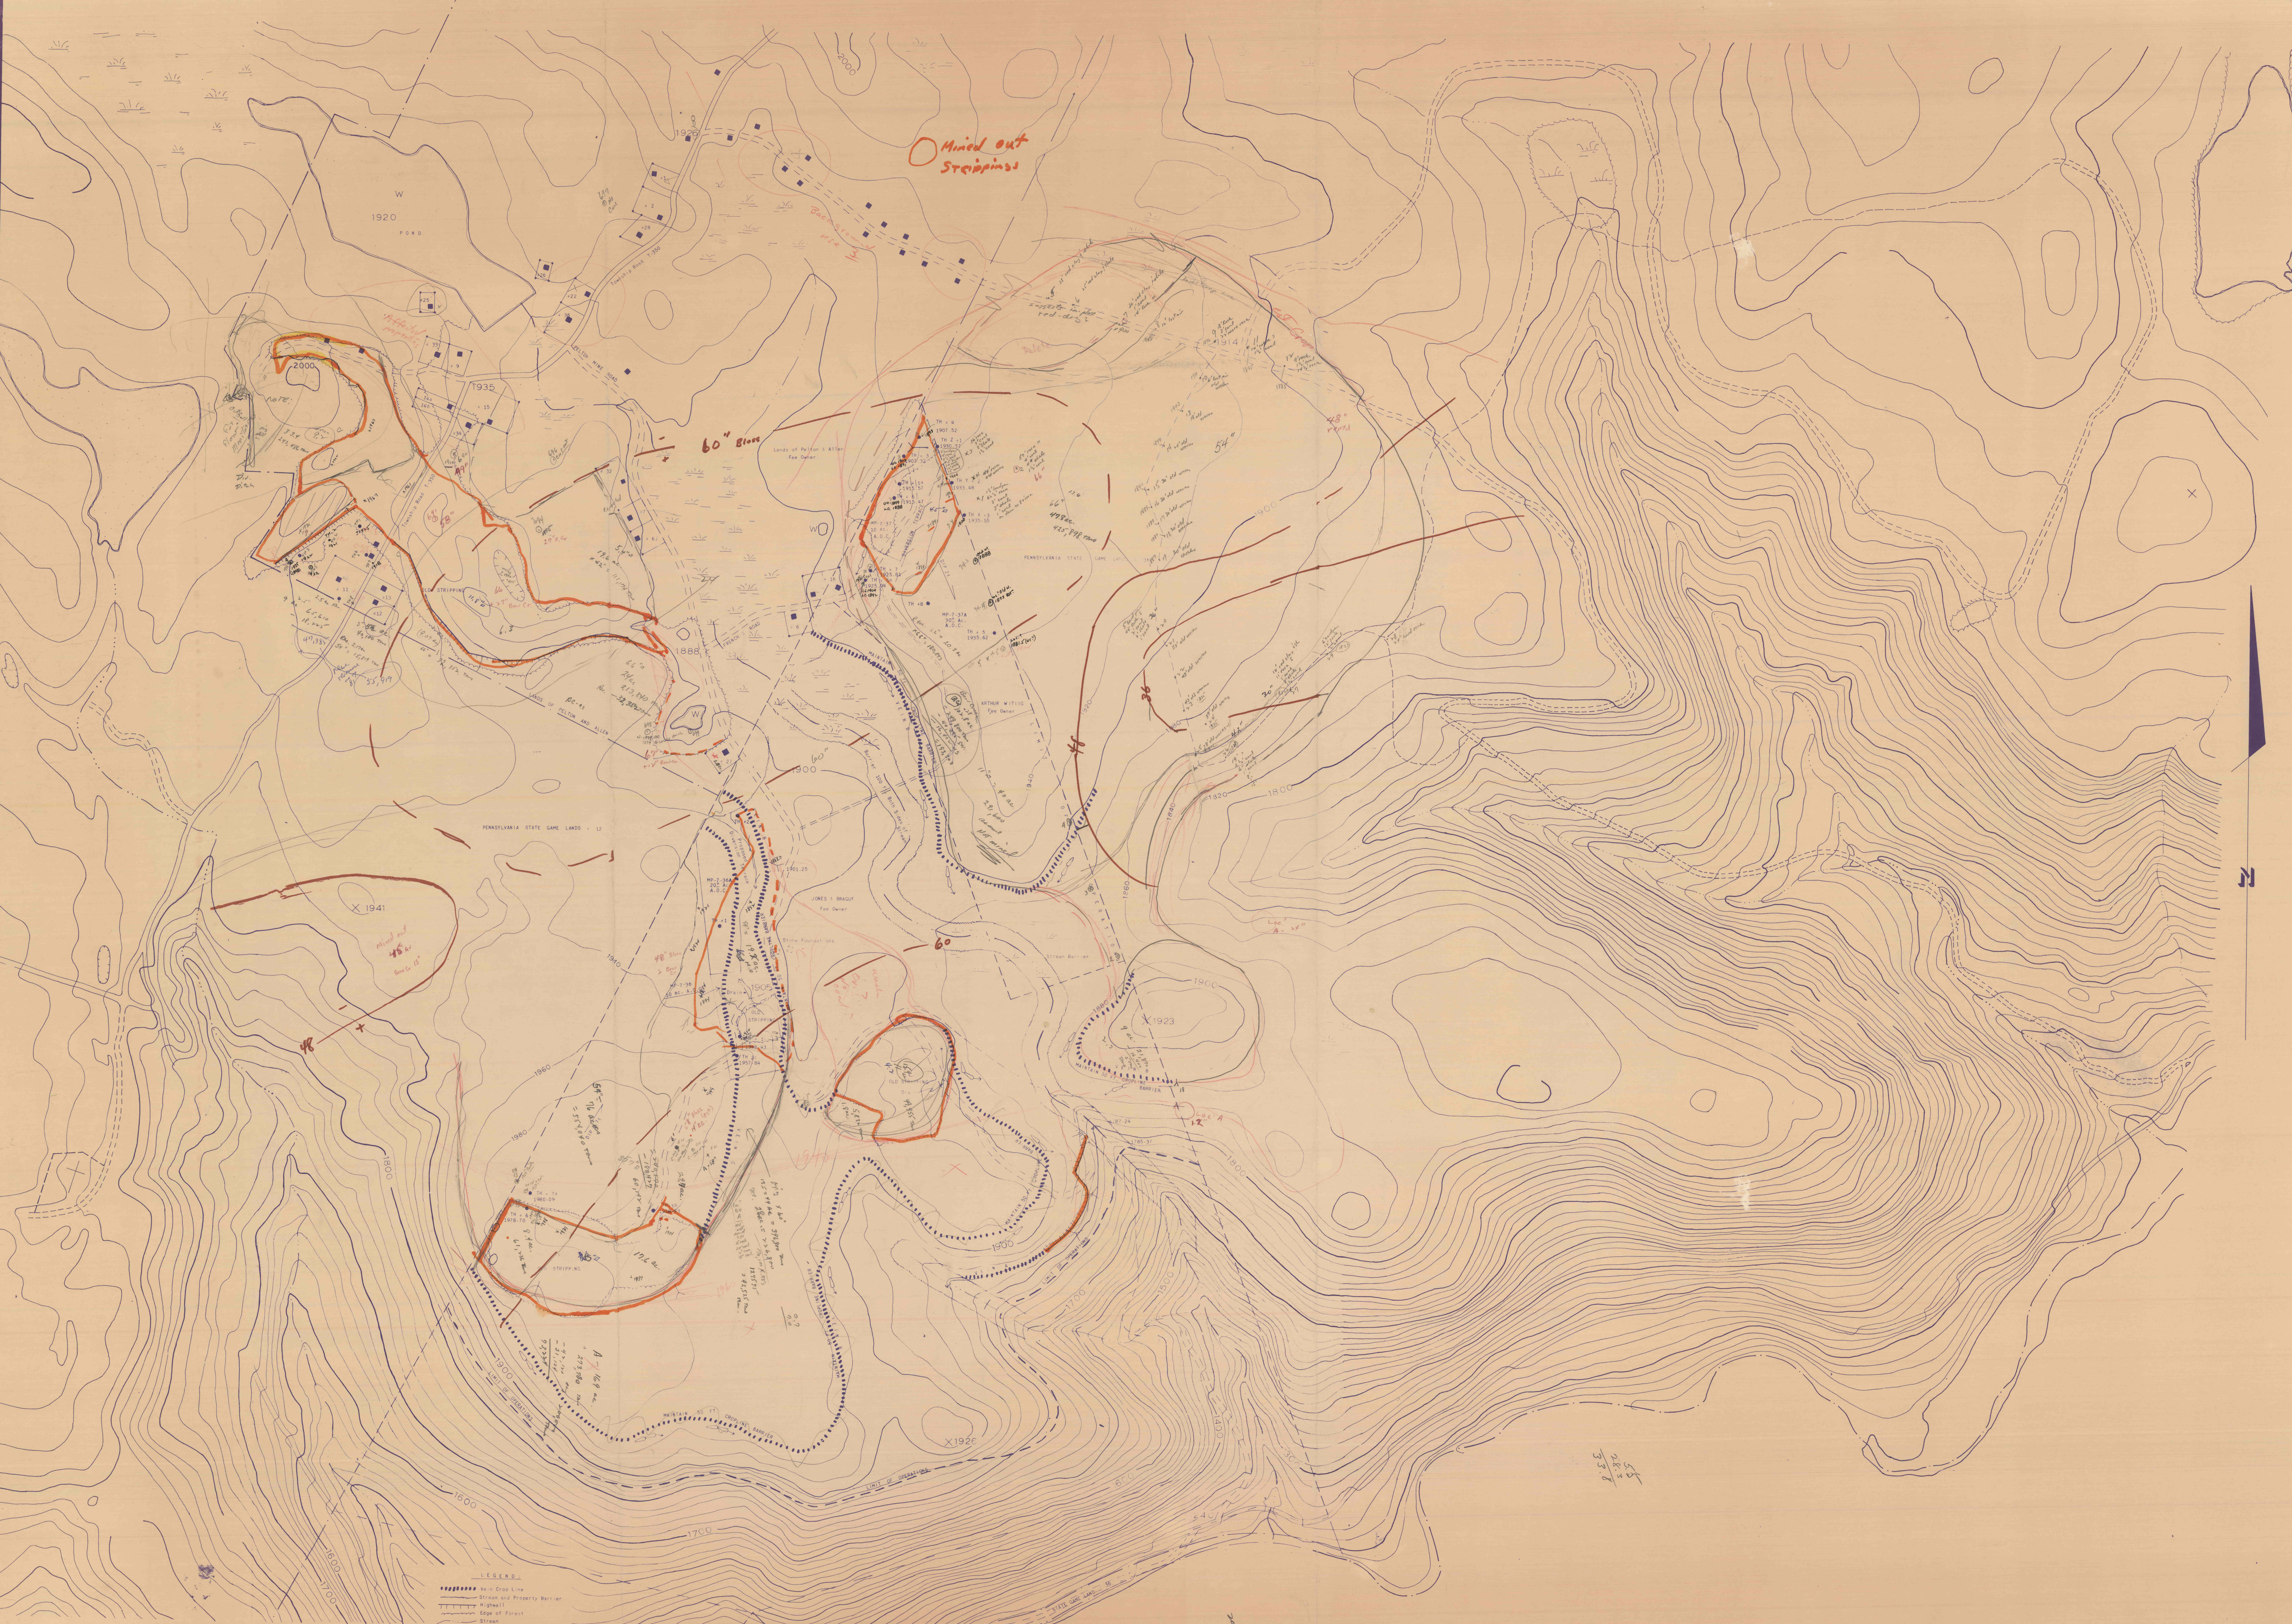

LEGEND

- Vein Crop Line
- Stream and Property Barrier
- Highway
- Edge of Forest
- Stream
- Lines of Operations
- Mine Drifts
- Marking Posts
- Test Holes



5/3  
2/28