


BRA-2

BARCKGBA

Andrew GRAYDON WT  
Blossburg Coal Company Lands

Surveyed  
F.C. Kline  
Nov. 19, 1940

Sr. 5  
Map of Joseph Pelton Mine  
On lands of Blossburg Coal Co  
Barclay Twp., Bradford Co.  
Pa.  
Tracing Earle HAAS  
5/19/48

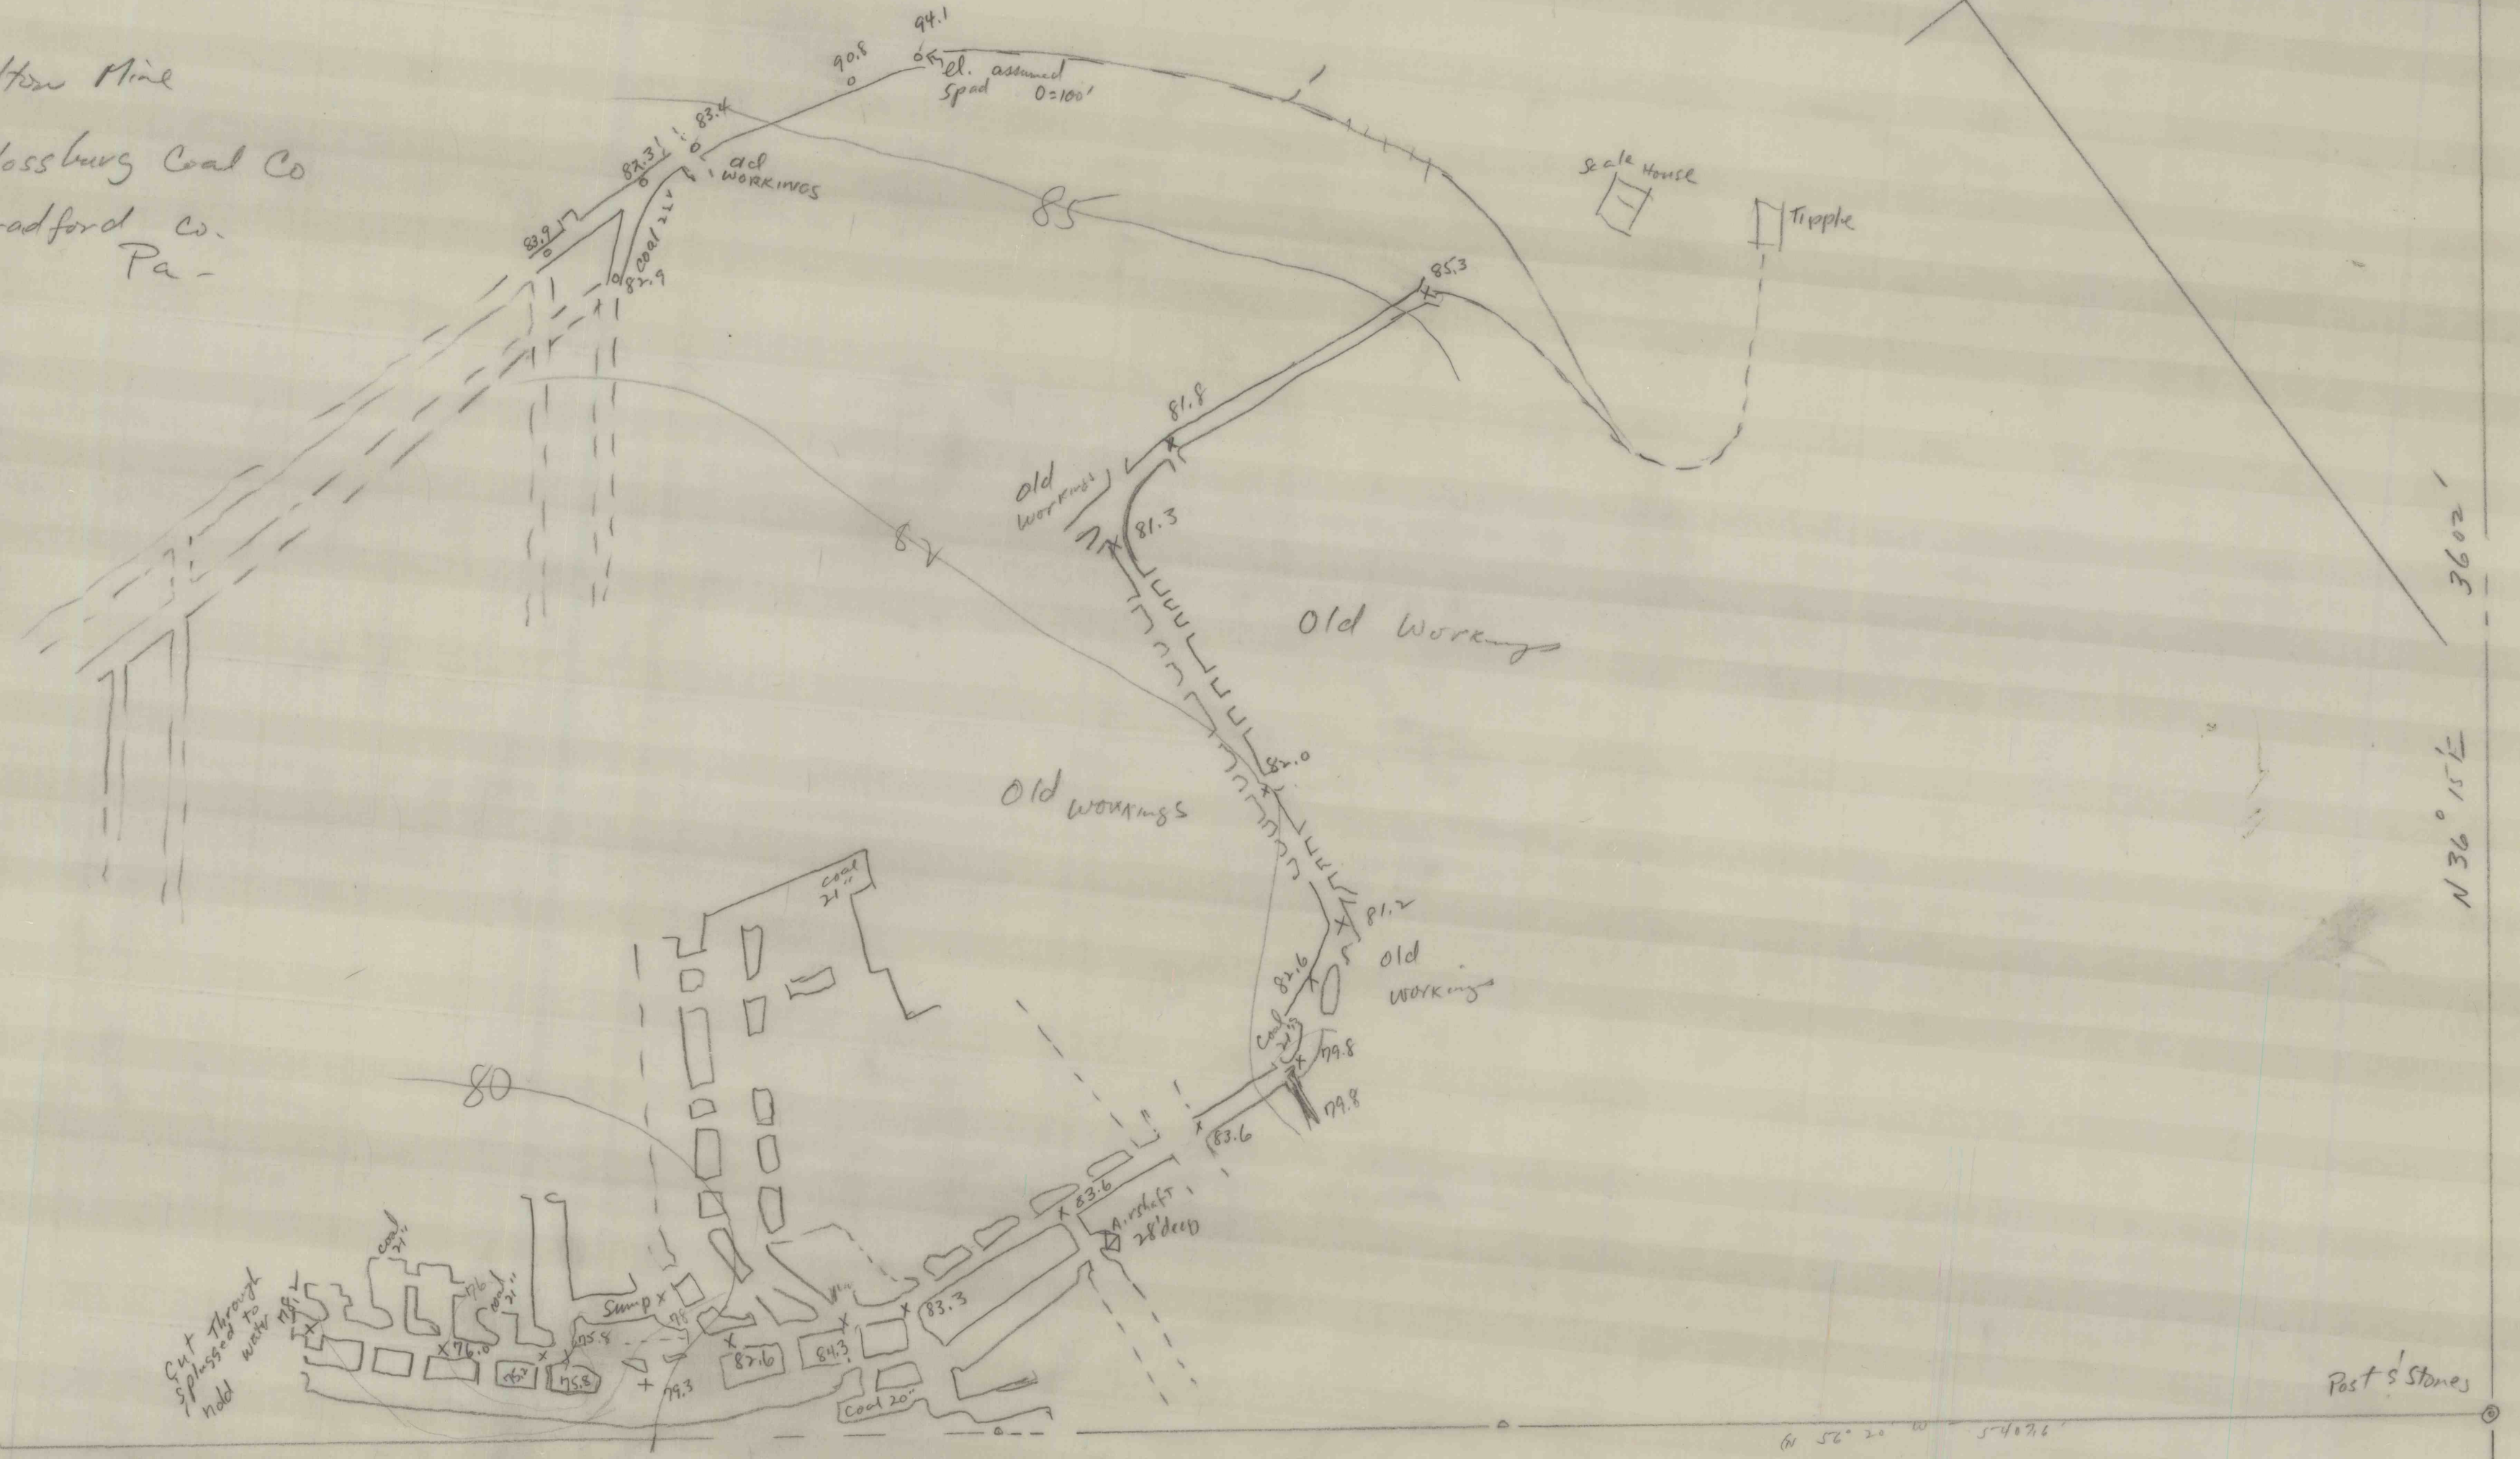

Jacob Coy WT. STATE GAME LANDS No. 12