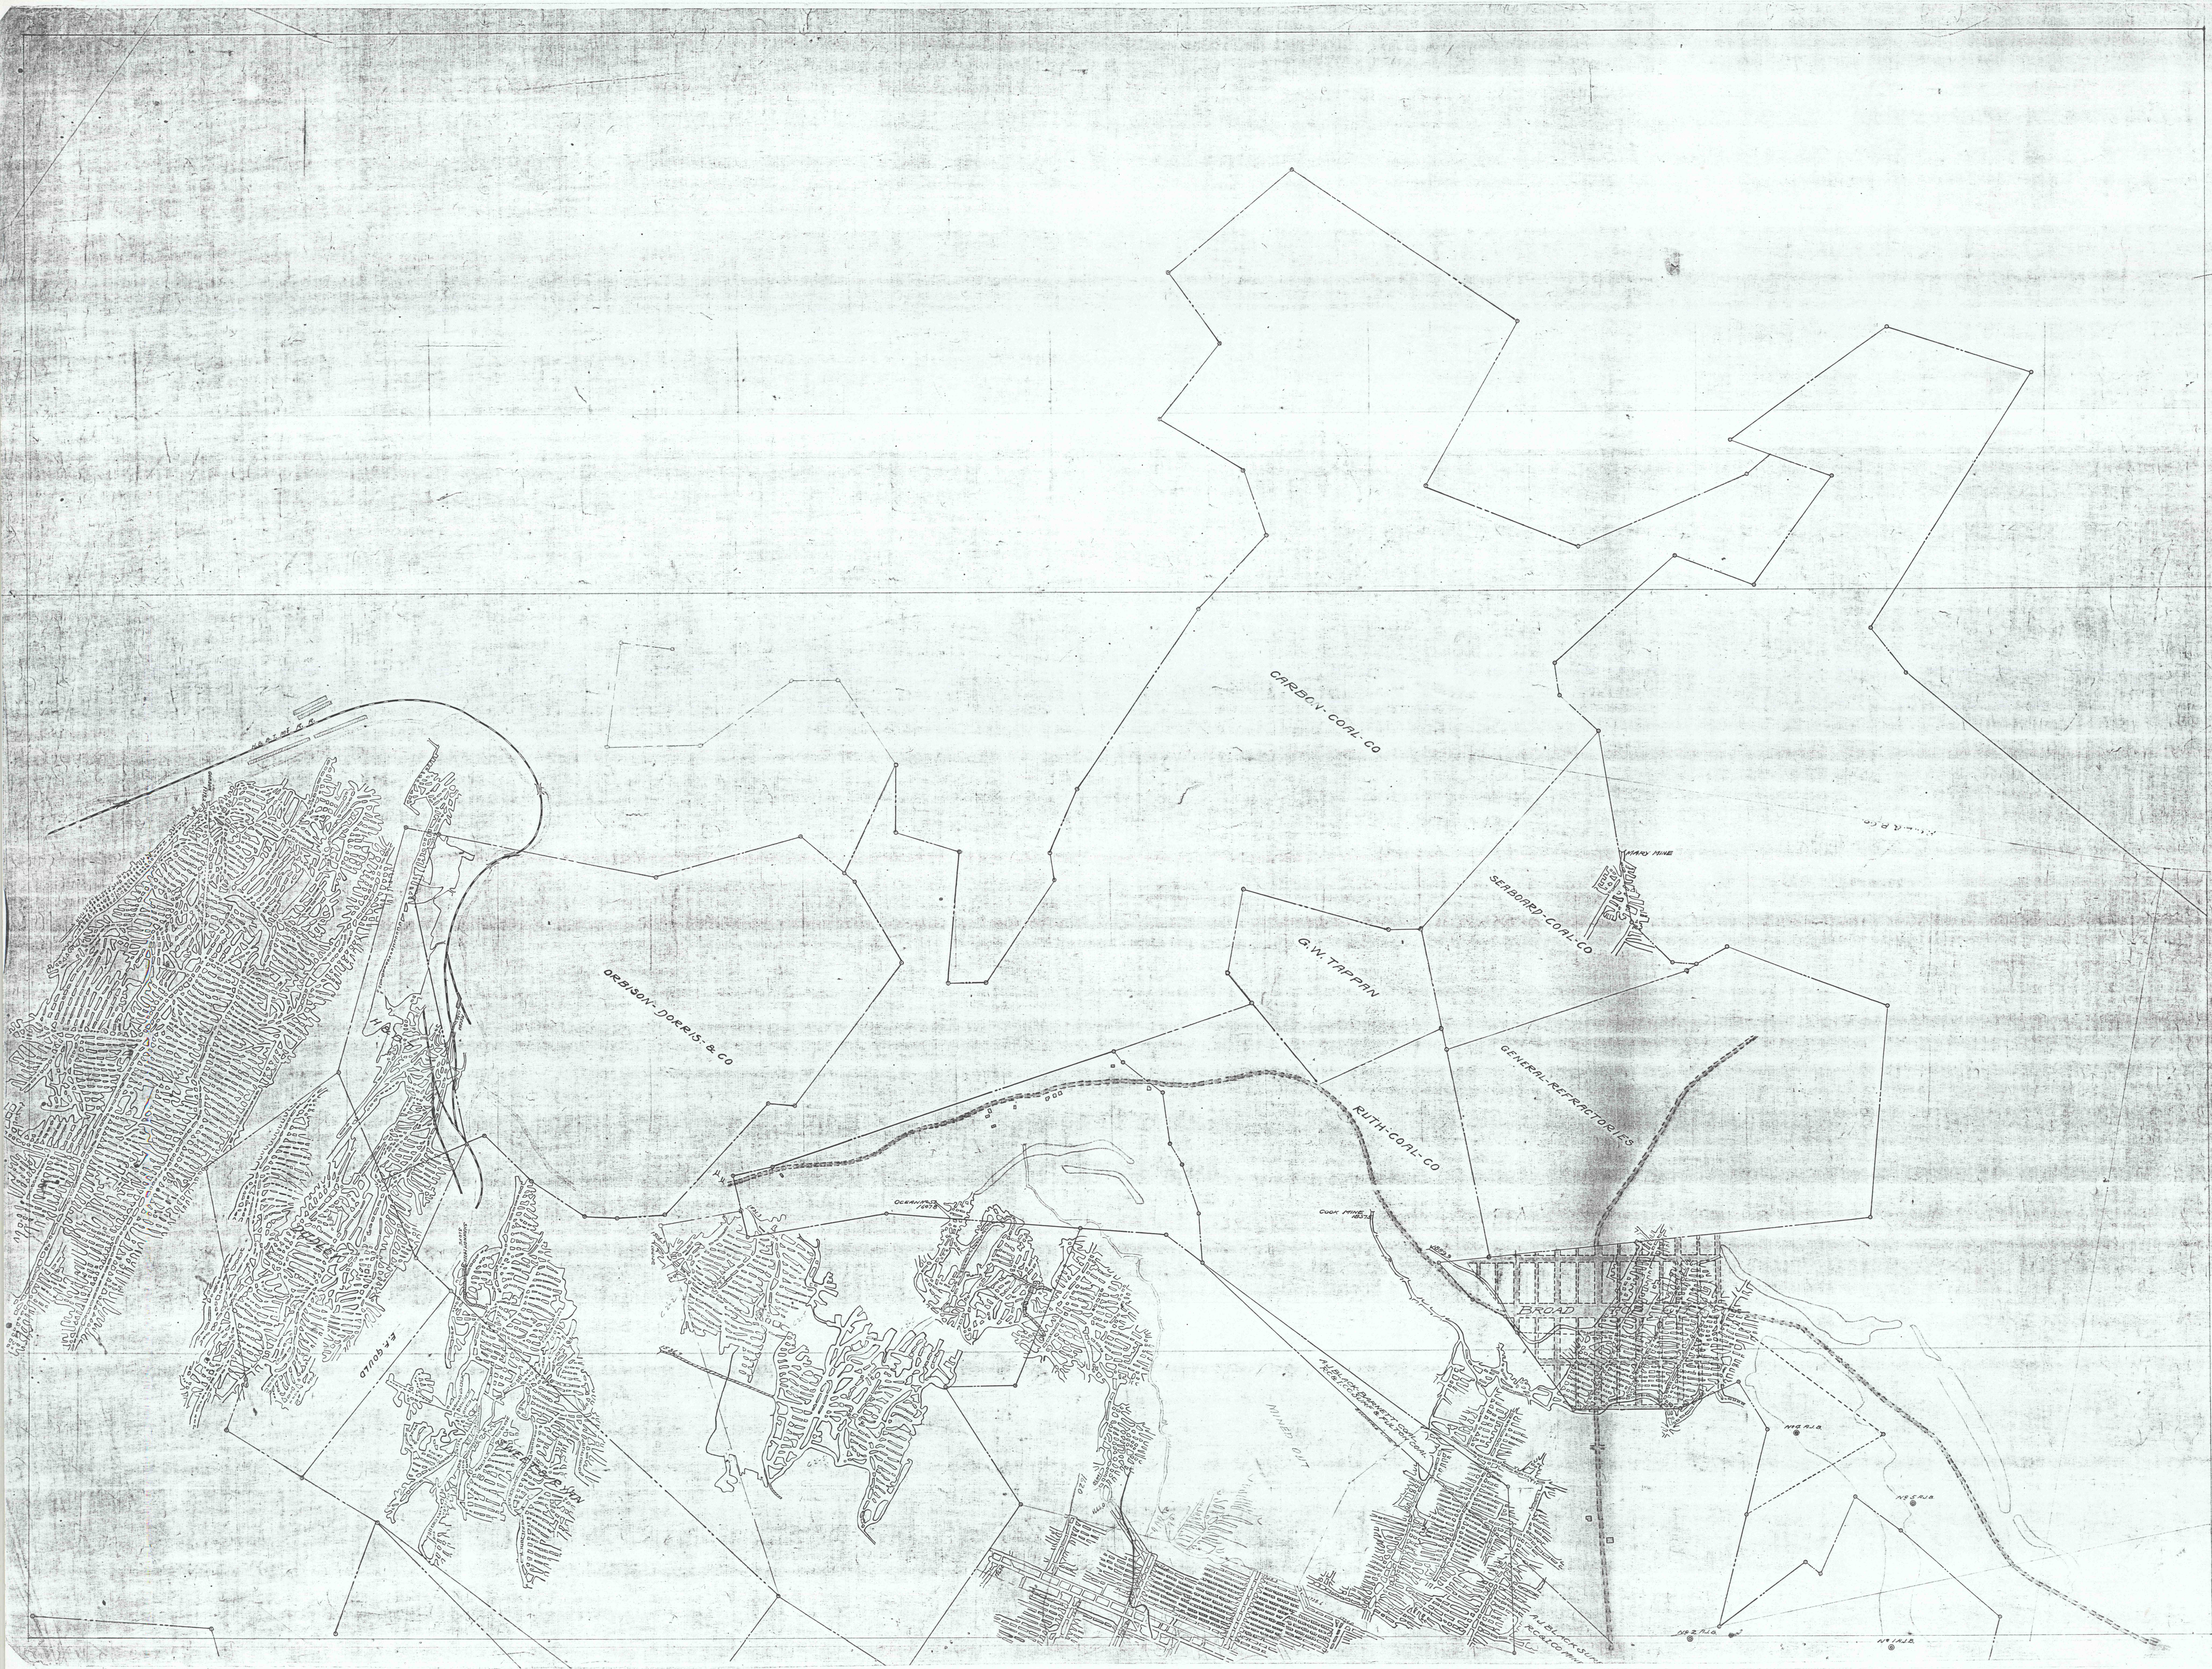
H.B.&T.Mt. R.R.
GORDON 1718.2
ORBISON-DORRIS-&-CO
CARBON-COAL-CO
G.W. TAPPAN
SEABOARD-COAL-CO
MARY MINE
GENERAL-REFRACTORIES
RUTH-COAL-CO
H.&B.T.
DUDLEY
E.F. GOULD
SHEARER & RYAN
SHANNON 1641.0 SLOPE
OCEAN No. 5 1697.8
COOK MINE 1857.5
1889.9
BROAD TOP CITY
MINED OUT
A.J. BLACK-BARNETT COAL
R.C.&I.CO. SURF & FULTON COAL
EXCHANGE LINE
A.J. BLACK SURF
R.C.&I.CO MINE
1620
1728.6
No 4 A.J.B.
No 5 A.J.B.
No 2 A.J.B.
No 1 A.J.B.