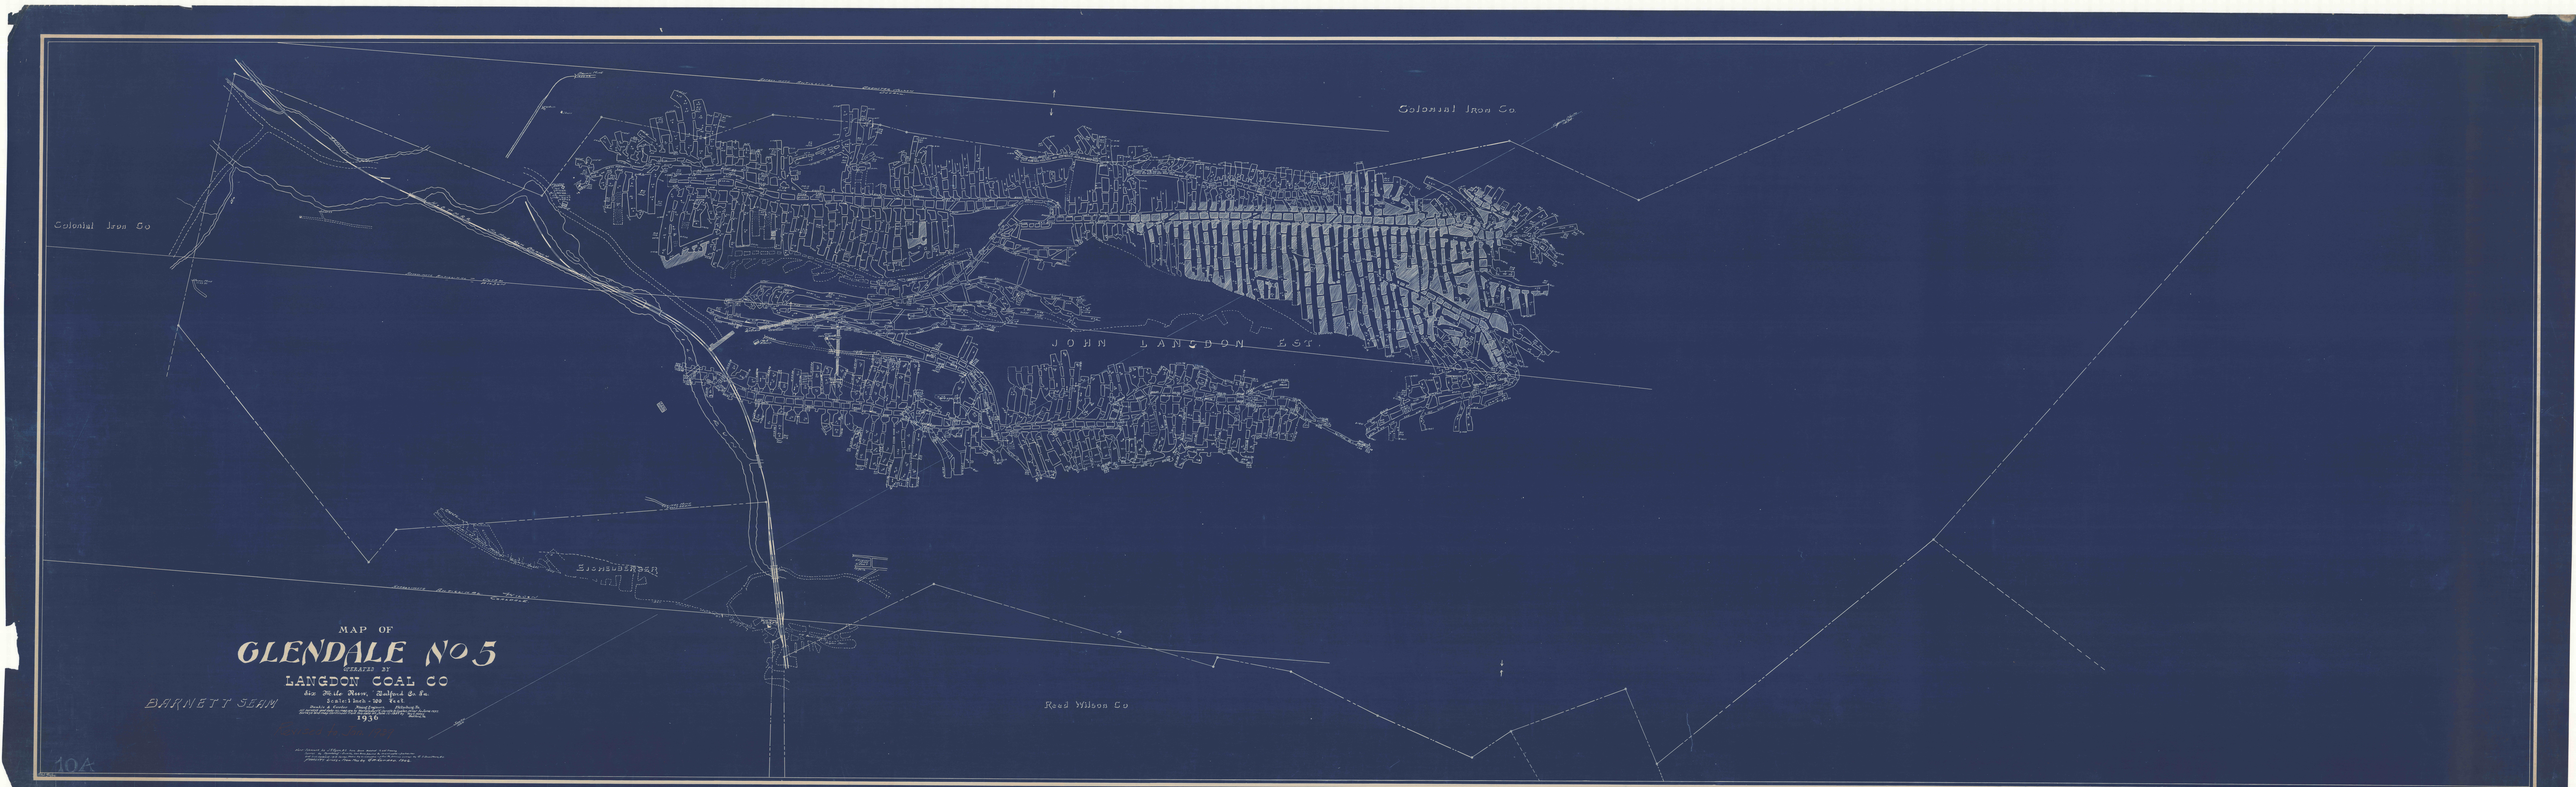

Colonial Iron Co
Colonial Iron Co
JOHN LANGDON EST
Read Wilson Co
MAP OF
GLENDALE No 5
OPERATED BY
LANGDON COAL CO
Scale: 1 Inch = 200 Feet
1936
BARNETT SEAM
10A