


J. H. SIMMONS

CAMBRIDGE SON CO

MAP OF
GLENDALE NO 7
 OPERATED BY
THE LANGDON COAL CO
 Scale: 1 inch = 100 Feet
 Homestead, Dantz & Co. 1911
 Note: All surveys and data prior to Nov. 1928 are by W.O.C.
 1928
 Revised Aug 1935

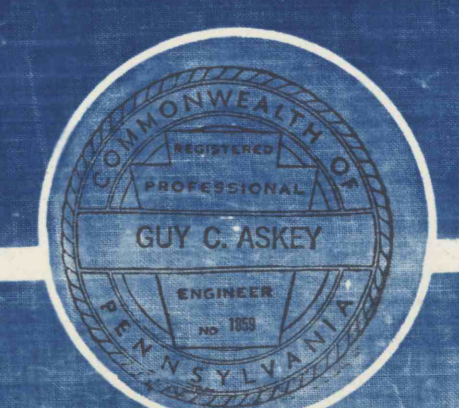

AT 5 531-17A
 531-17A