


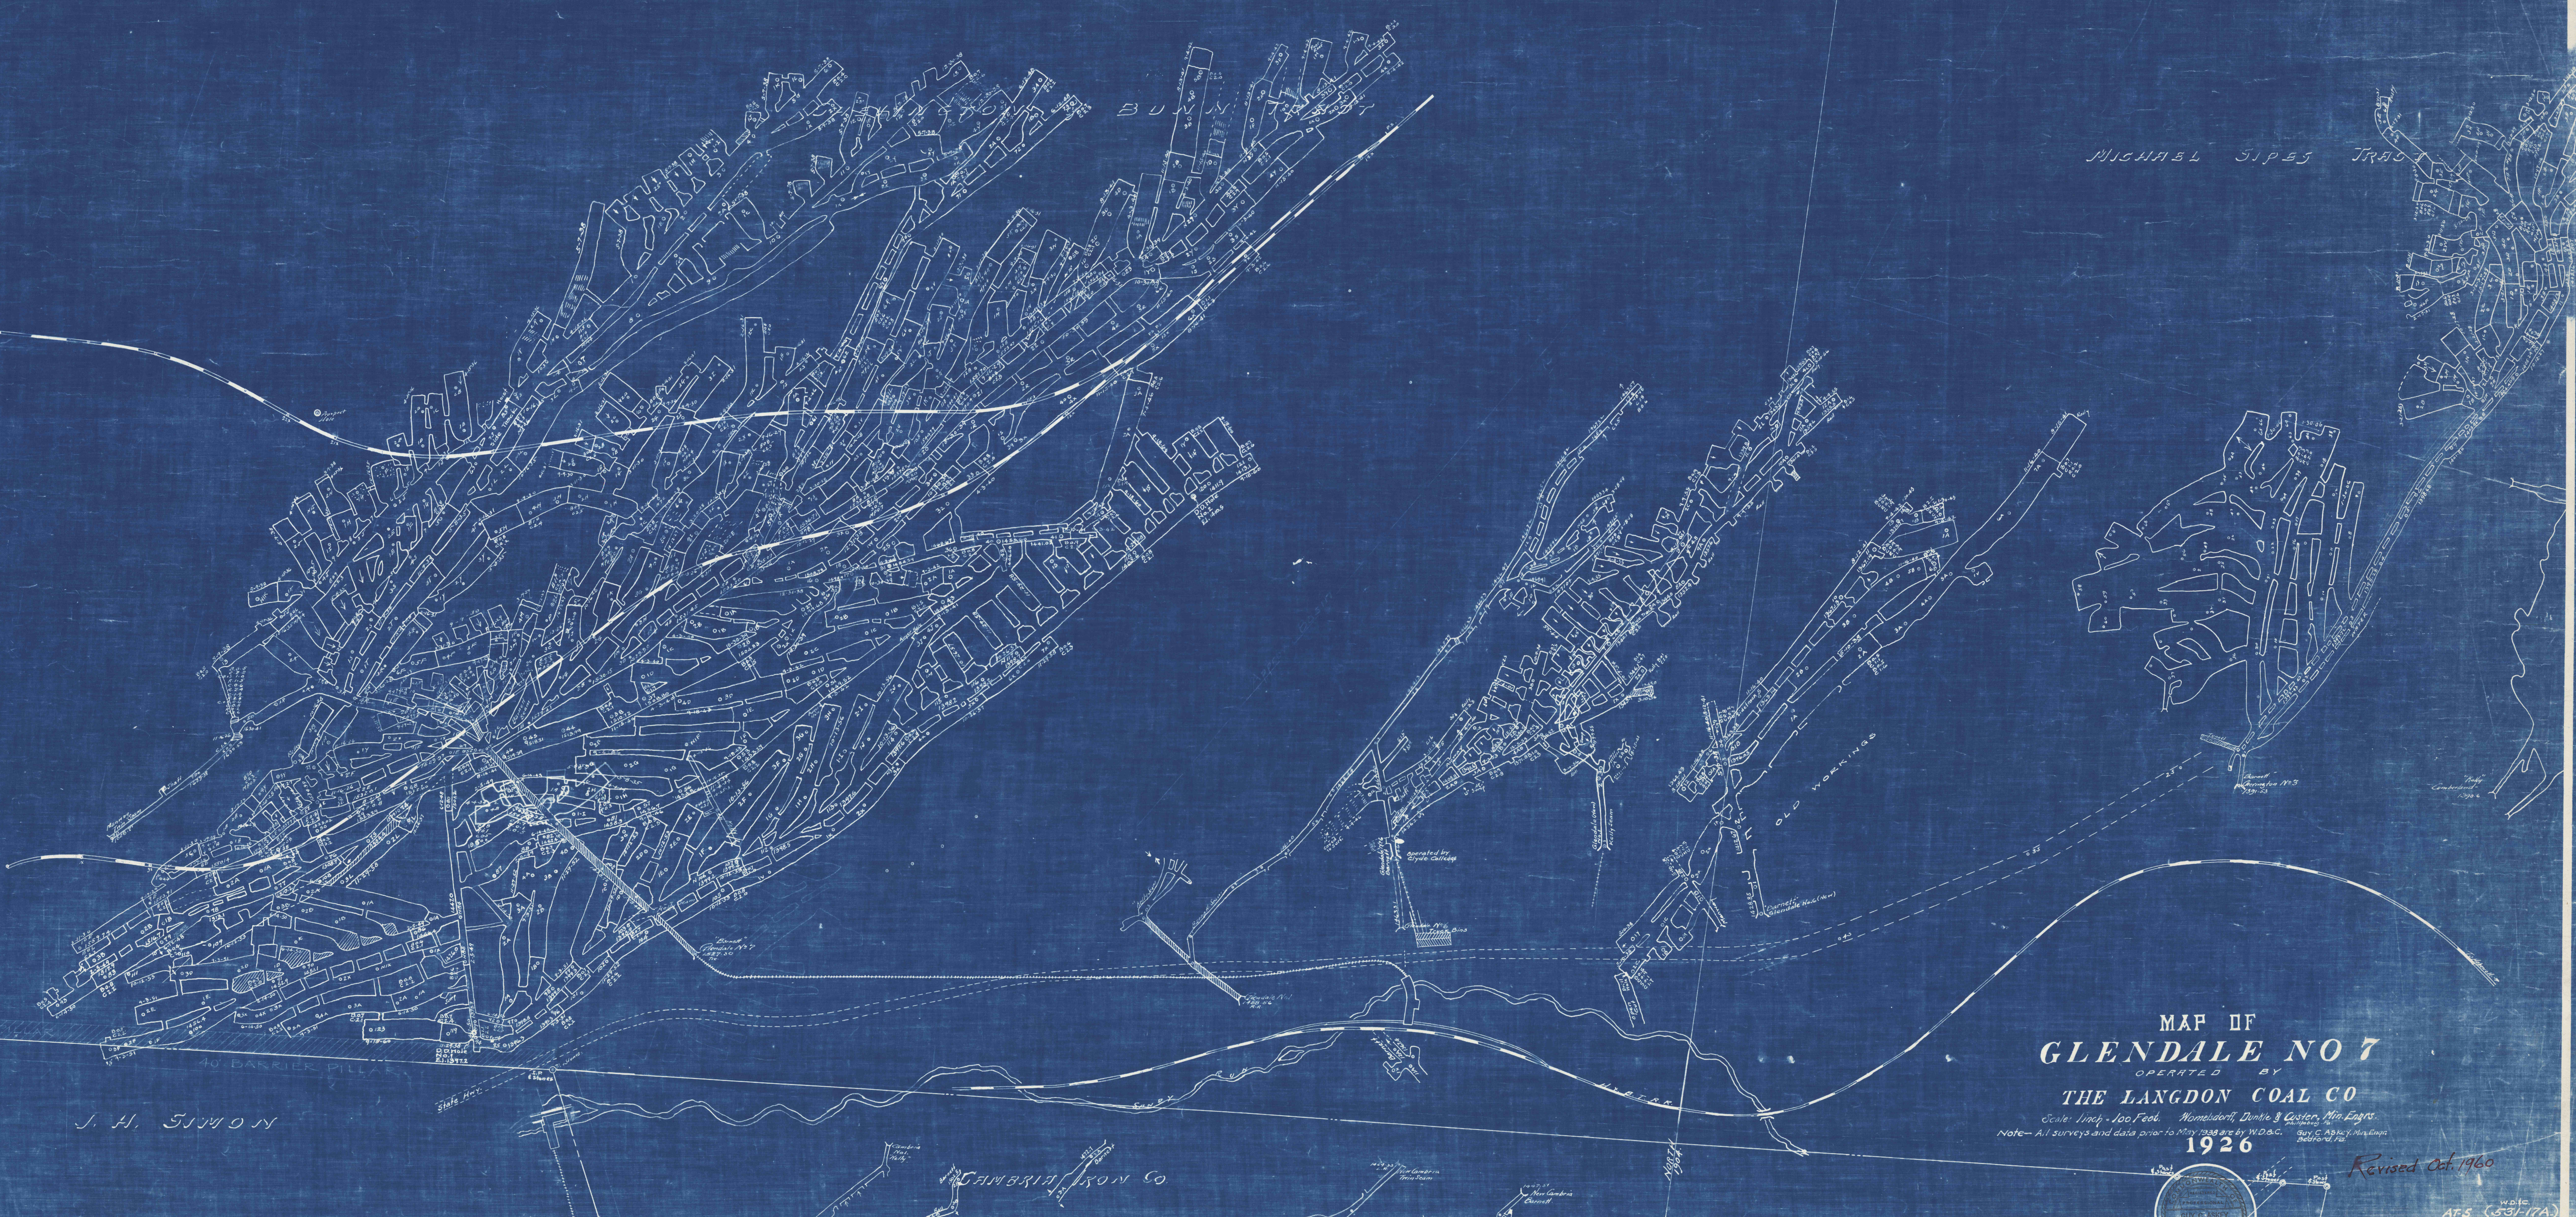

MICHAEL SIPS TRAO

J. H. SIMMONS


MAP OF
GLENDAL NO 7
OPERATED BY
THE LANGDON COAL CO
1926

Revised Oct. 1960



W.D.C. GUY C. APPLEBY
AFS (53/17A)