


Approved by

JOHN LANGDON EST.

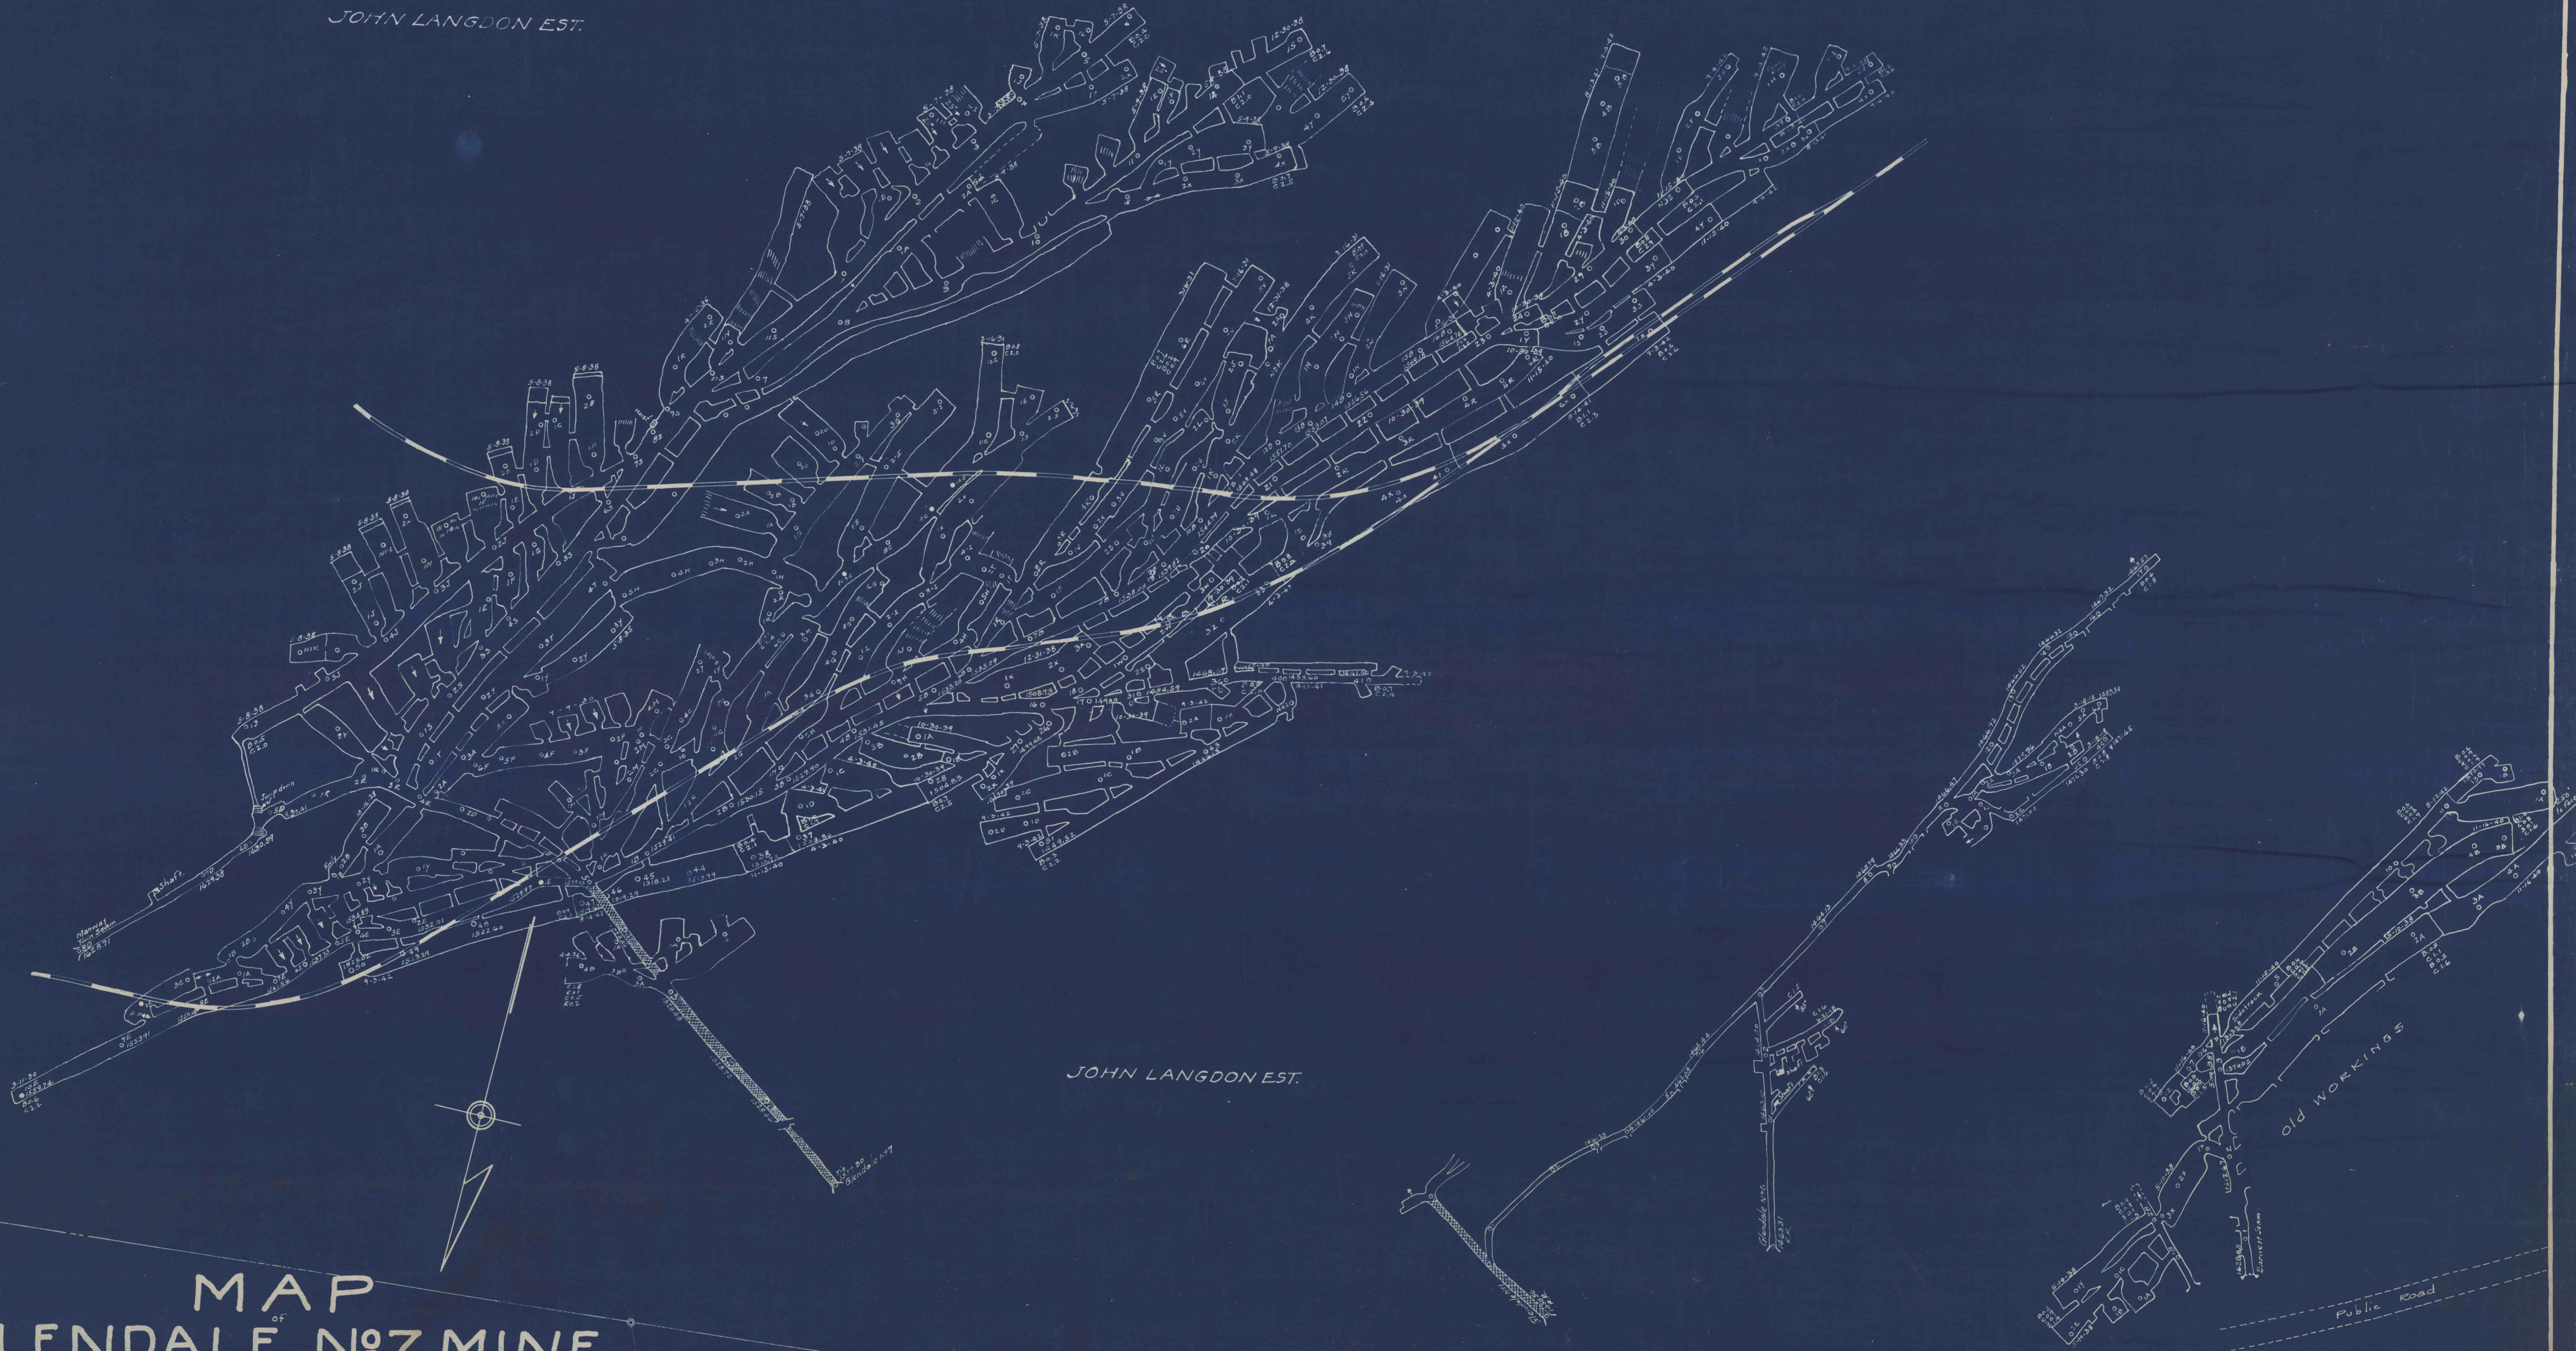

J.H. SIMON

MAP
of
GLENDALE No. 7 MINE

SANDY RUN - BROADTOP TWP. BEDFORD COUNTY
OPERATED BY - RUSSELL ROHM

Scale 1"=100'

BARNETT SEAM

By S. Atkey Bedford, Pa.

Revised 9-3-42

CAMBRIA IRON CO.