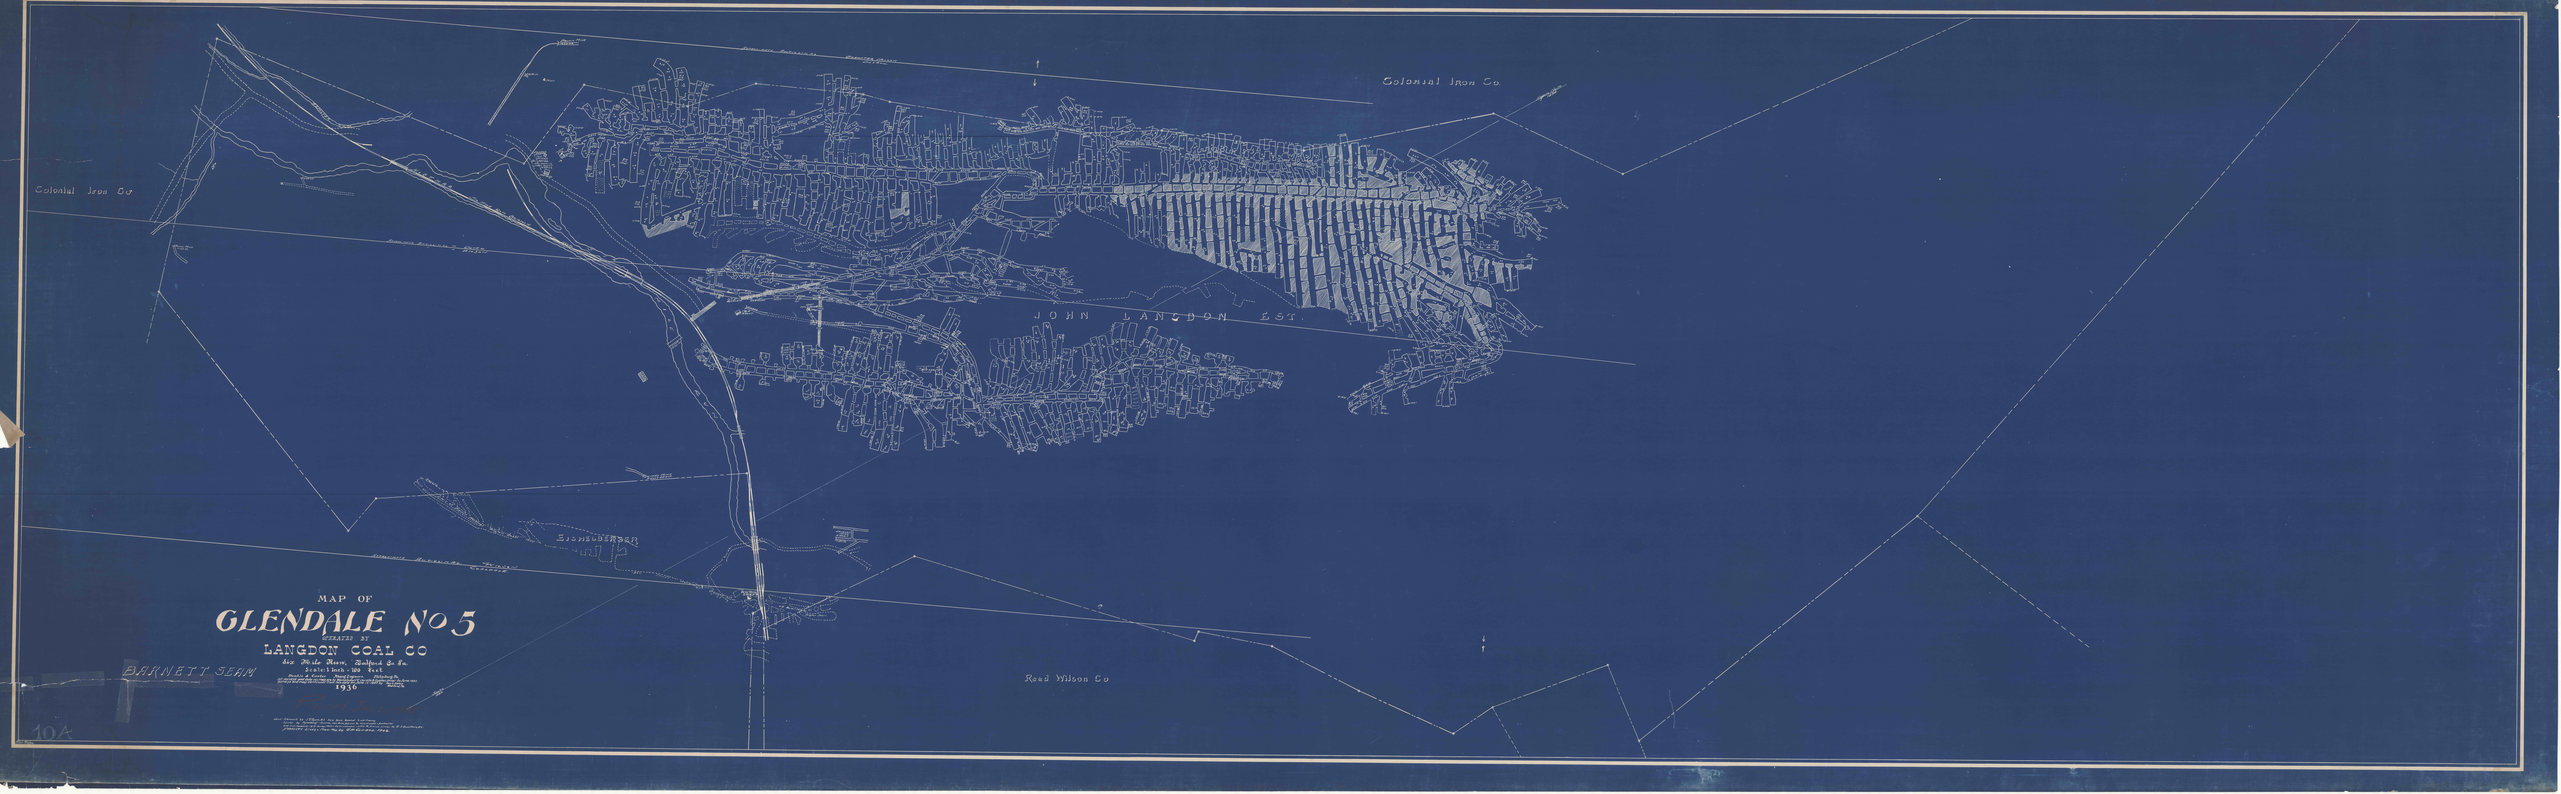
Colonial Iron Co
Colonial Iron Co
JOHN LANGDON EST.
EISENBERGER
Read Wilson Co
MAP OF
GLENDALE No 5
OPERATED BY
LANGDON COAL CO
BARNETT SEAM
1936
10A