



JOHN LANGDON EST.

MARTIN MARIETTA CO.


MICHAEL Sipes
JOHN LANGDON EST.
22.01 AC.

J. H. SIMMONS

CAMBRIA SIMMONS CO

MAP OF
GLENDALE NO 7
OPERATED BY
THE LANGDON COAL CO
Scale: 1 inch = 100 Feet. Meridians, Dents & Cuts, Min. Lines.
1926

Revised
Sept. 1945

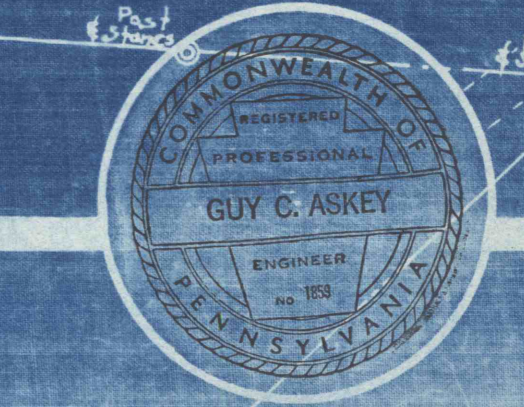

W.D.C. (53172)