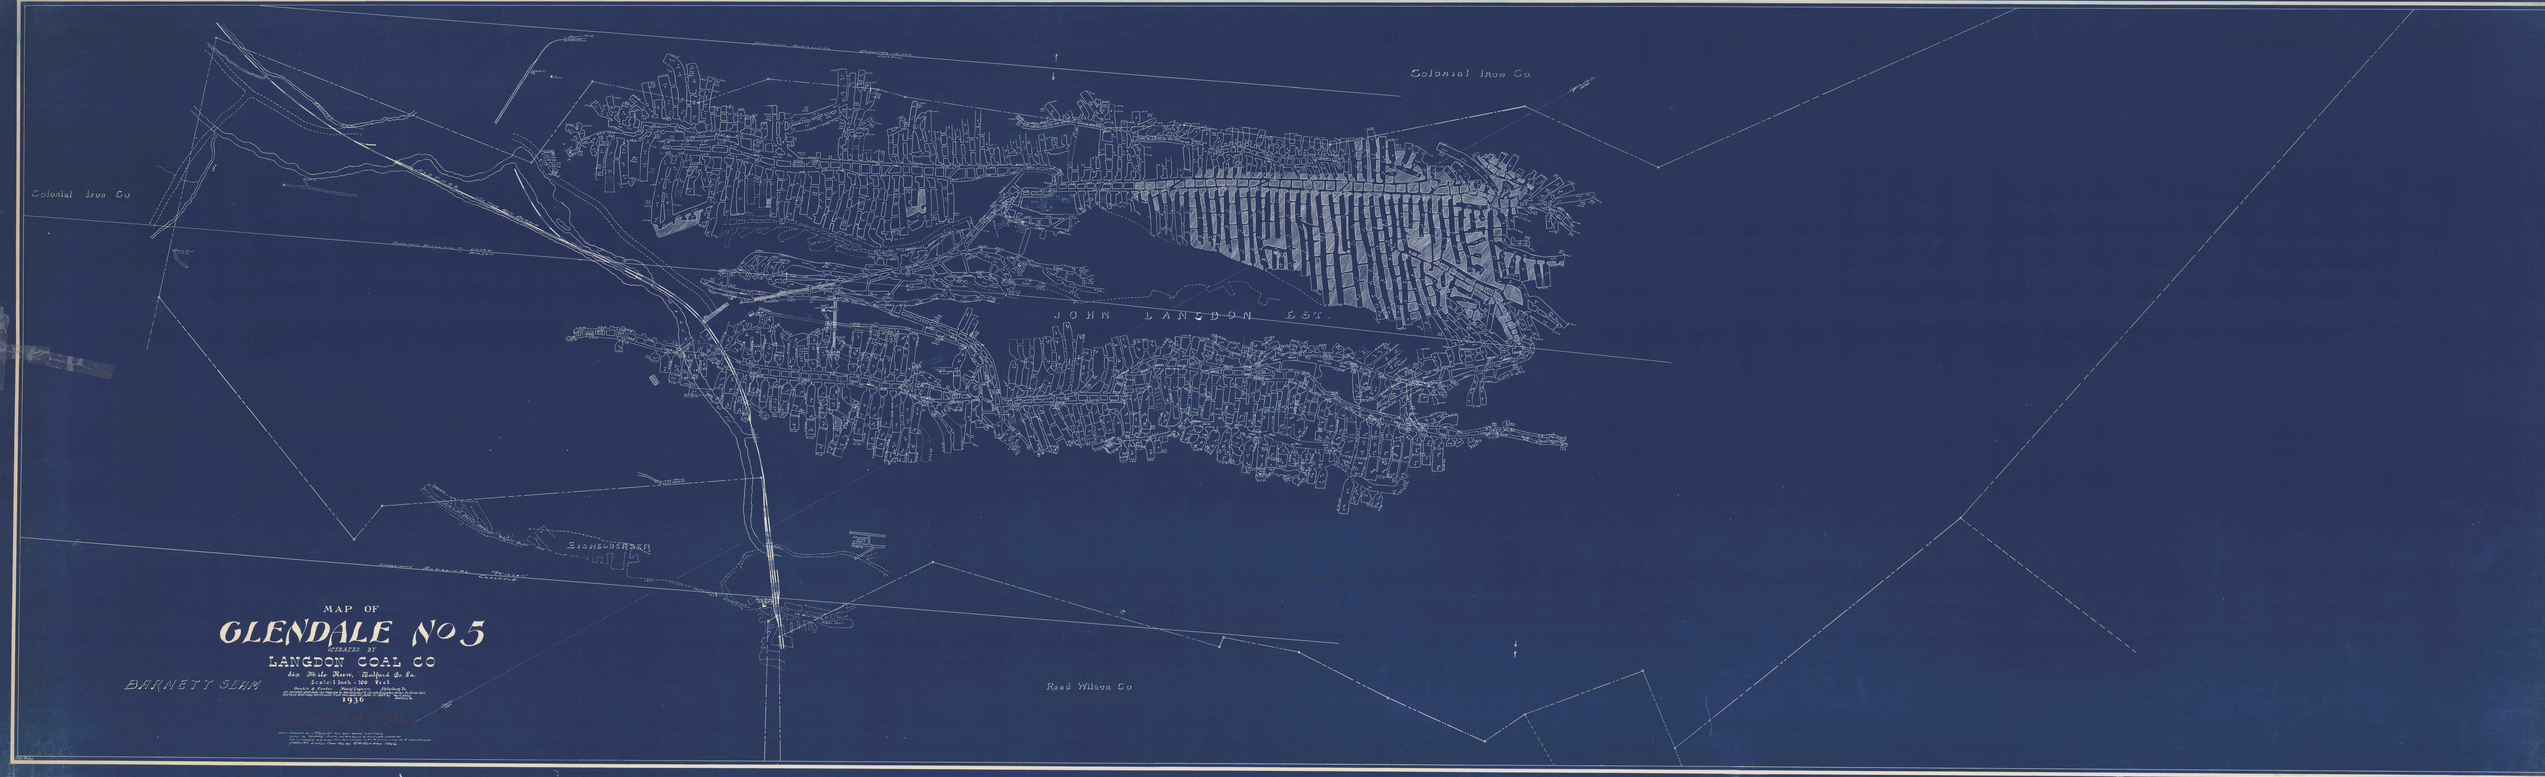
Colonial Iron Co
Colonial Iron Co
JOHN LANGDON EST.
EISENBERGER
Reed Wilson Co
MAP OF
GLENDALE No 5
OPERATED BY
LANGDON COAL CO
Geo. Mc. Nave, Railroad & Mc.
Scale: 1 Inch = 100 Feet
1936
BARNETT SEAM