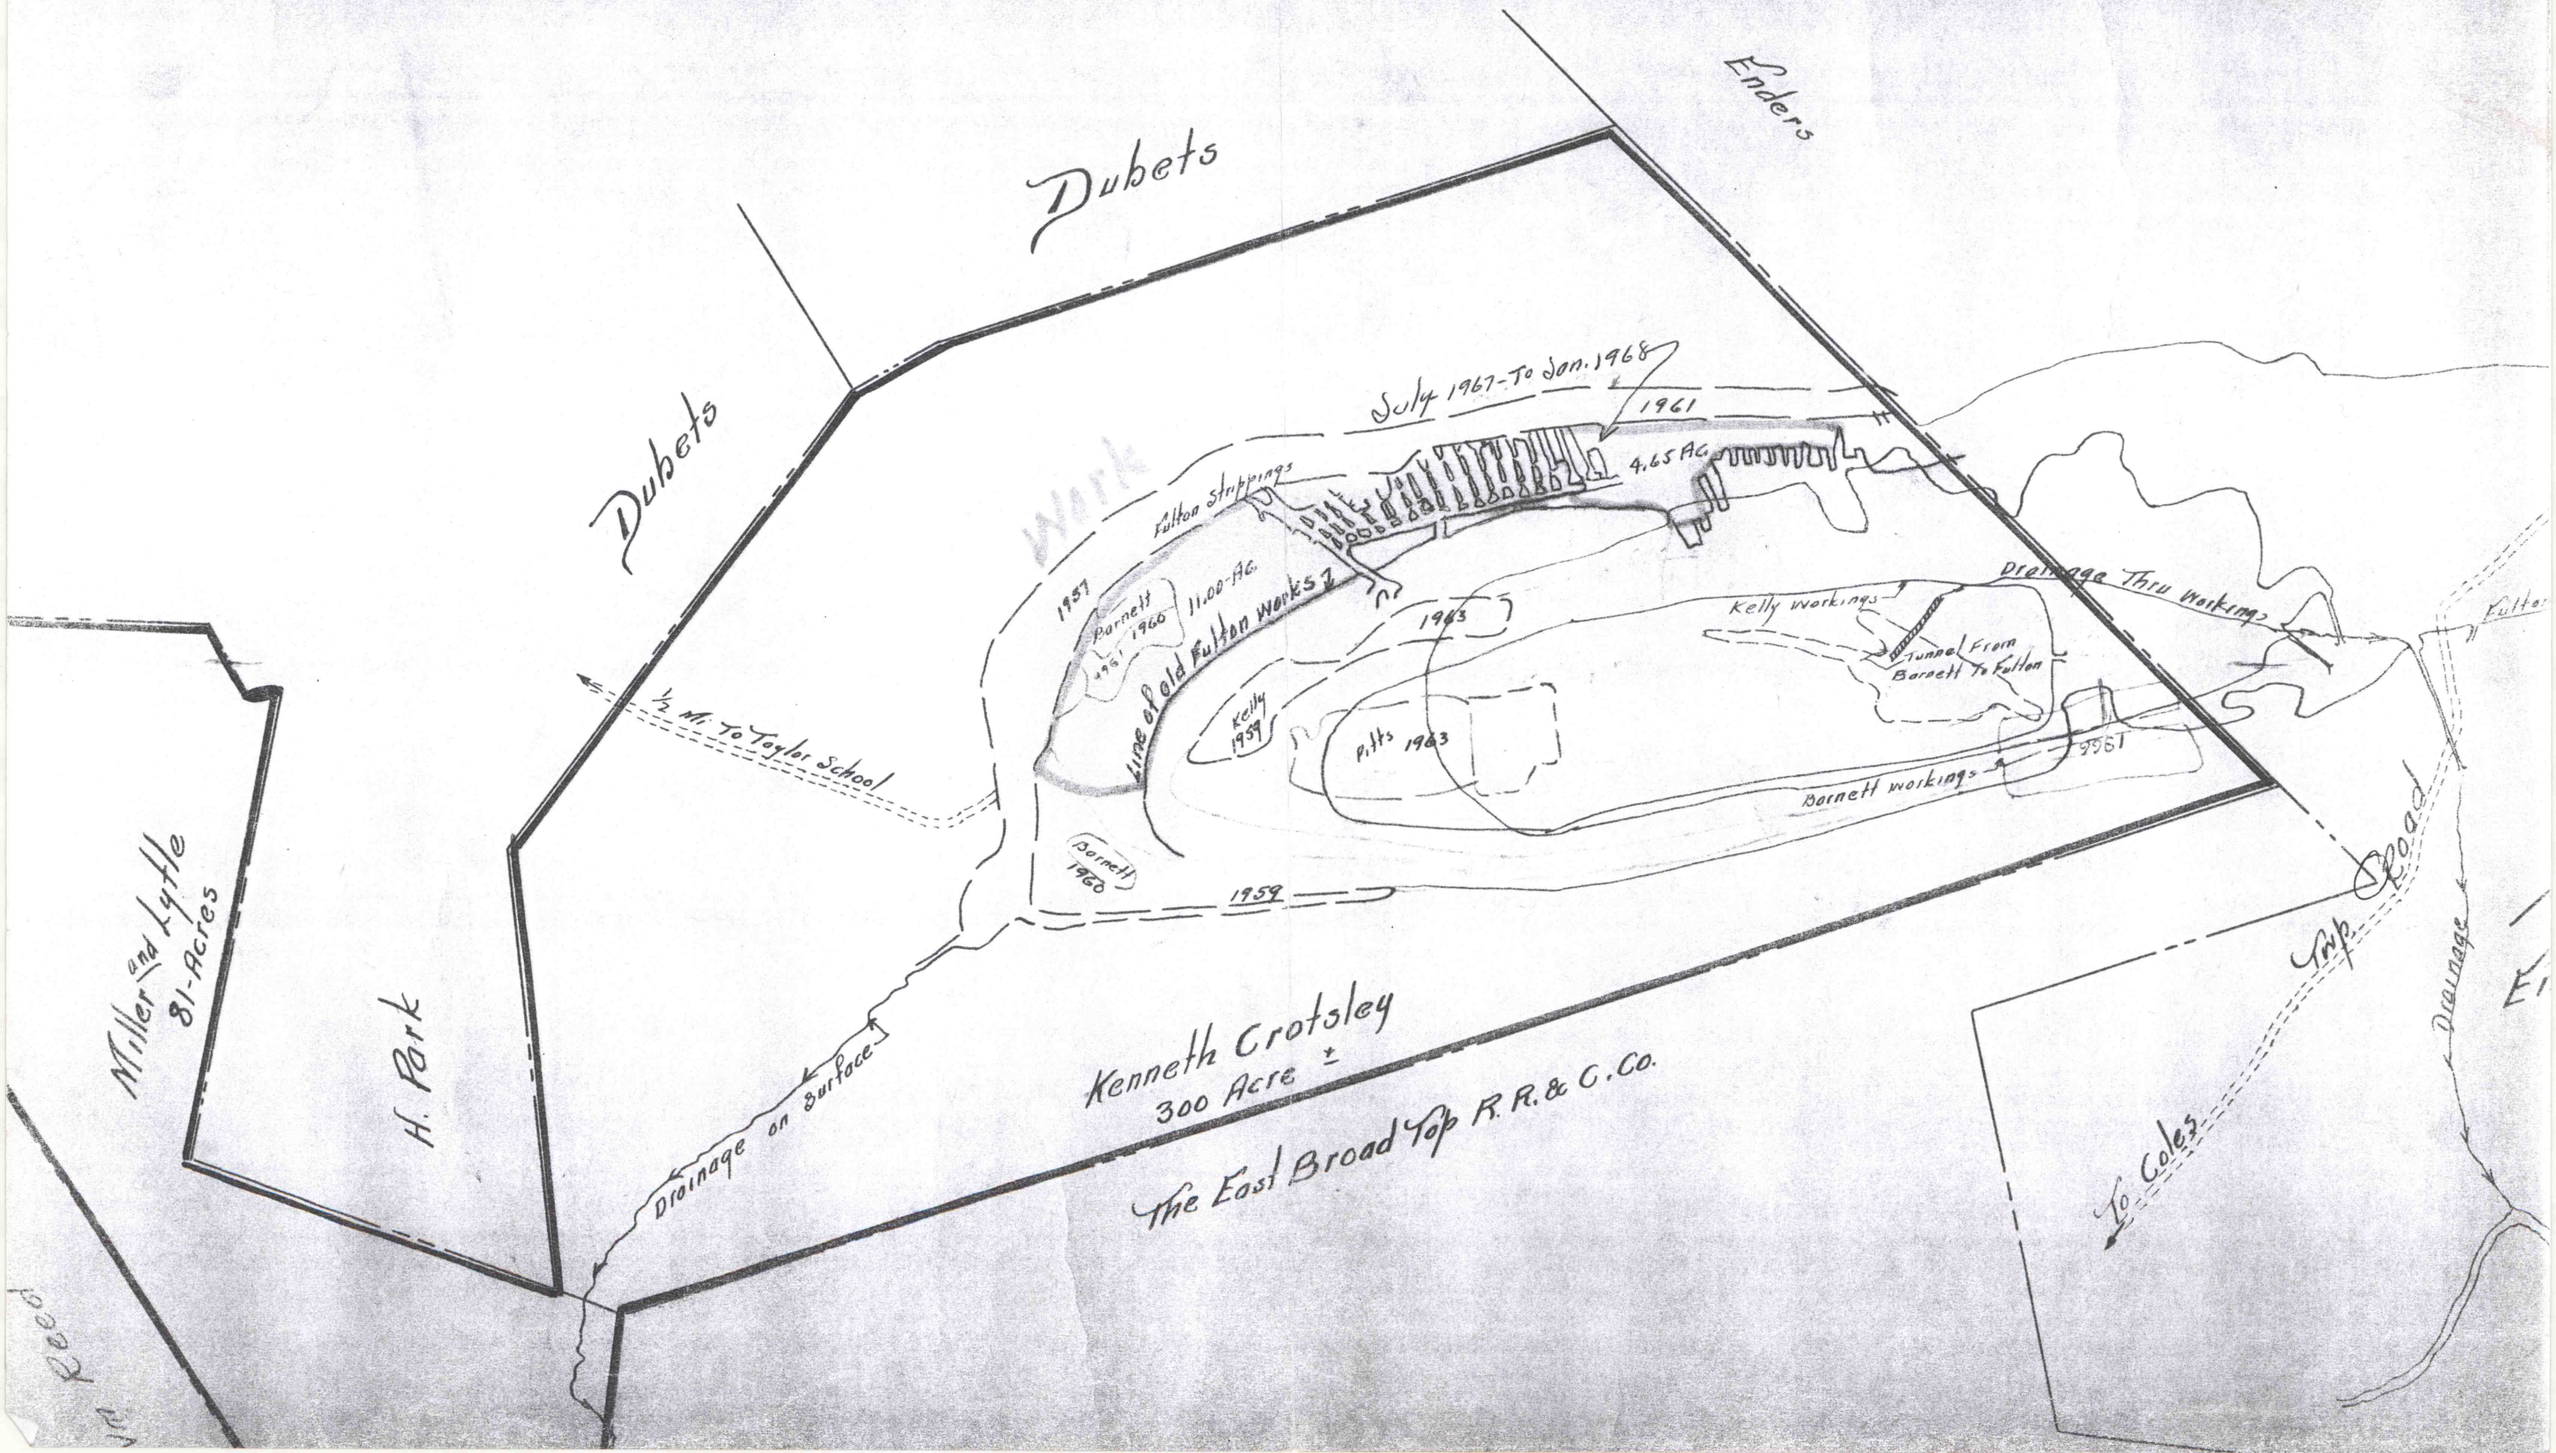

Enders
Dubets
Dubets
July 1967-To Jan. 1968
1961
4.65 AC.
Work
Fulton Strippings
1957
Barnett 1960
11.00-AC.
Line of old Fulton Works
1963
Kelly workings
Drainage Thru Workings
Tunnel From Barnett To Fulton
Kelly 1959
Pitts 1963
1961
Barnett workings
Barnett 1960
1959
½ Mi. To Taylor School
Miller and Lytle 81-Acres
H. Park
Drainage on Surface
Kenneth Crotsley 300 Acre ±
The East Broad Top R.R. & C. Co.
Twp. Road
Drainage
To Coles