


1000.
950
900
850
800

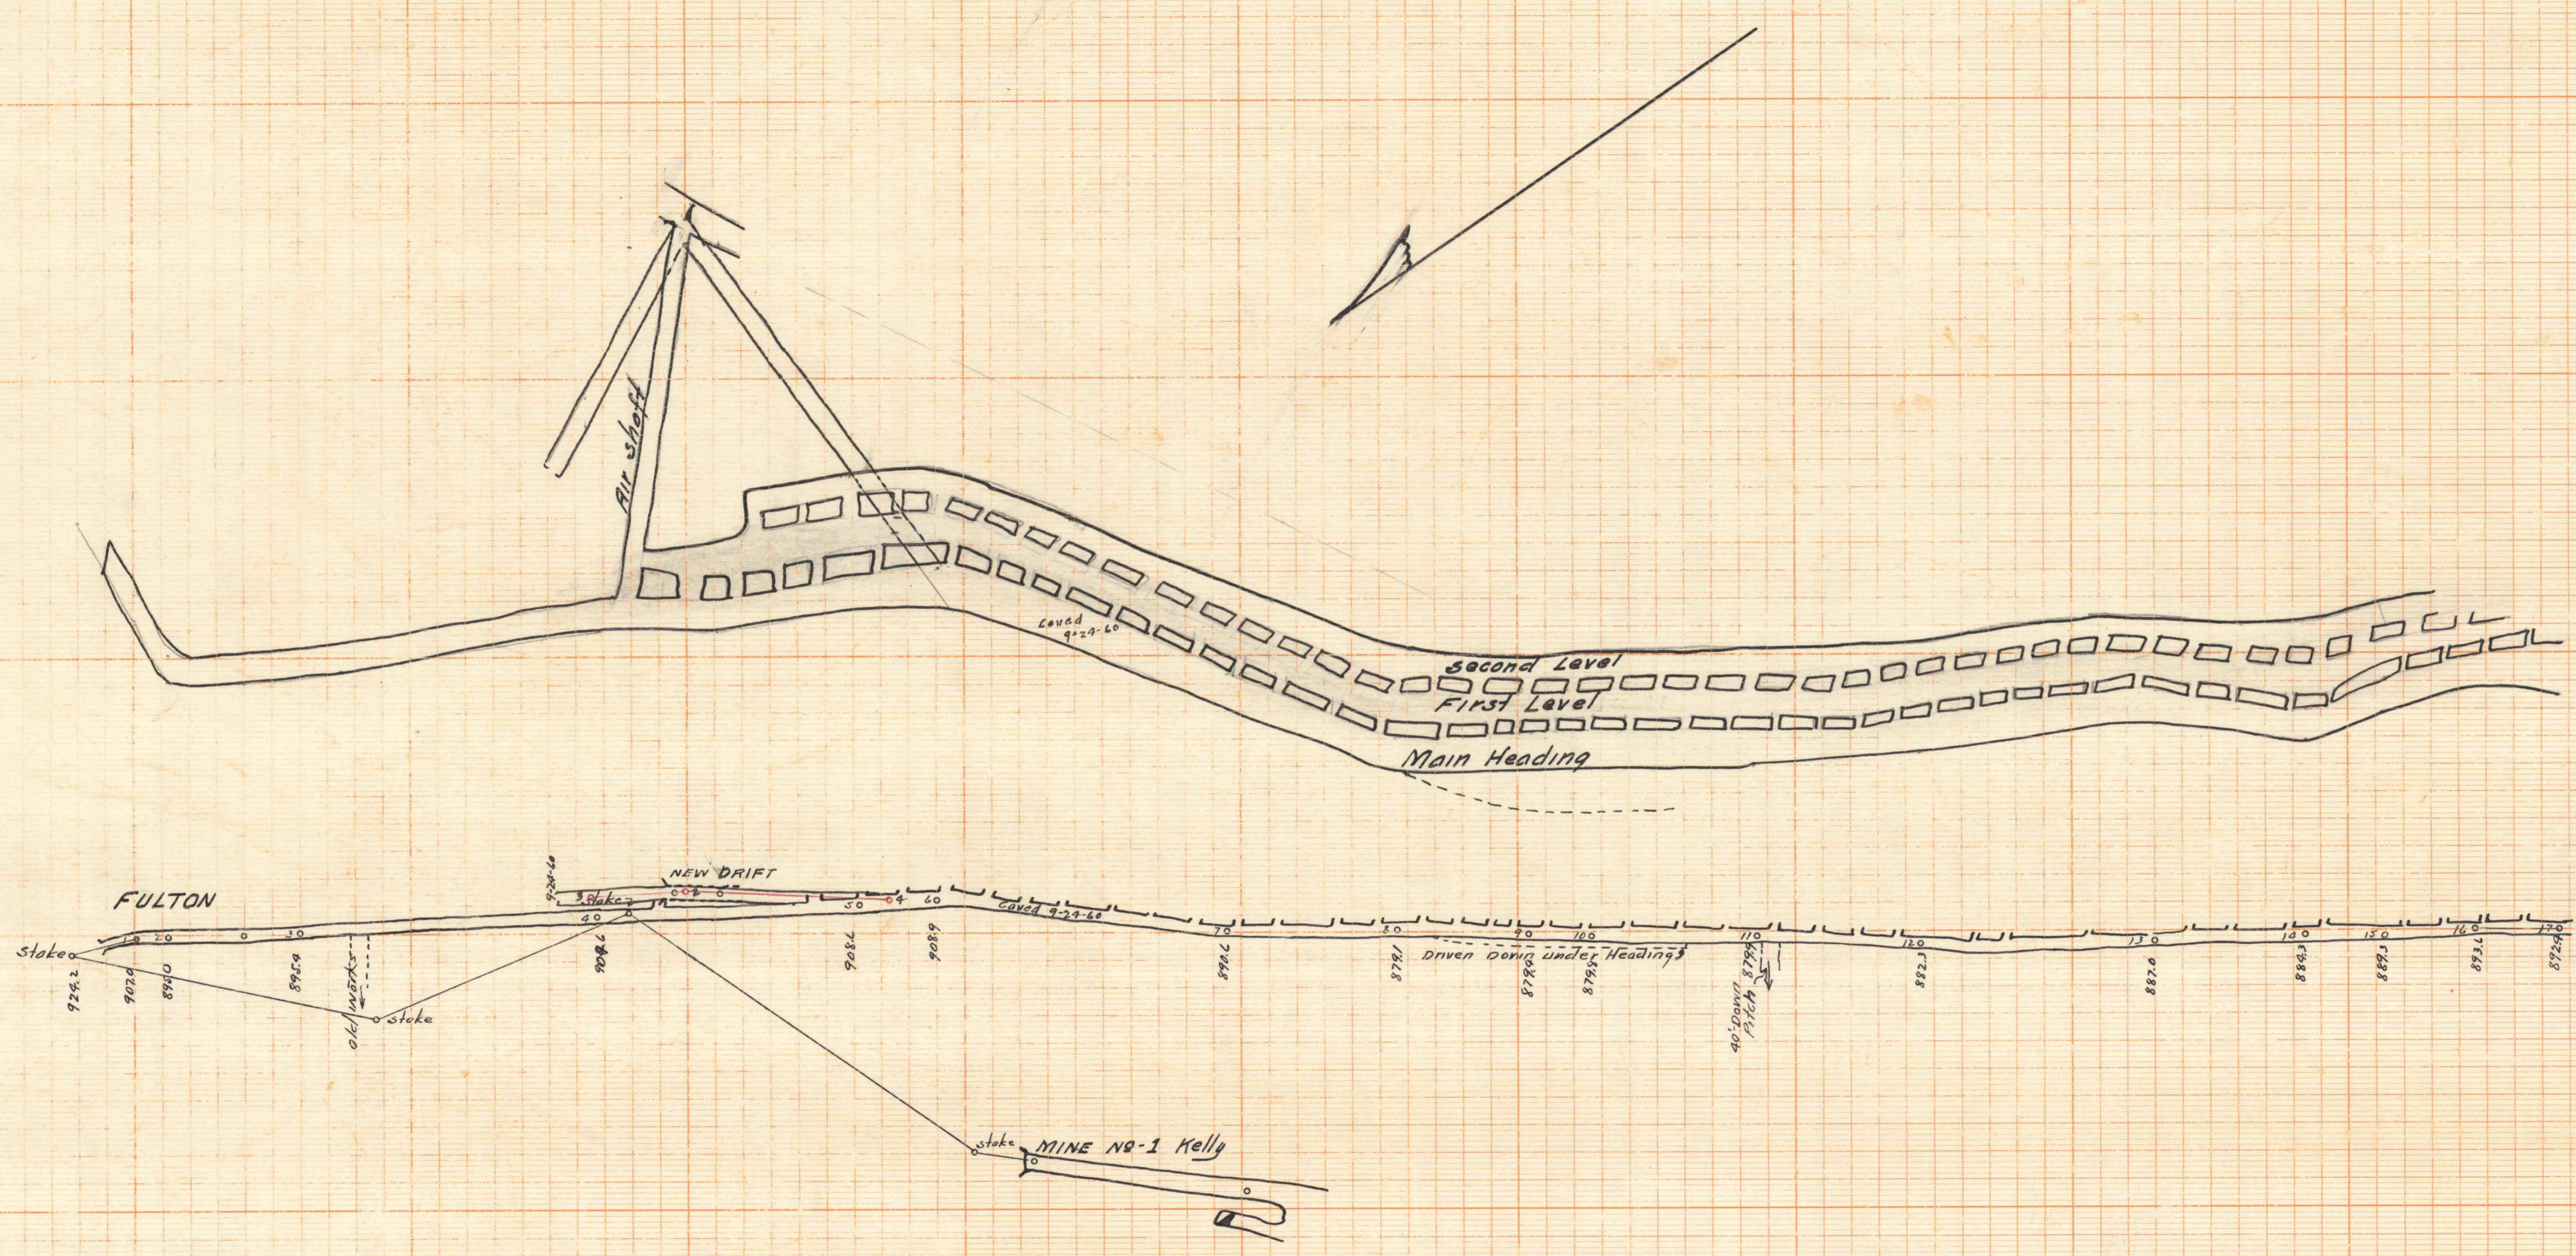

CHAS. CROTSLEY
MINE MAP
 MINE NO 2 FULTON
 Rocky Ridge, Todd Twp. Hunt Co. Pa.
 Scale 1"=100' Horiz. 1"=20' Vert.
 March 1st 1893 E. Corrie Engr.

4400
4300
4200
4100
4000
3900
3800
3700