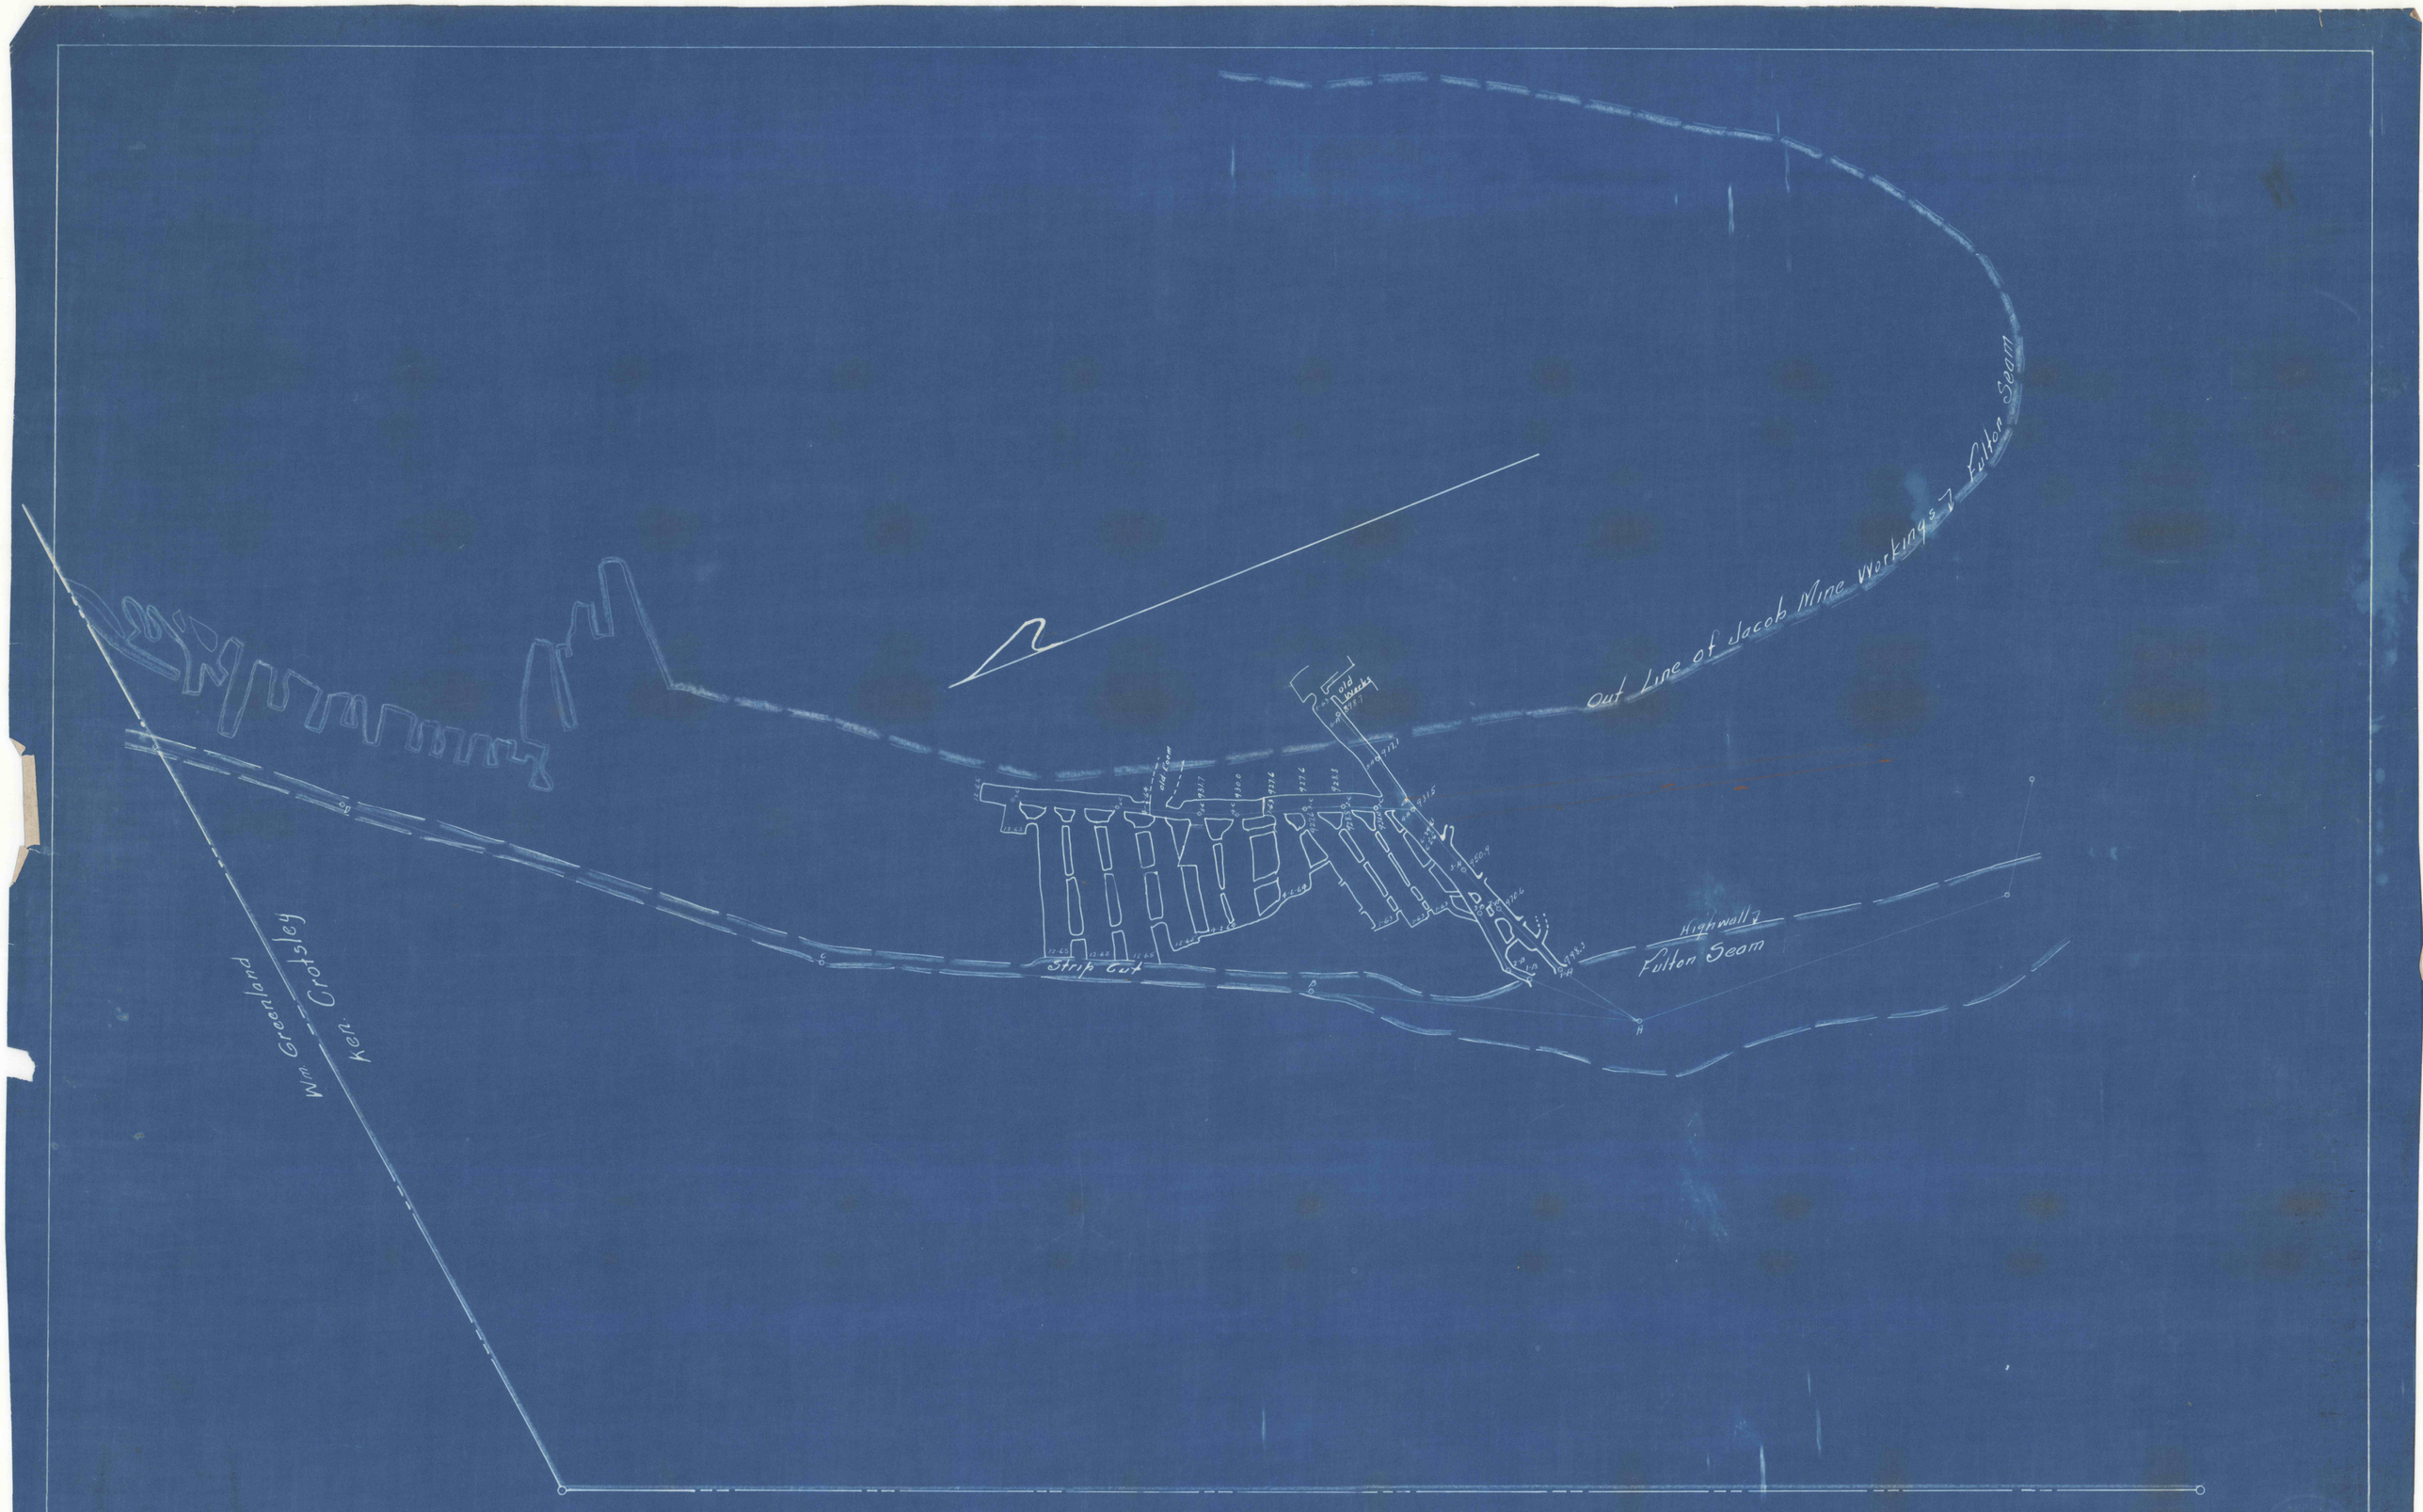

Map Showing Deep Mine Under Highwall Operated By Ken. Crotsley In Todd Twp. Huntingdon County Pennsylvania 1961-July 1"=100' E. Corrie Engr.