


Rockhill Coal Company

William Greenland

Chas. Crottsley & Son.

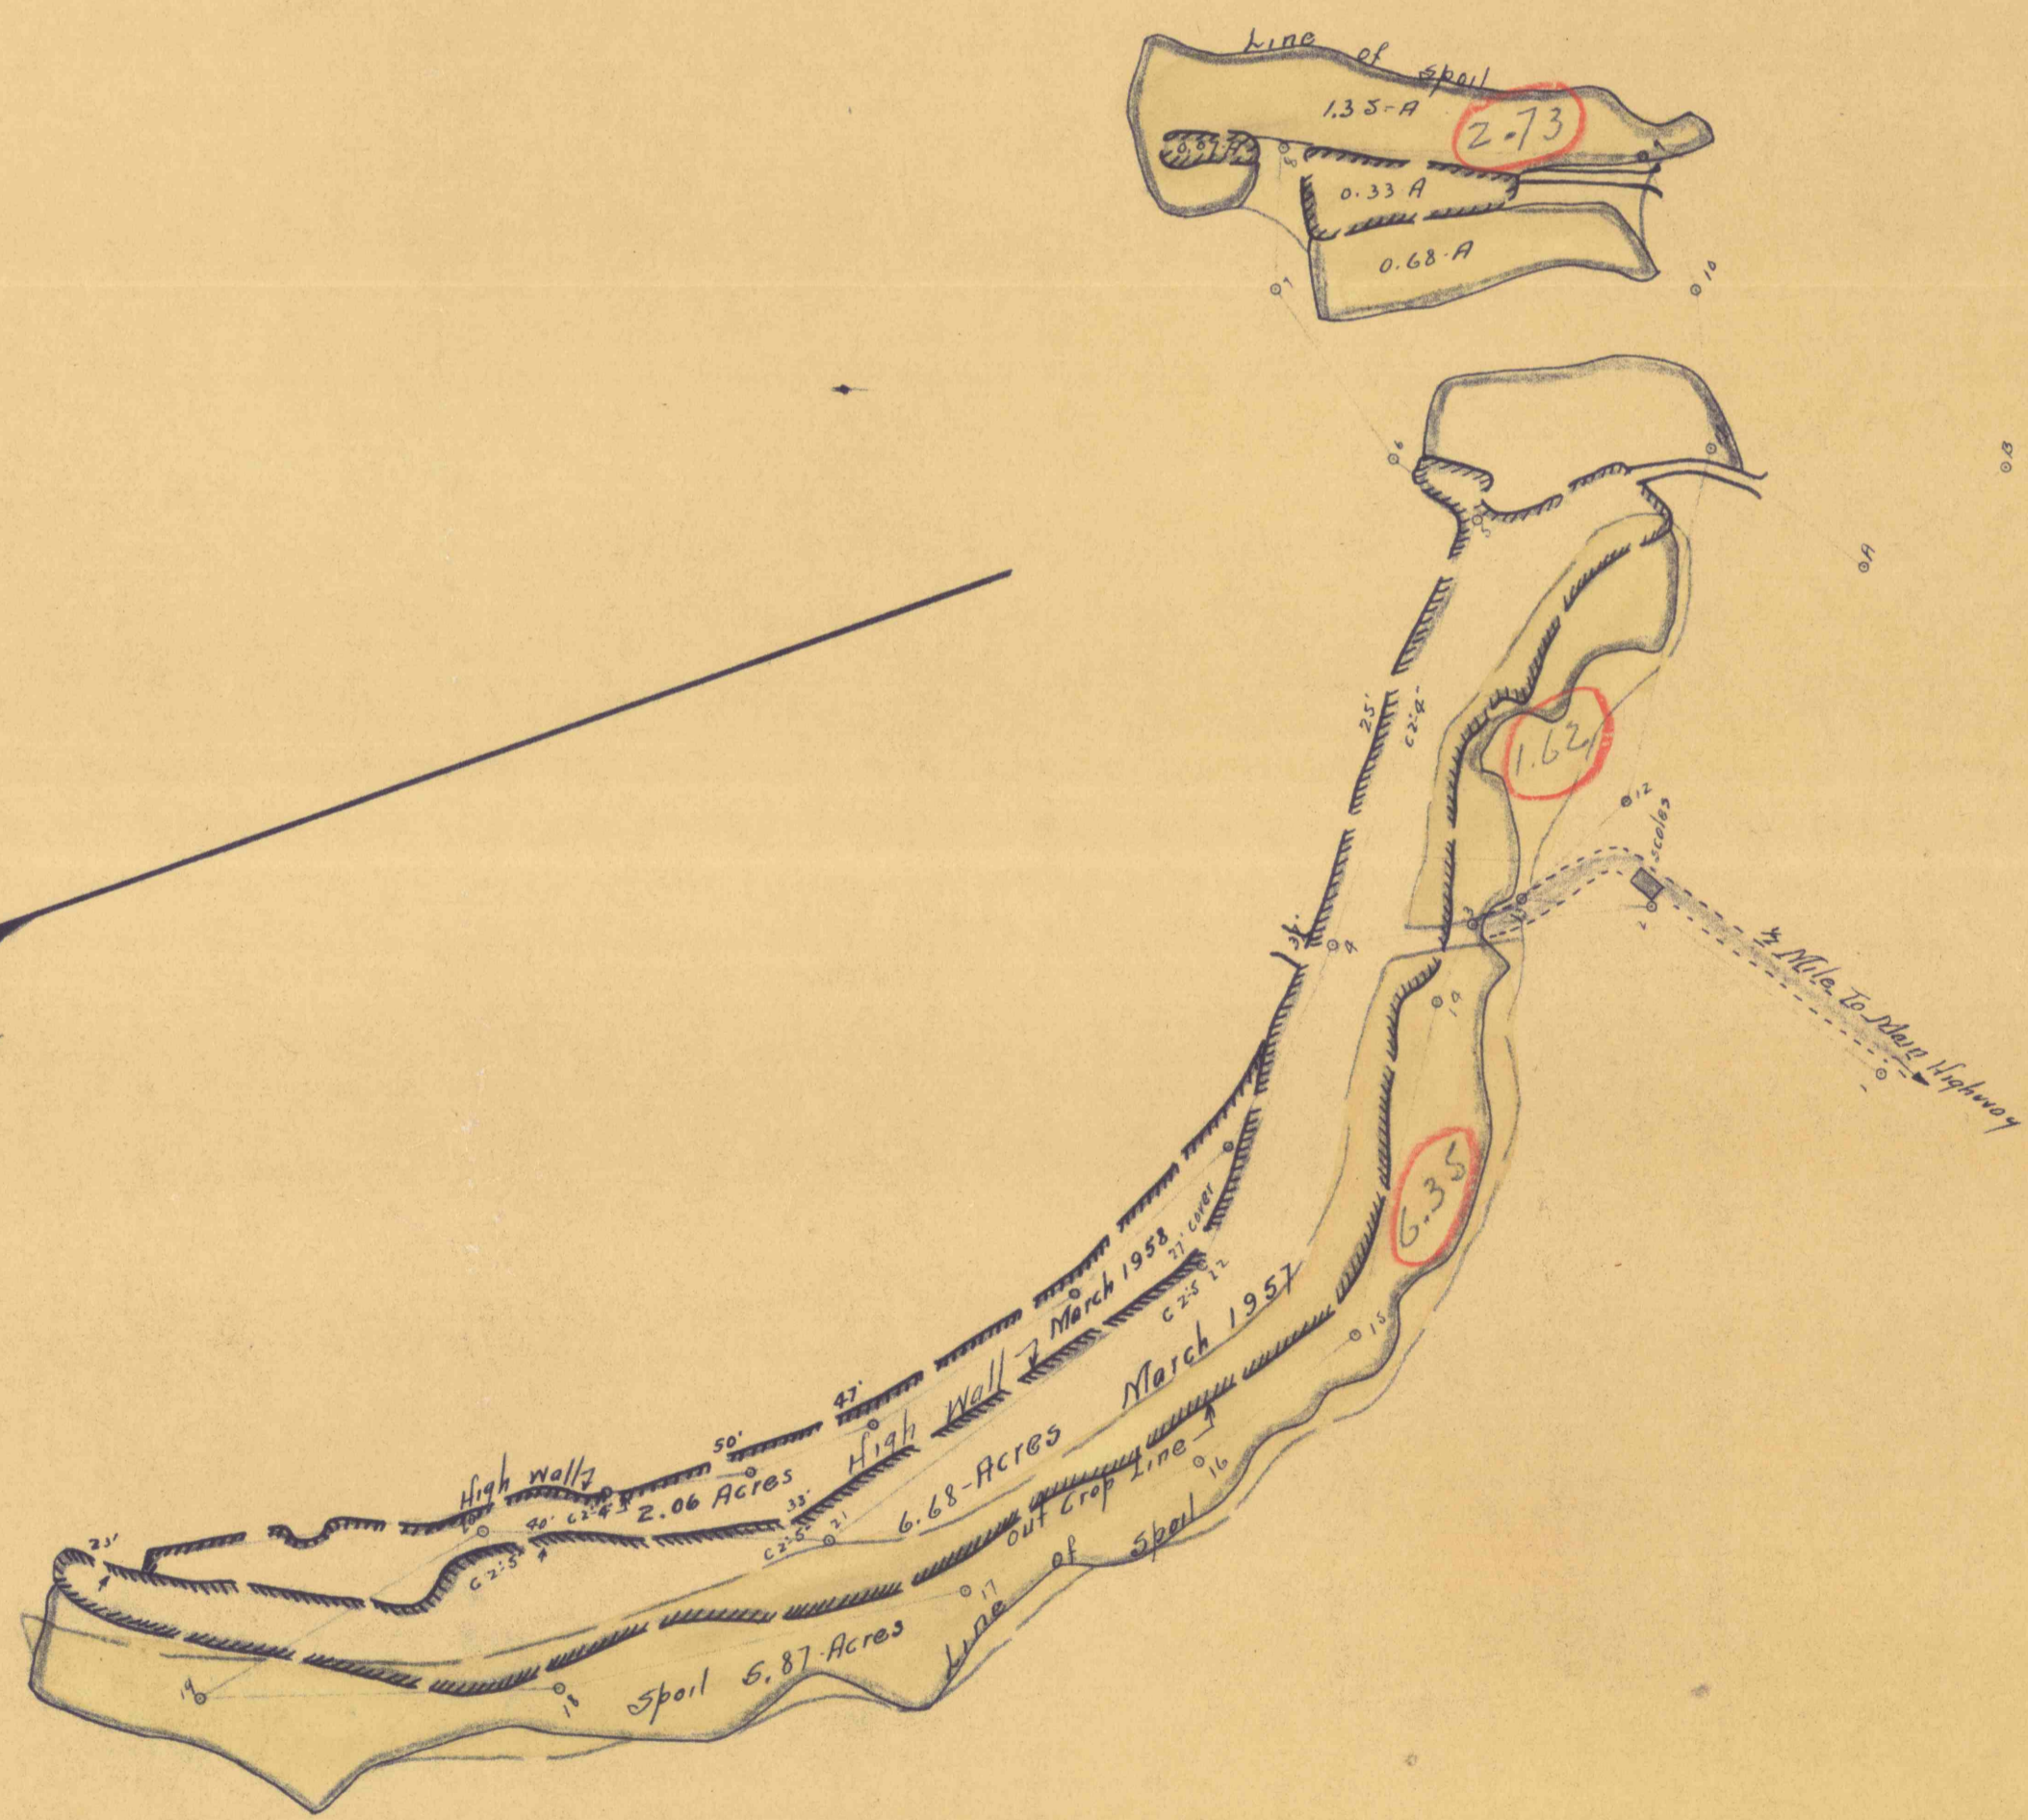

Map Showing 10.70 Acres Backfilled By Ken Crottsley in Todd Twp Huntingdon County Penna. July 1958 1"=200' E. Corrie