


Rockhill Coal Company

William Greenland

Crotsley

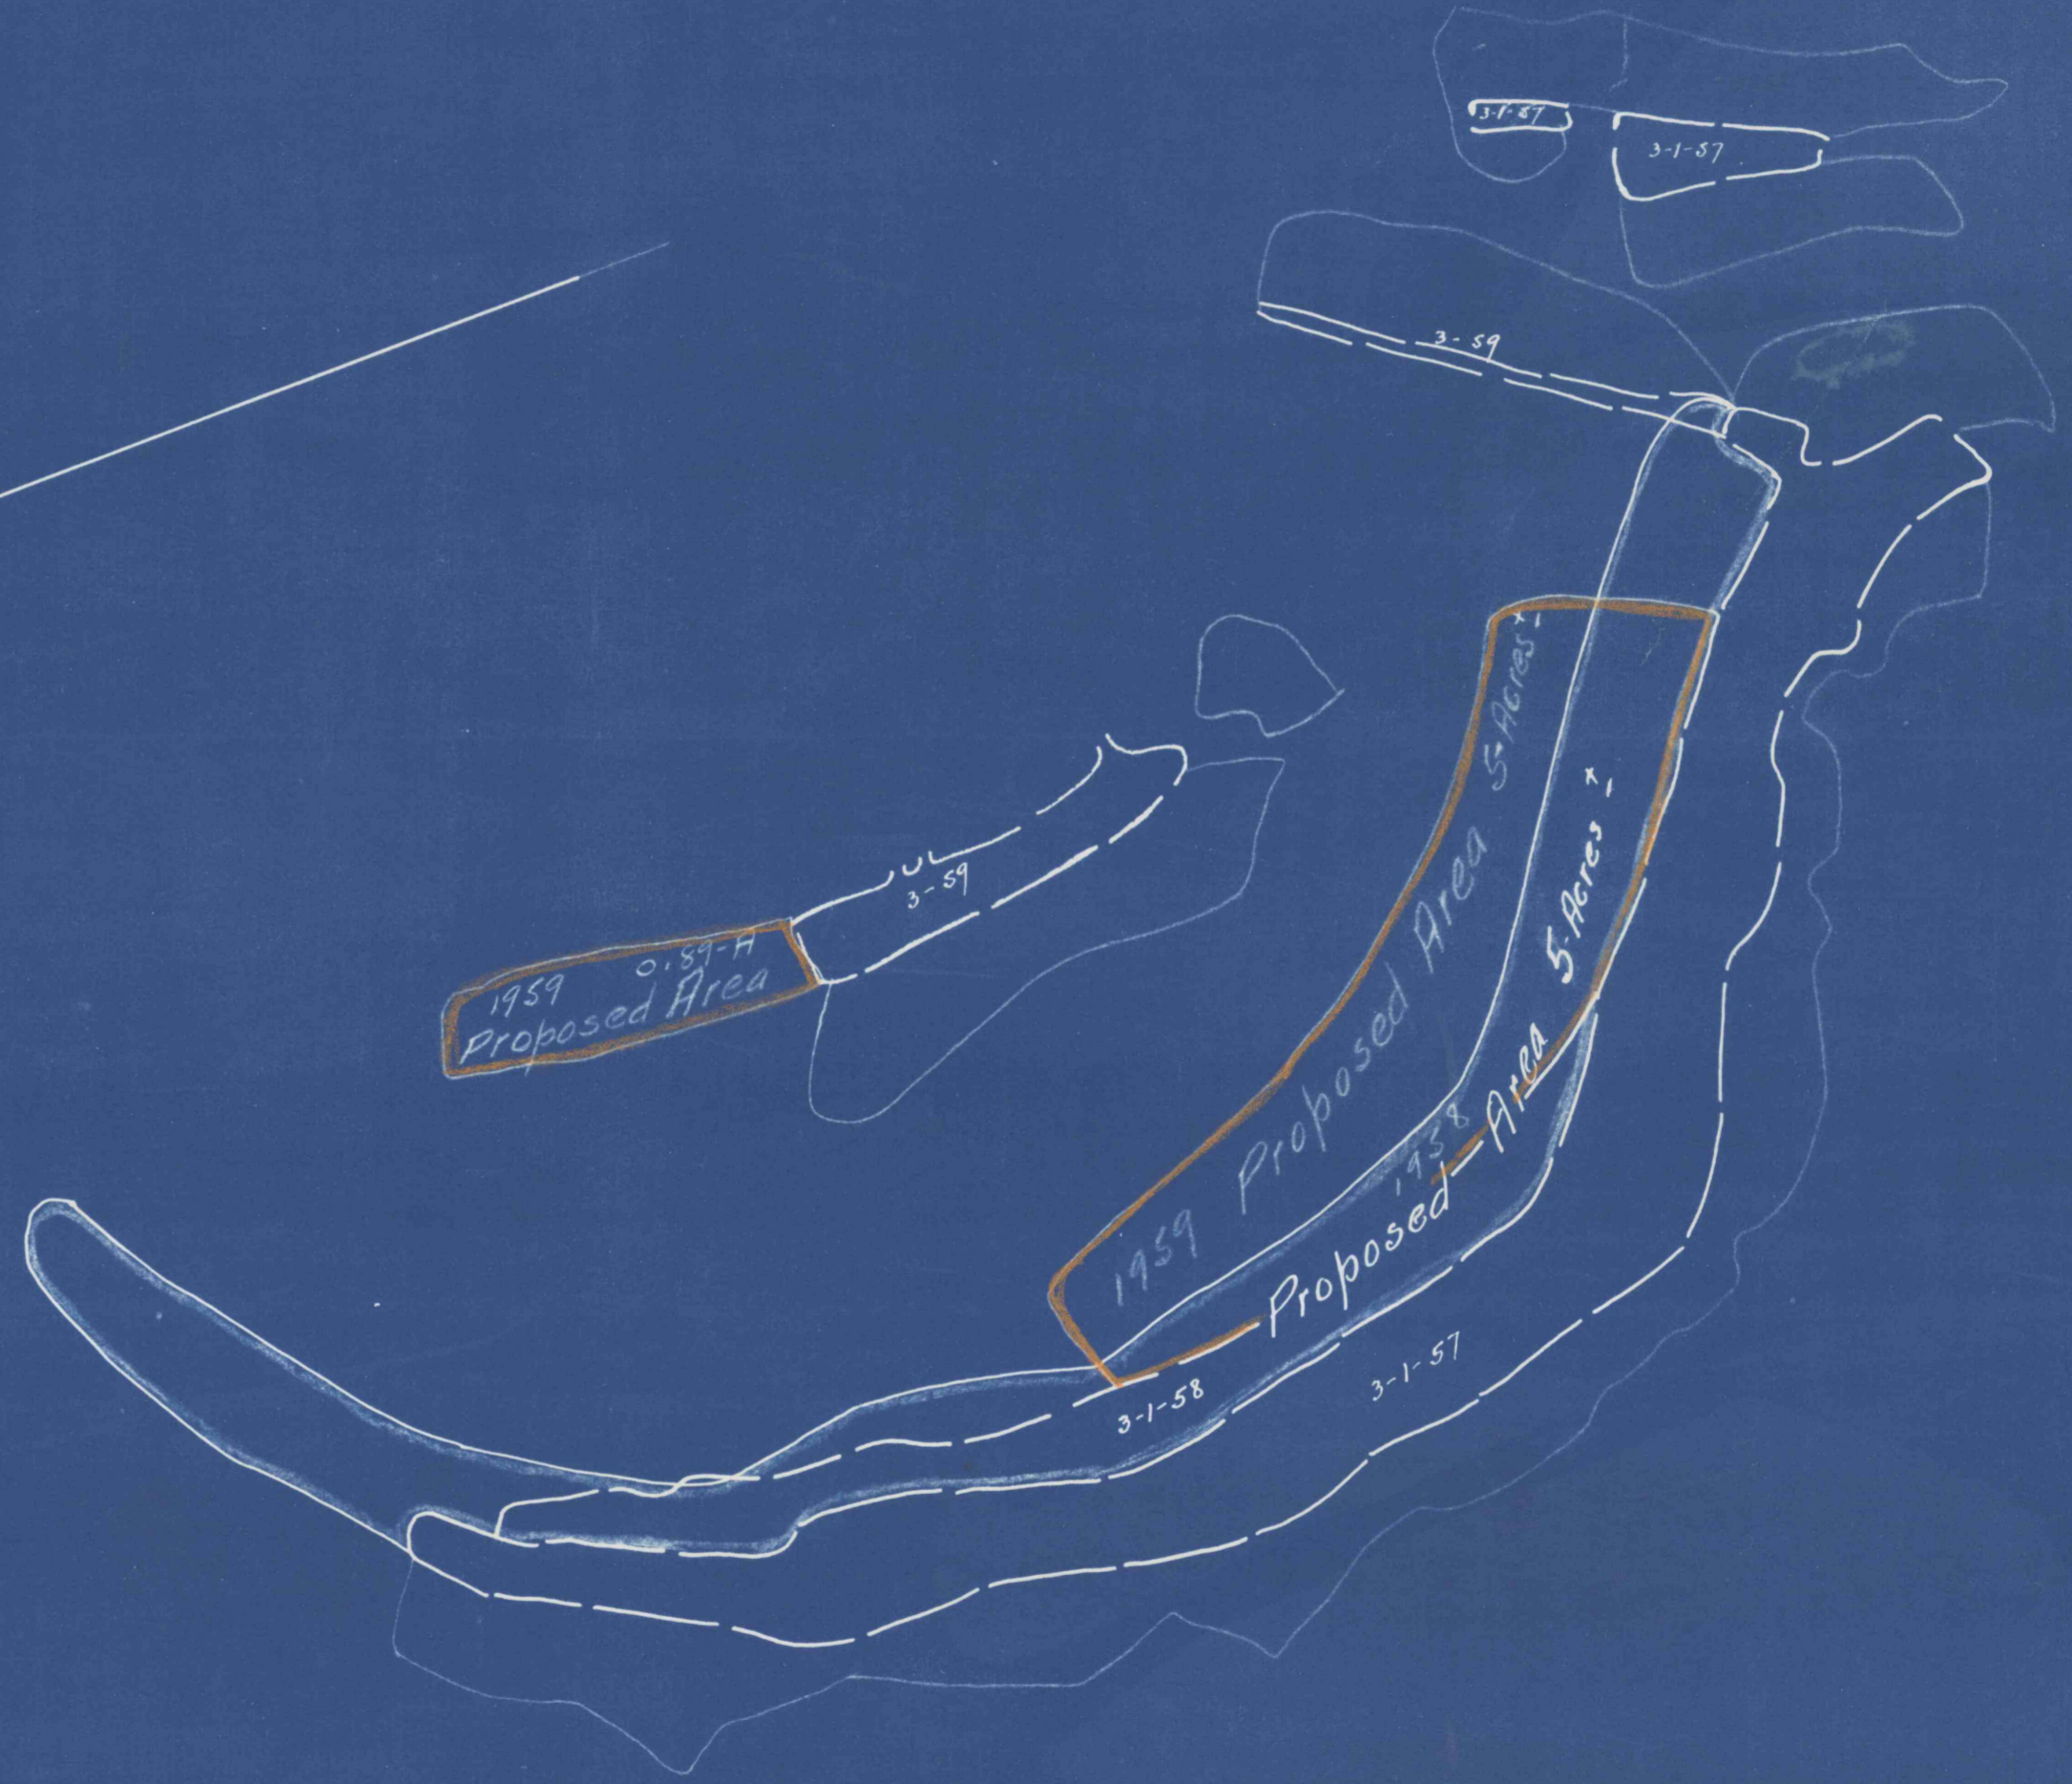

Print Showing Proposed Area To Be Striped By Chas Crotsley and Son. = 5 Acres ± Todd Twp. Huntingdon County Penna. March - 1957  
 1" = 200' E Corrie Robertsdale Pa