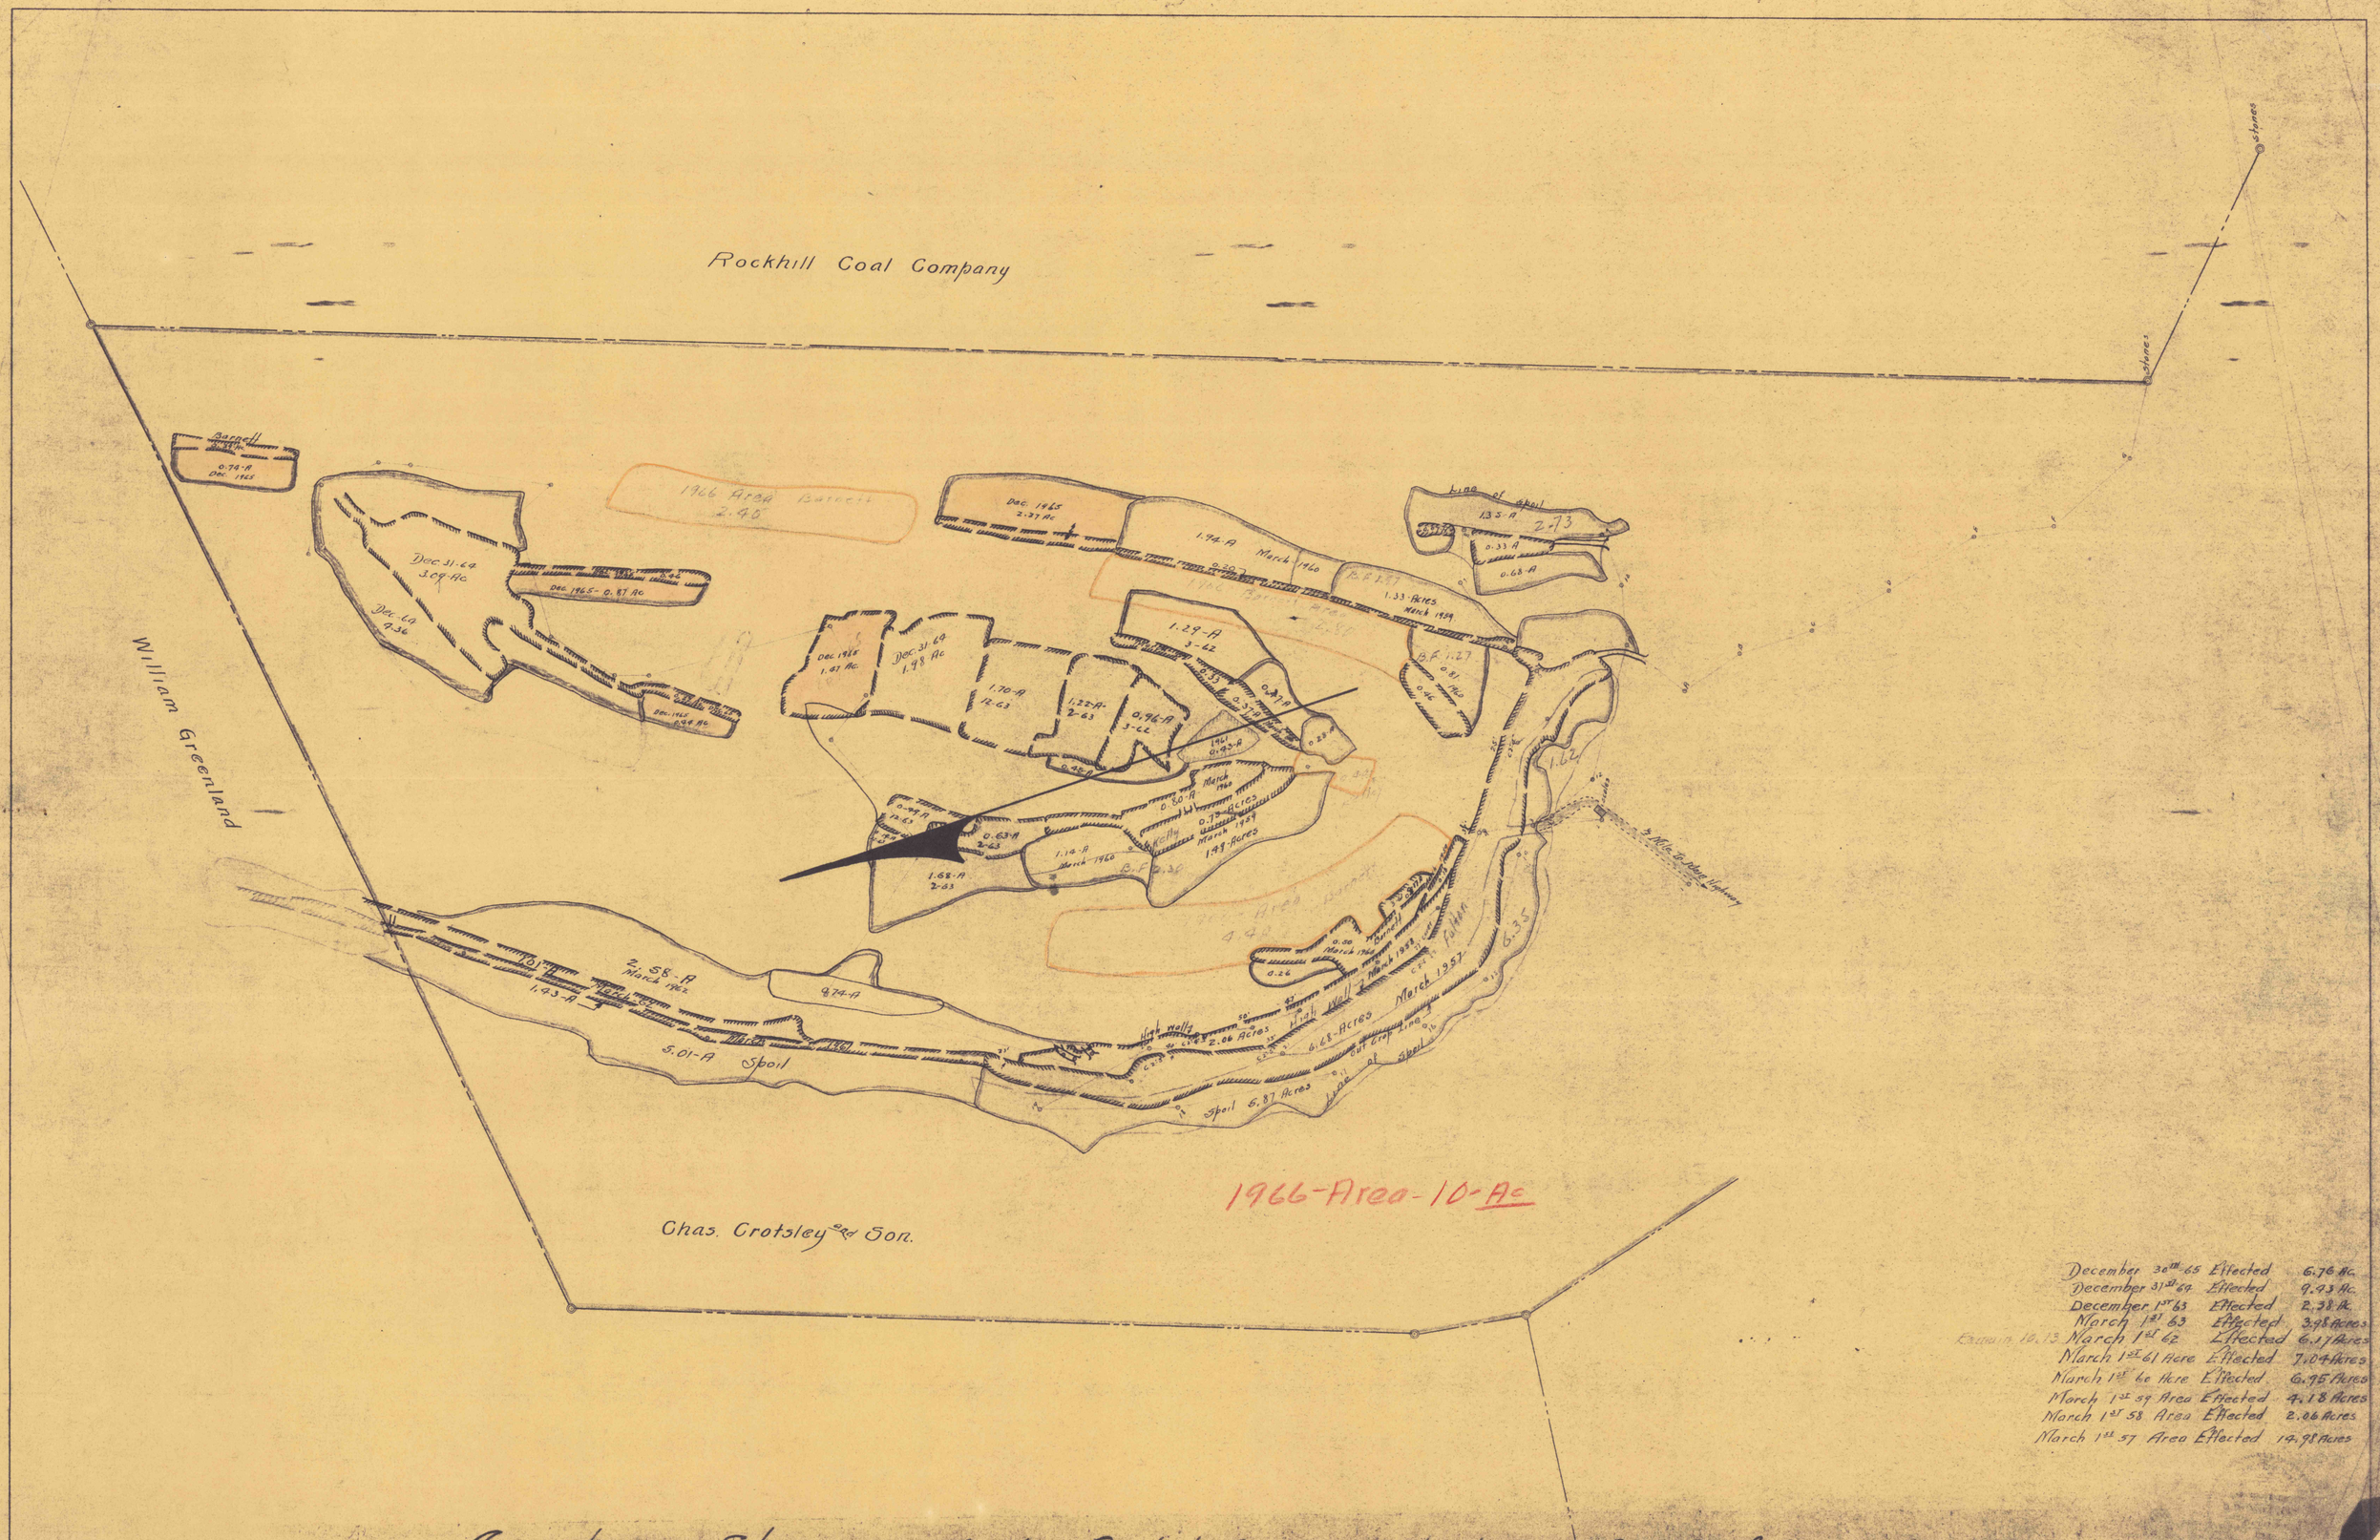

Map Showing Strippings of Chas. Crotsley and Son. Situated in Todd Twp. Huntingdon County Penna. March [redacted]

1" = 200' E. Corrie Engr. Robertsdale Pa.