


1000
950
900
850
800

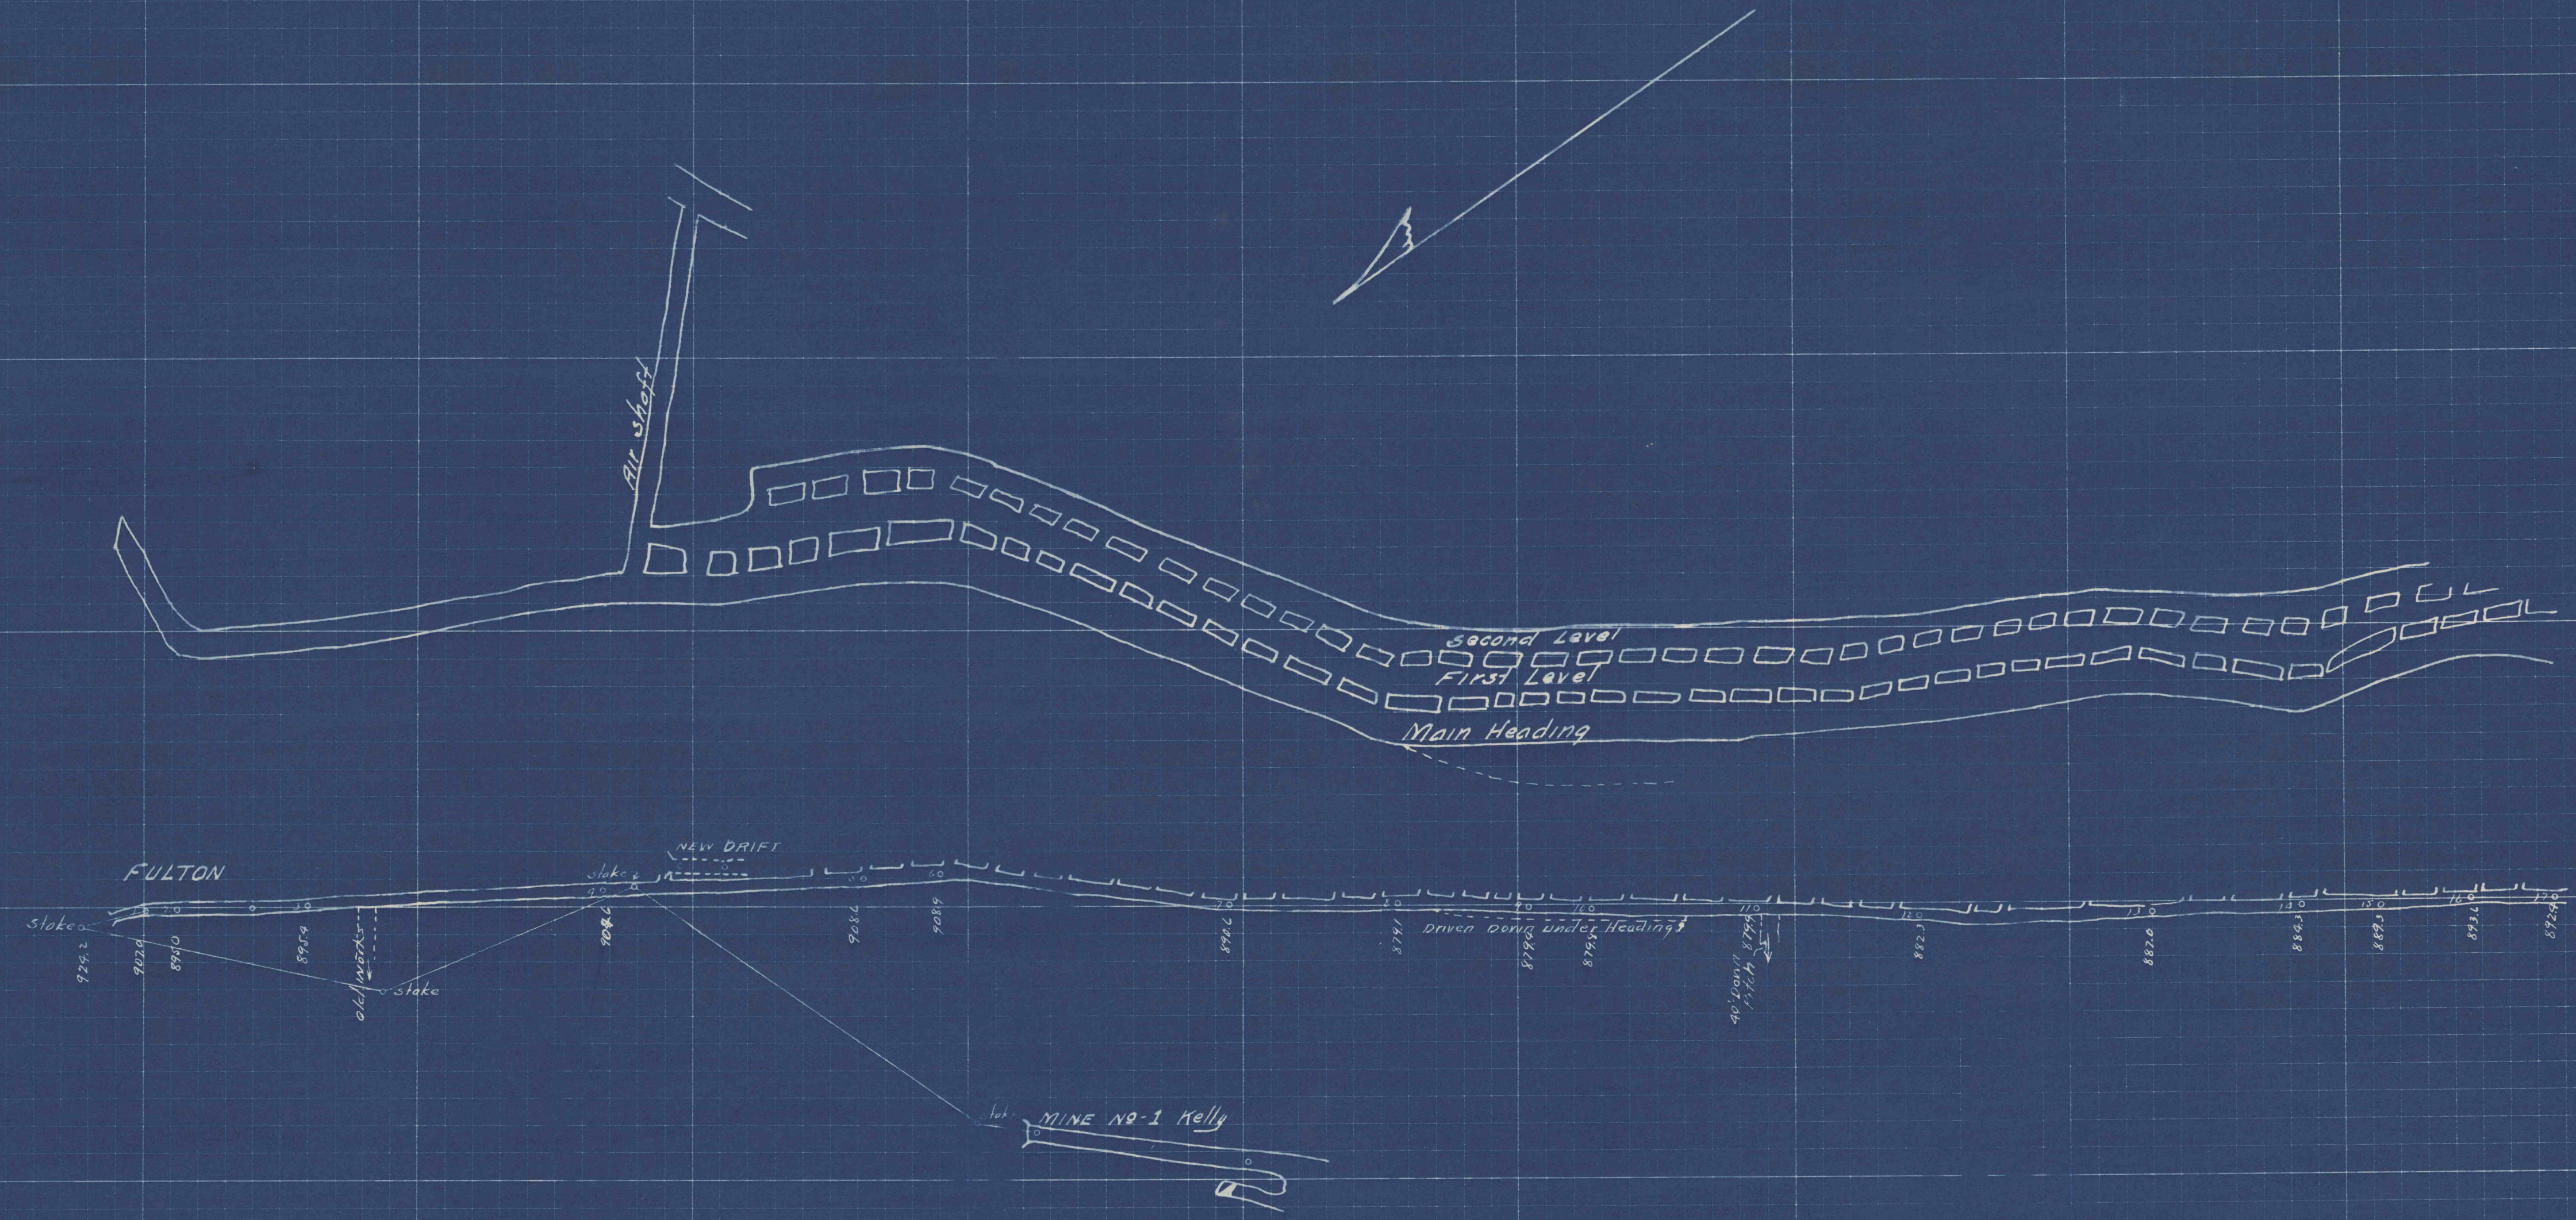

CHAS. CROTSLEY
MINE MAP
MINE NO 2 FULTON
Rocky Ridge Todd Twp. Hunt. Co. Pa.
Scale 1"=100' Horiz. 1"=20' Vert.
March 1st 1943 E. Corrie Engr.