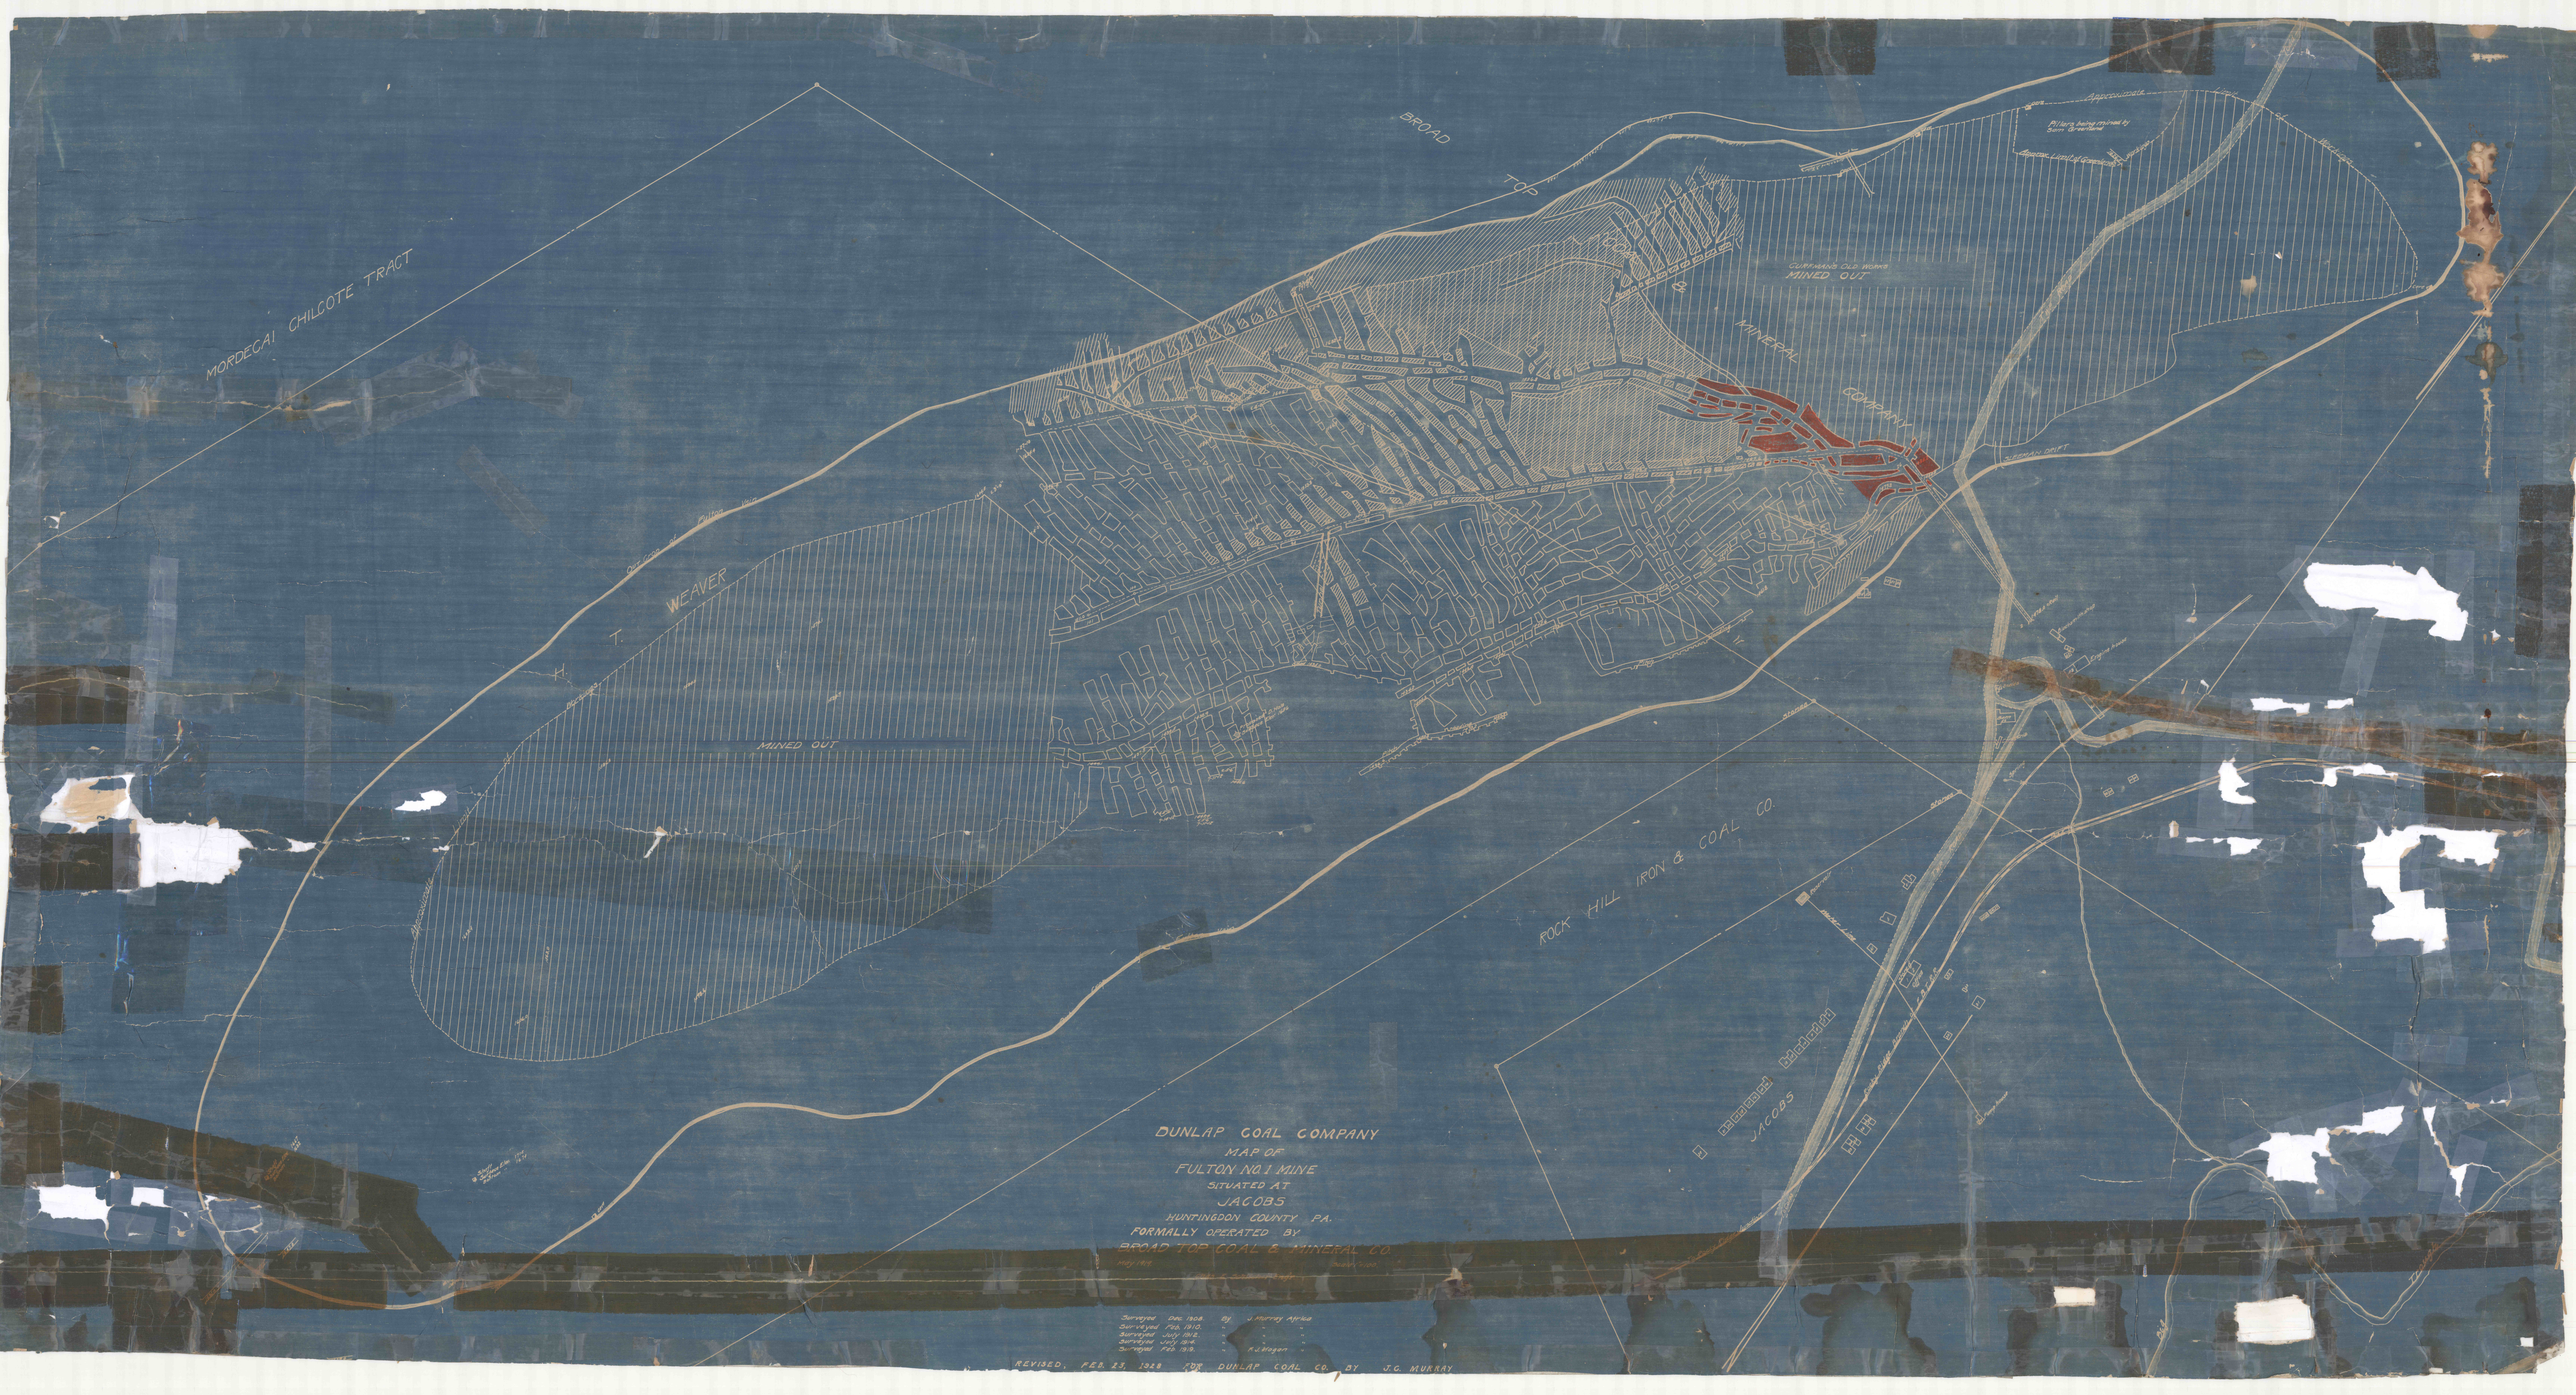
MORDECAI CHILCOTE TRACT
BROAD TOP
COAL & MINERAL COMPANY
MINED OUT
T. WEAVER
MINED OUT
ROCK HILL IRON & COAL CO.
JACOBS
DUNLAP COAL COMPANY
MAP OF
FULTON NO. 1 MINE
SITUATED AT
JACOBS
HUNTINGDON COUNTY PA.
FORMALLY OPERATED BY
BROAD TOP COAL & MINERAL CO.
Surveyed Dec. 1908 By J. Murray Africa
Surveyed Feb. 1910 " " "
Surveyed July 1912 " " "
Surveyed July 1914 " R.J. Hagan "
Surveyed Feb. 1919 " " "
REVISED, FEB. 23, 1928 FOR DUNLAP COAL CO. BY J.G. MURRAY