


J. H. SIMMON

MAP OF
GLENDALE NO 7
OPERATED BY
THE LANGDON COAL CO

Scale: *Amely, Joe, Felt, Mansfield, Dinko, & Lester, Min. Enger.*
Note: All surveys and data prior to May 1926 by W.D.C. *See Agency Reports*
1926 *Revised 11/17/26*

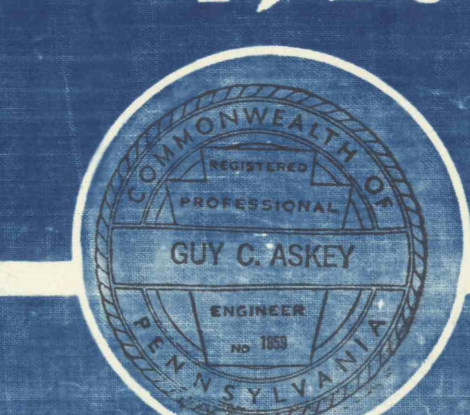

AE 531-7A
53-20-83