


J. H. SIMMONS

MAP OF
GLENDALE NO 7
 OPERATED BY
THE LANGDON COAL CO
 Scale: 1 inch = 100 feet. Horizontal Dime & Carter, Min. Eng'rs.
 Note - All surveys and data prior to May 1926 are by W.C.S.C. Survey, No. 1000
 1926

Revised Oct. 1960

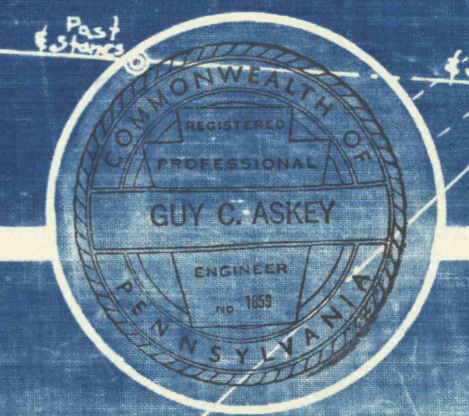

W.C.S.C. (53/17A)
 53-17A-3