Albert Figard

James M. McIntyre & Co

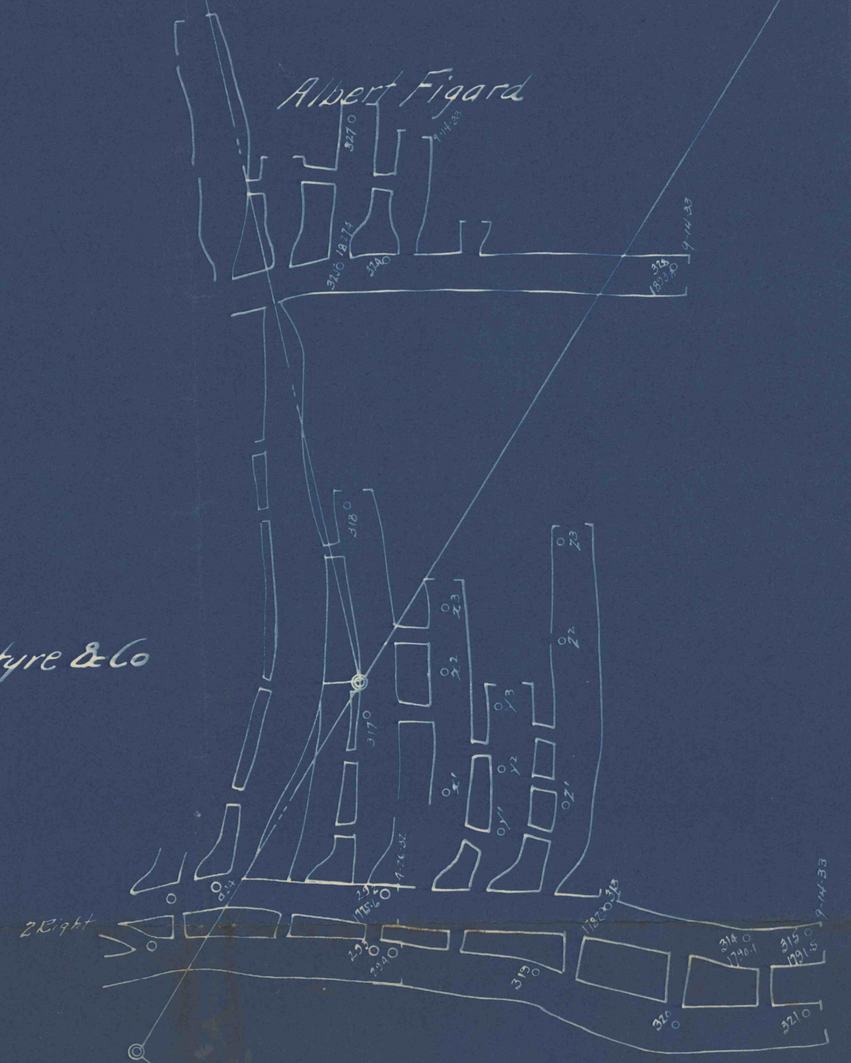

McIntyre Mines

Bunker Hill Coal Co