

D.D.H. 2
SURF. ELEV. 1336.3




D.D.H. 3
SURF. ELEV. 1461.3

D.D.H. 12
SURF. ELEV. 1101.4

Surf - 1643.5
Coal - 1325.1
Cover - 318.4

D.D.H. 11
SURF. ELEV. 1642.5

2-7-10
2-8-14
2-1-13
1-18-24

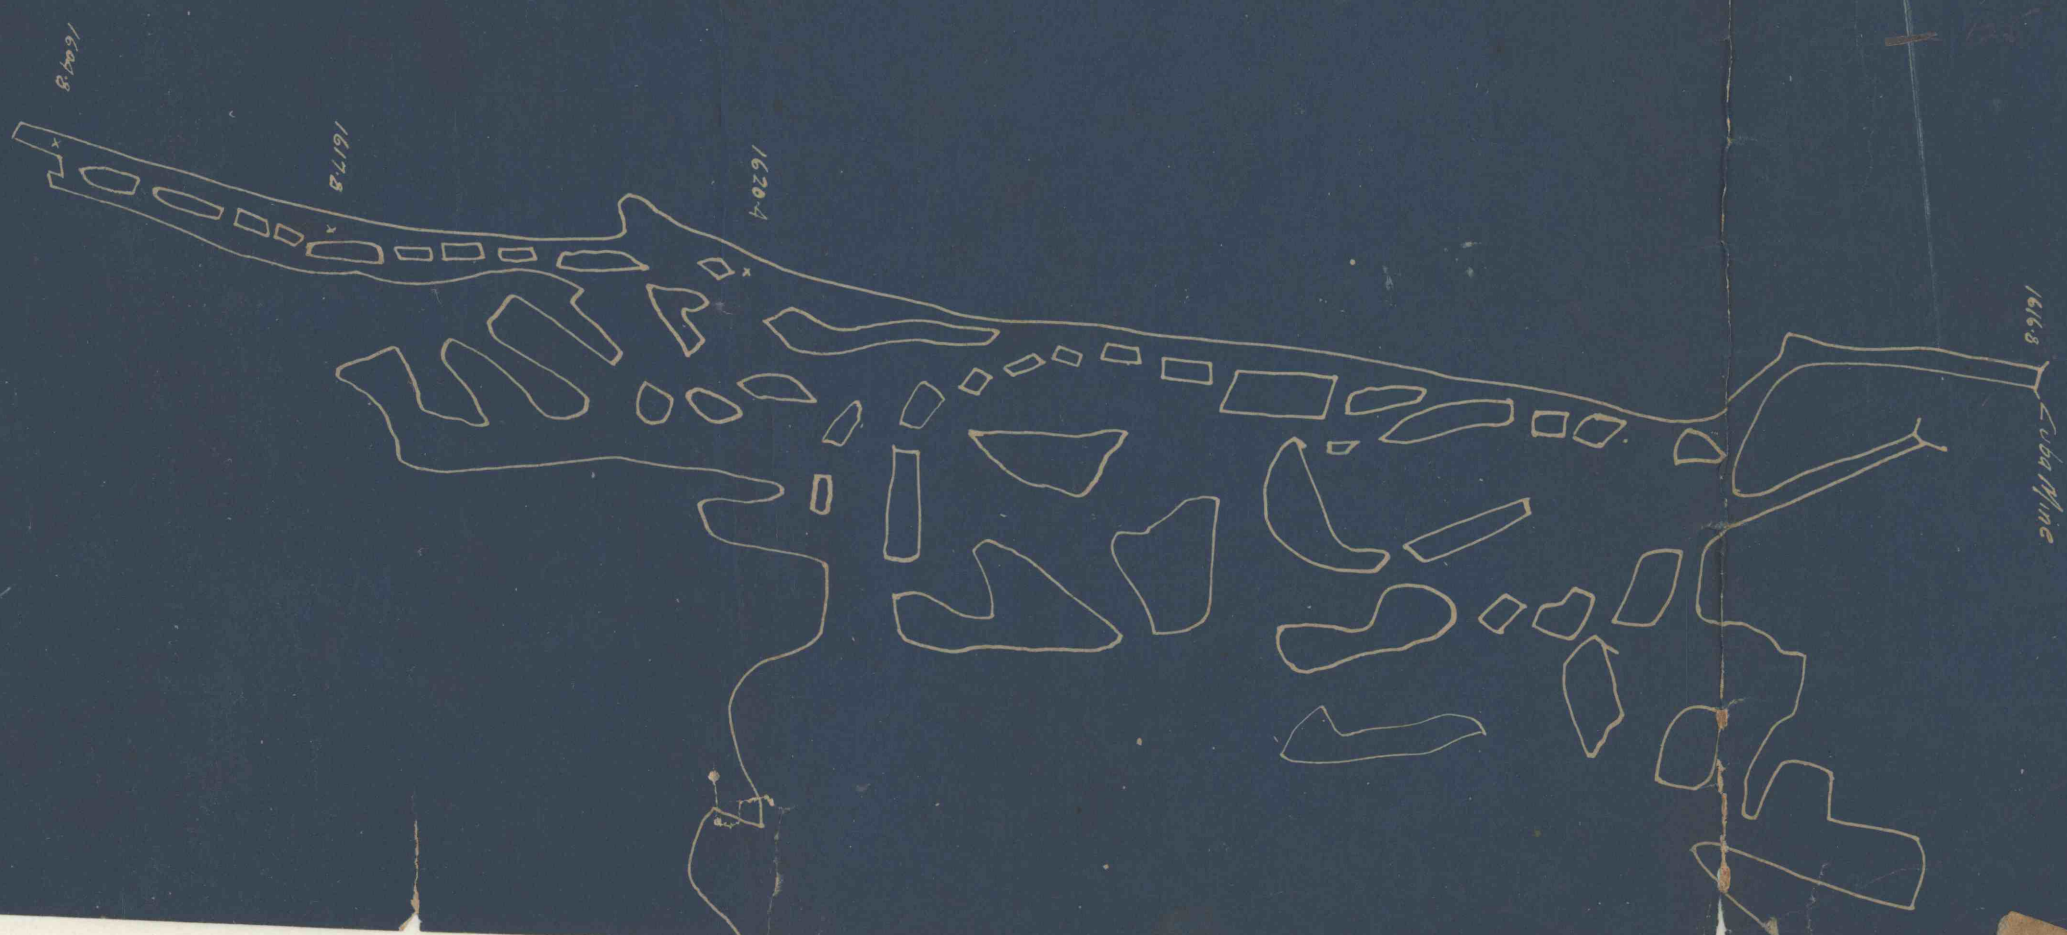

D.D.H. 10
SURF. ELEV. 1461.3