


MAP
OF
HIGHLAND MINES
OPERATED BY THE
HIGHLAND COAL MINING CO.

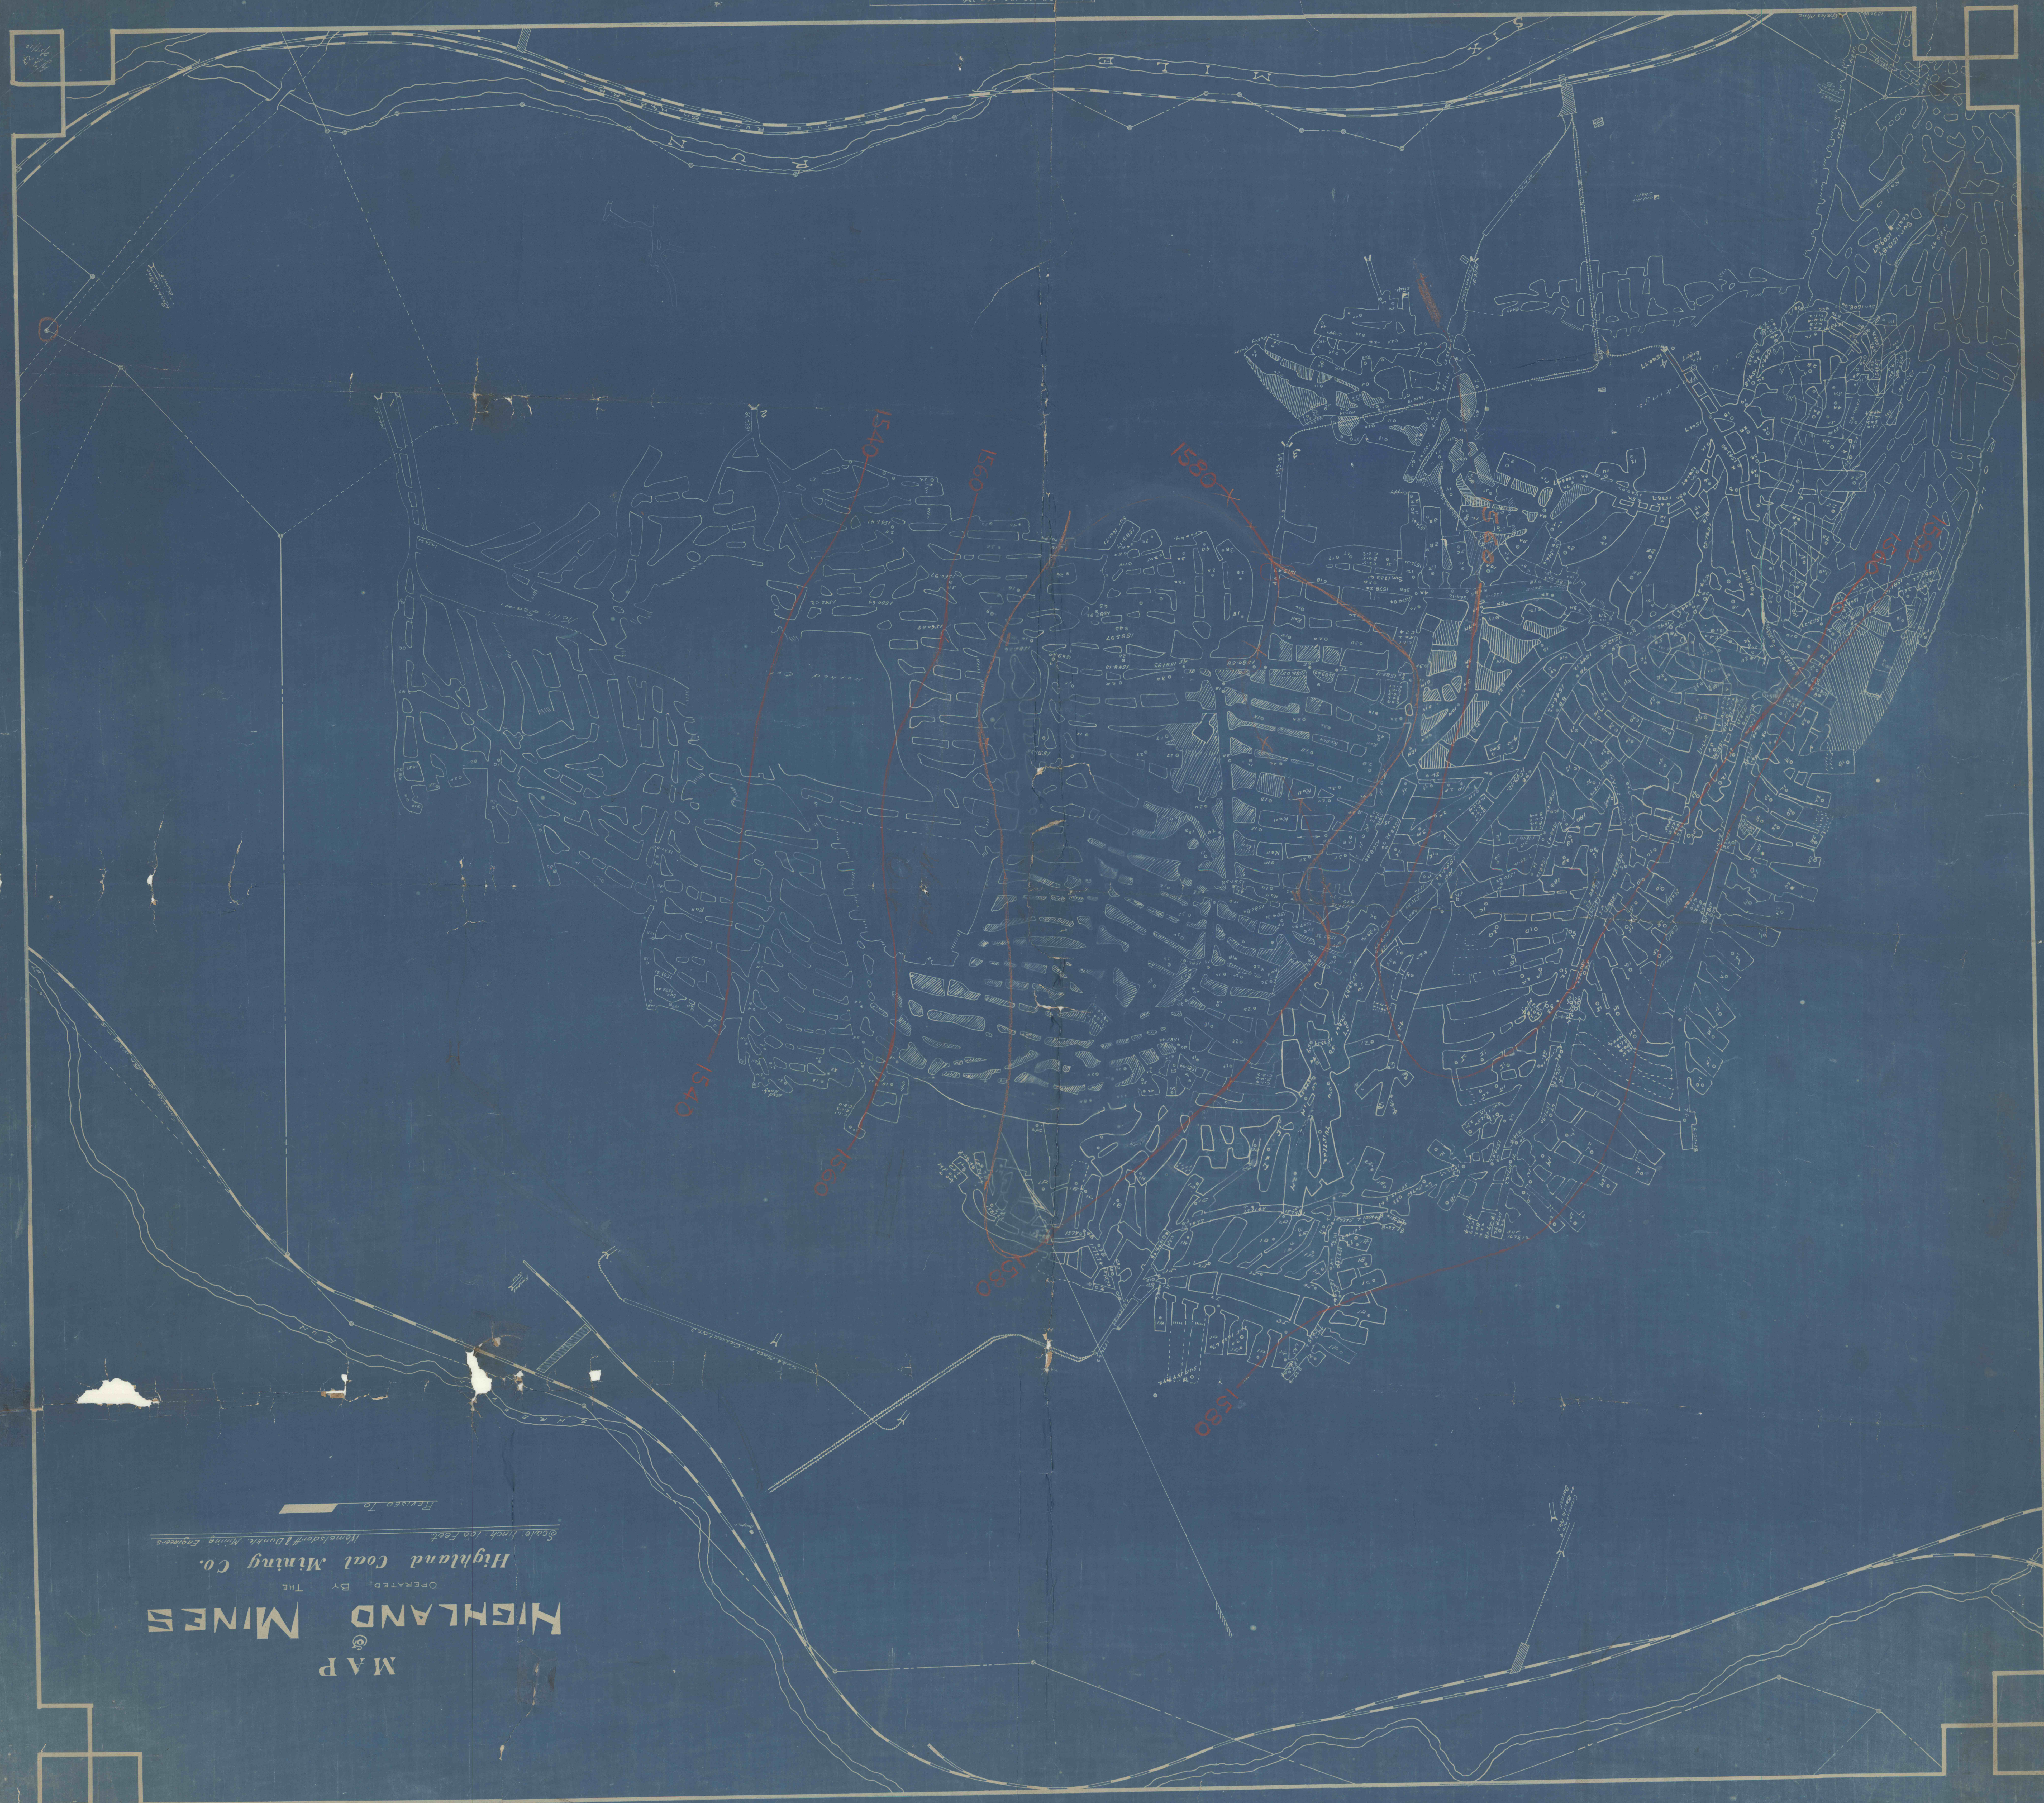

HIGHLAND COAL MINING CO.
