


Scale: 1 inch = 100 feet

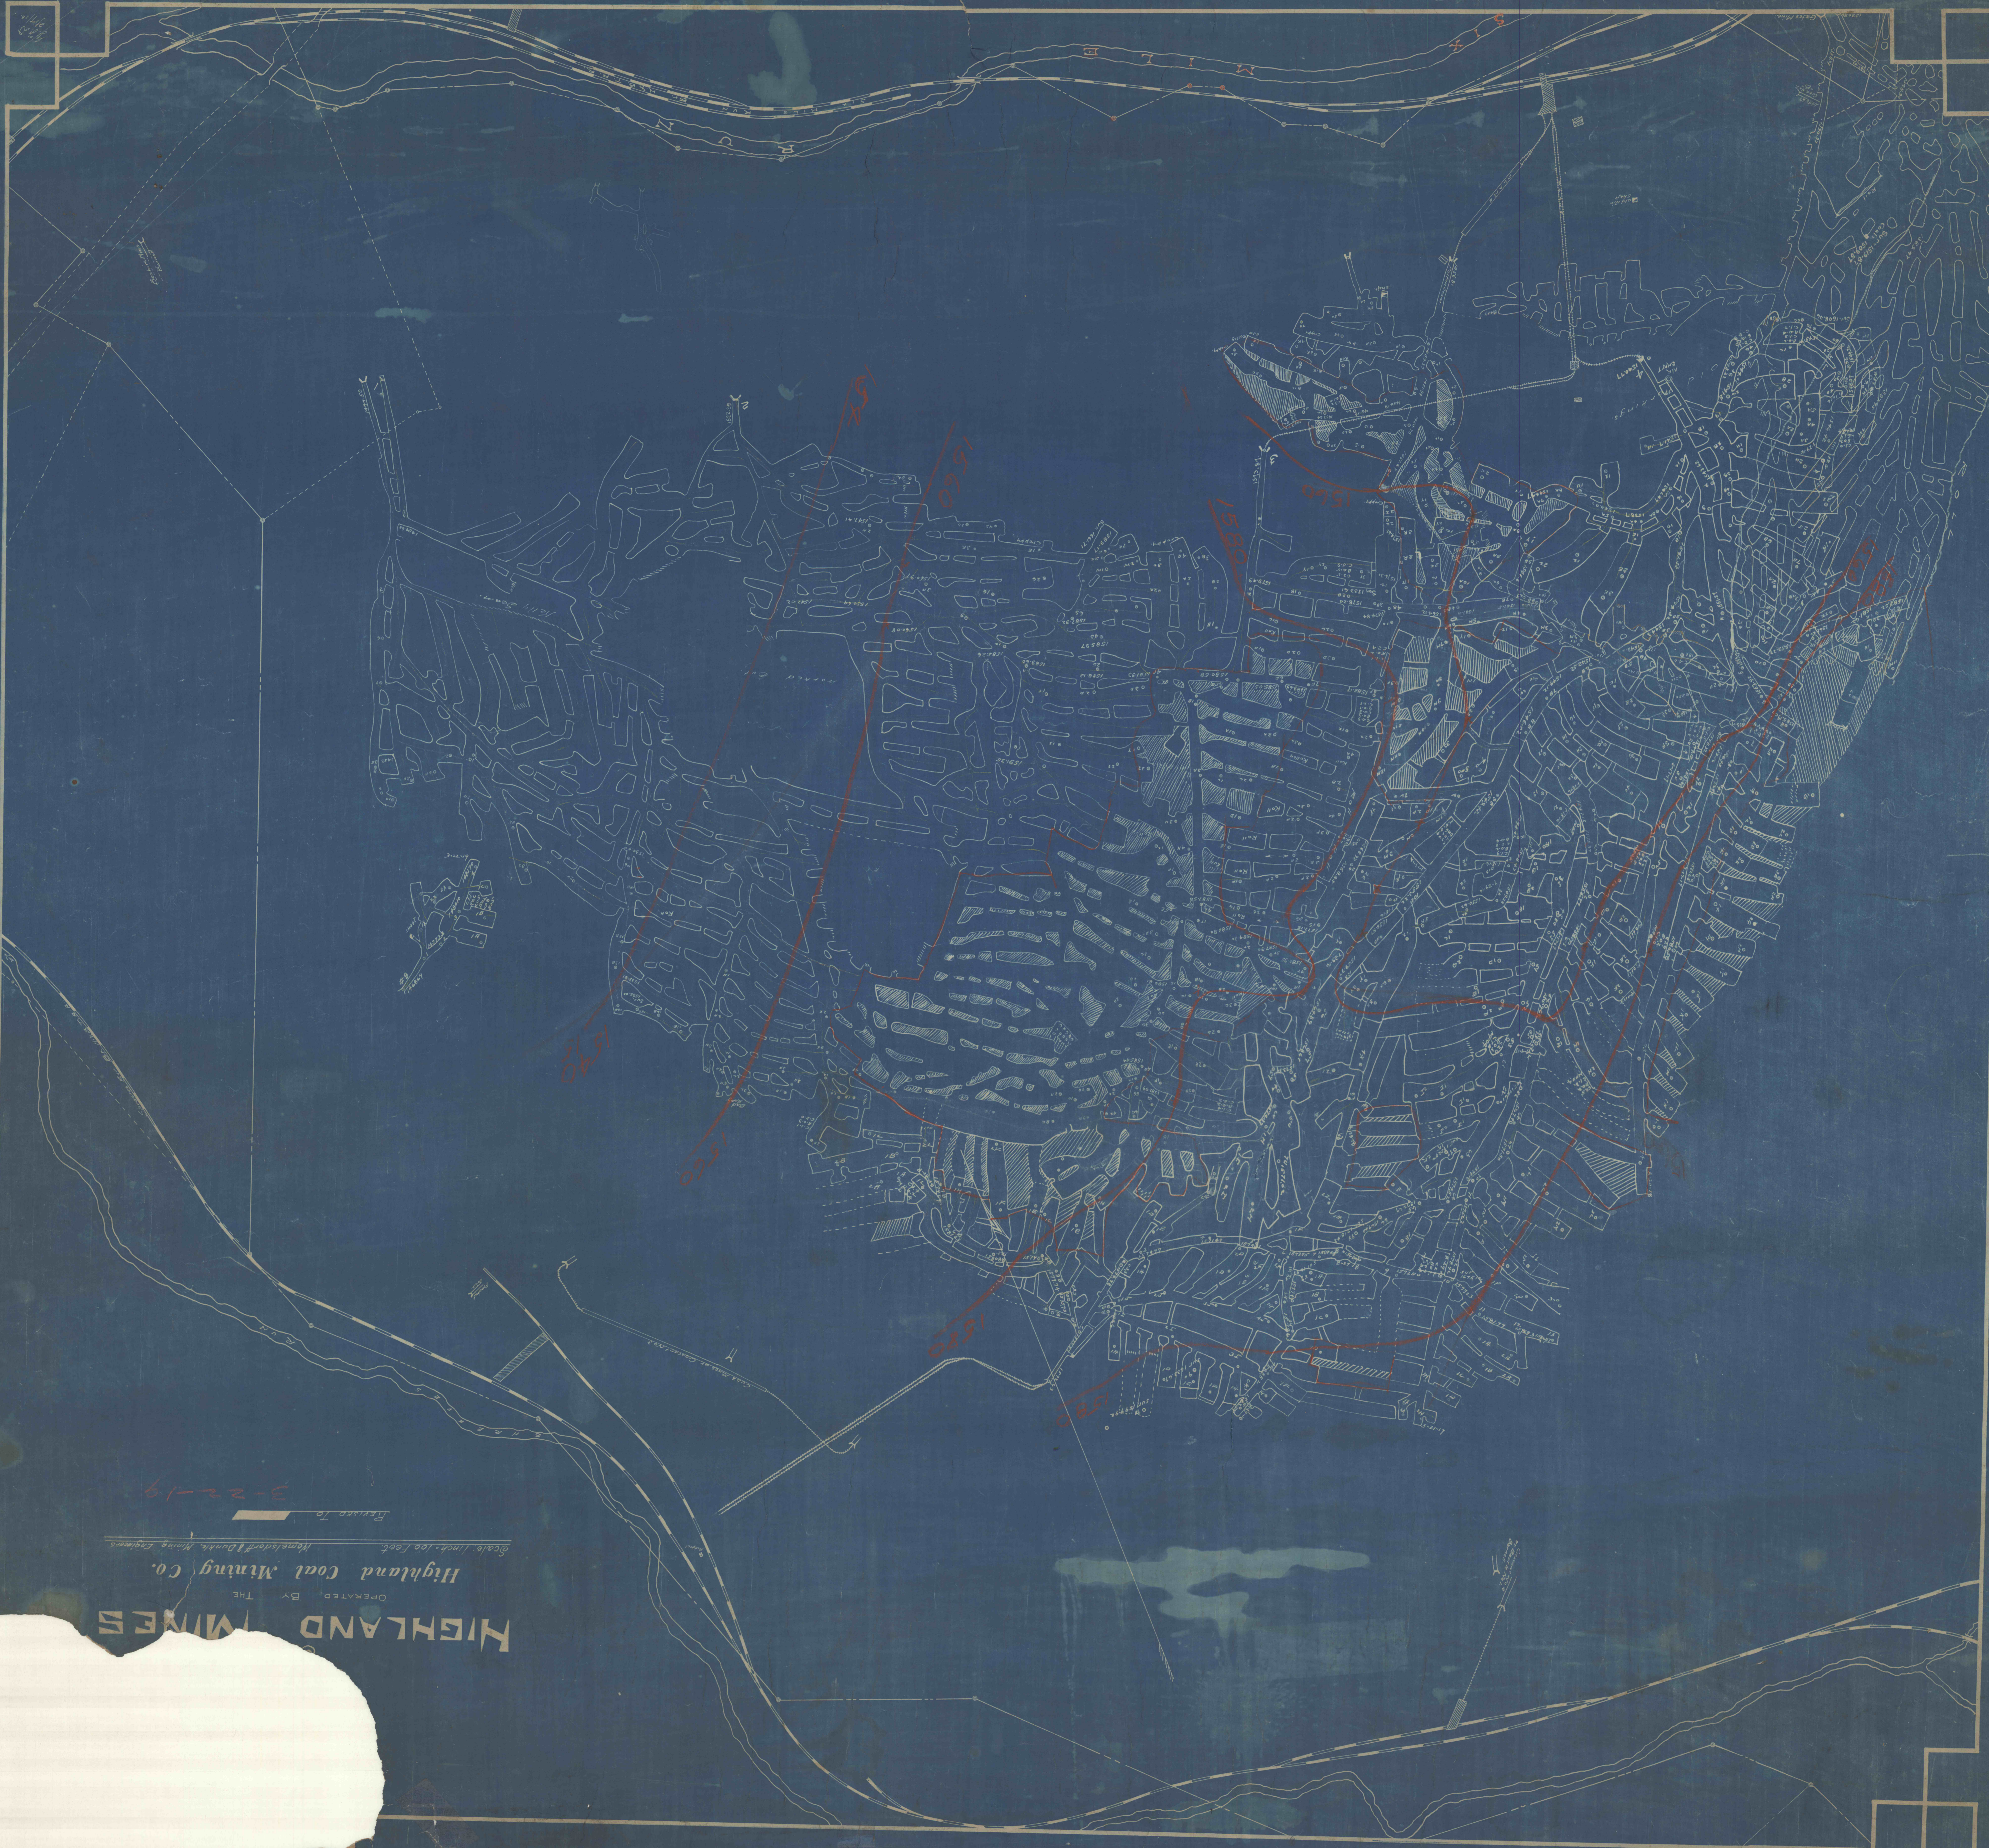

HIGHLAND MINES
Operated by the
Highland Coal Mining Co.
Hemelsdorf & Dunth, Mining Engineers
Scale: 1 inch = 100 feet
Revised to _____
3-22-19