


M A P
HIGHLAND MINES
OPERATED BY
Highland Coal Mining Co.

Scale 1 inch = 100 feet

Planned

July 1916

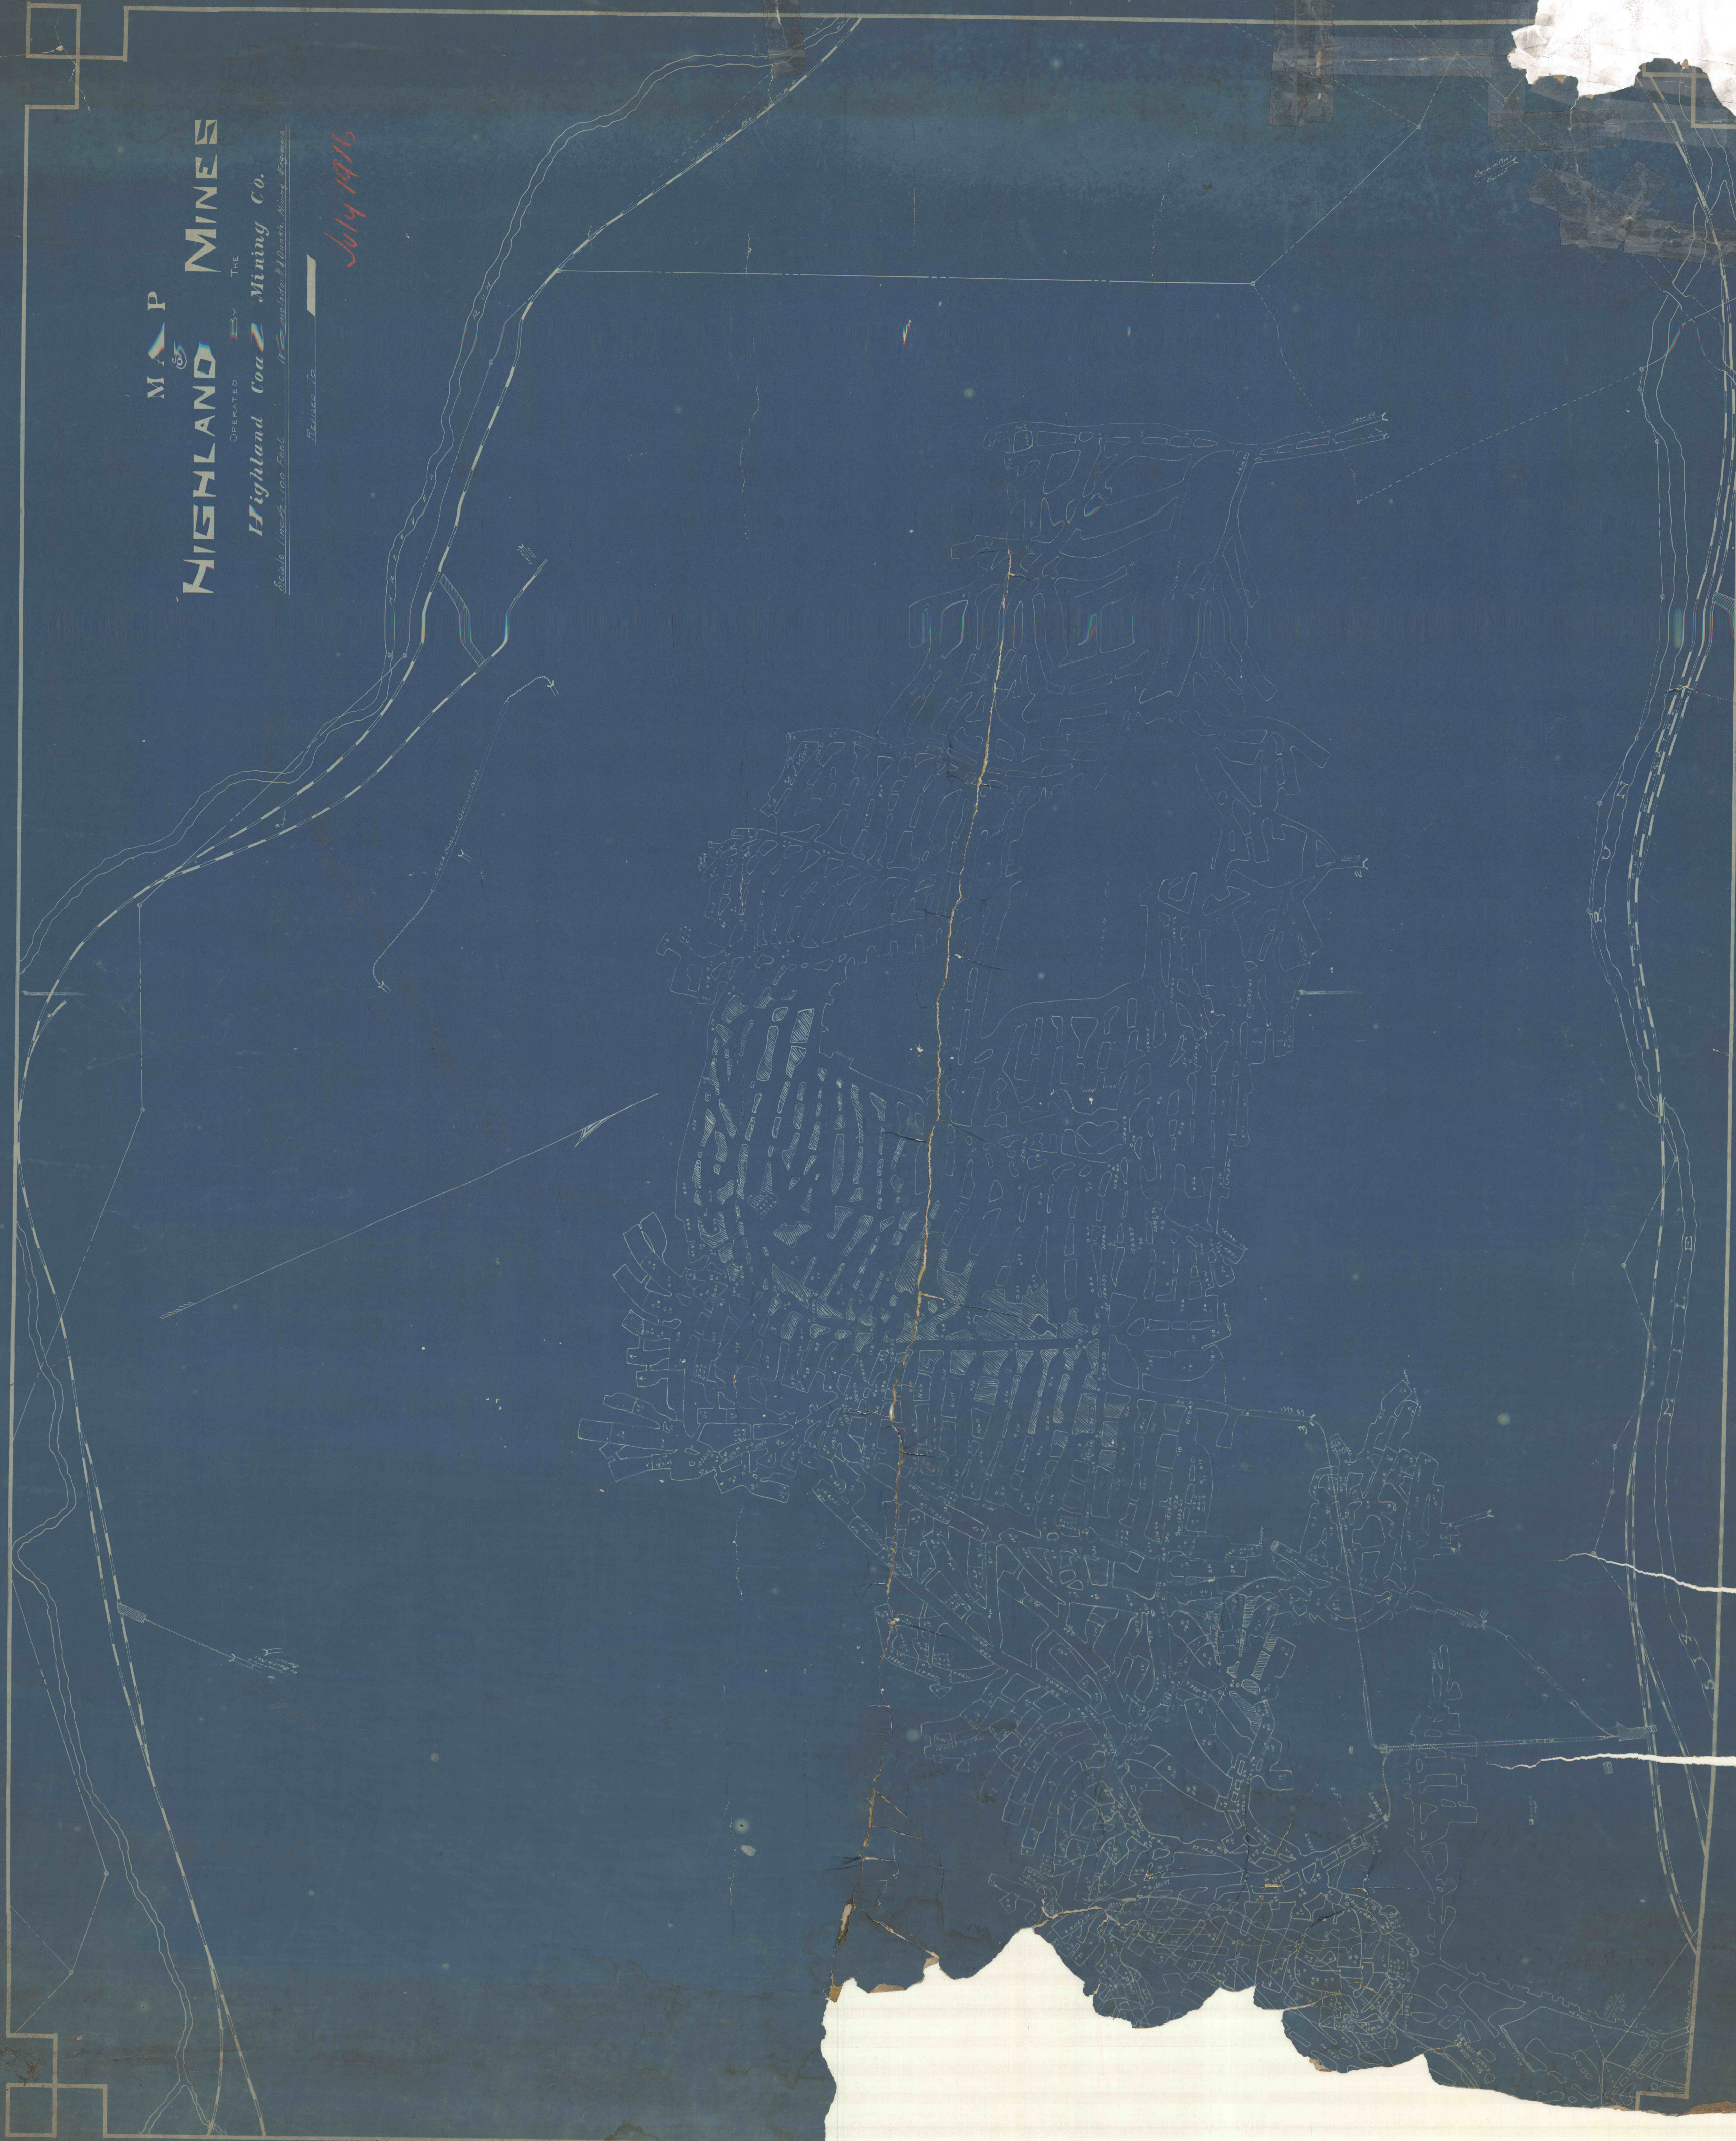

Highland Coal Mining Co.
1916