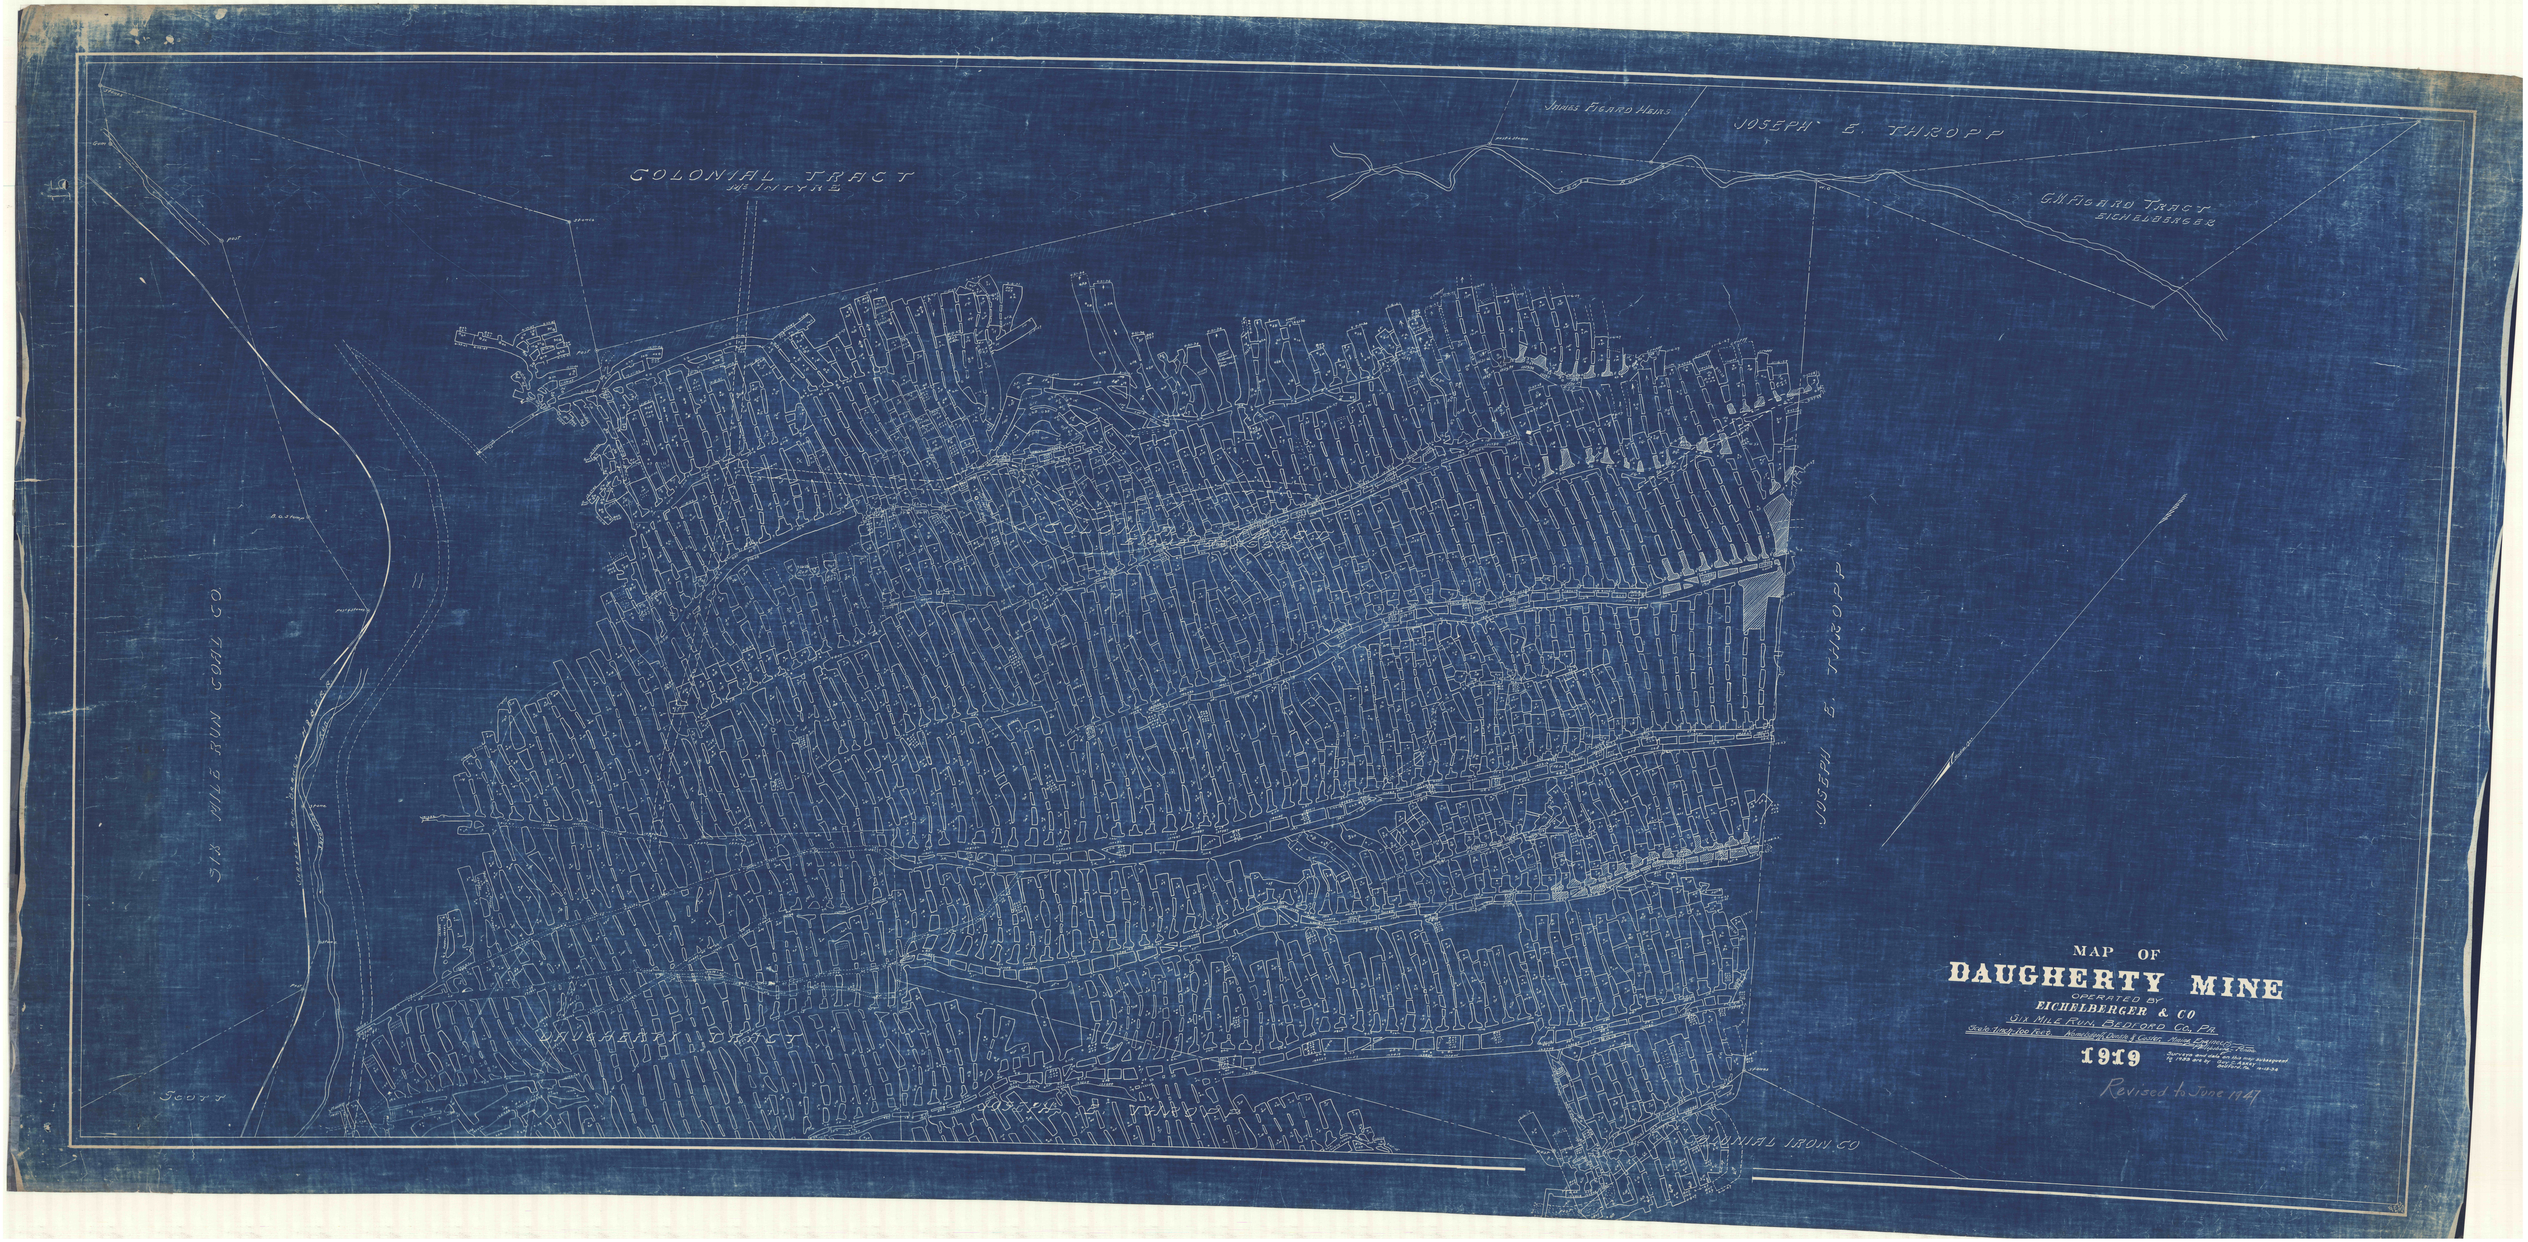
COLONIAL TRACT
McINTYRE
JAMES GIBARD HEIRS
JOSEPH E. THROPP
G.W. GIBARD TRACT
EICHELBERGER
SIX MILE RUN COAL CO
JOSEPH E. THROPP
COLONIAL IRON CO
MAP OF
DAUGHERTY MINE
OPERATED BY
EICHELBERGER & CO
SIX MILE RUN, BEDFORD CO., PA.
1919
Revised to June 1941