
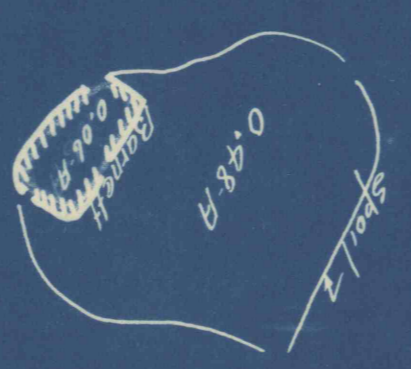


Rockhill Coal Co.

P^{ist} B. Coal Co.

Rockhill Coal Co.

Broad Top City

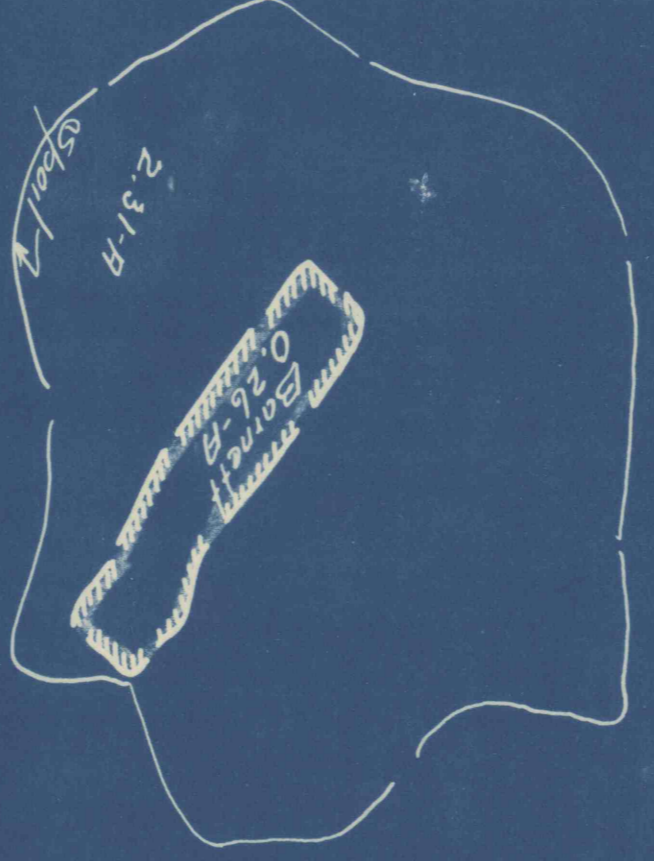

Borough Line

Barnett
13.91-A

Shoal 12

17.49-B

Acres Striped — 14.23
 Acres Operated — 34.51

14.23-A
 First Showing Stripings And Back Filling Of The P^{ist} B. Coal Co. In Cabour Twp^{sh} Broad Top City Borough Huntington Co. Penna.
 E. Corrie Esqr. Robertsdale

Shoal 12

Shoal 12