

W. M. REED
Geological Engineer

MAP McCLAIN MINES

McCLAIN COAL COMPANY
CARBON TOWNSHIP — HUNTINGDON COUNTY



Scale: 1" = 100'

— 1944 —

OPERATED BY
CHAMBERLAIN BROTHERS COAL CO., AGE COAL CO.
SIX MILE RUN, Pa. Coalbrook, Pa.

REVISED (See page 11)


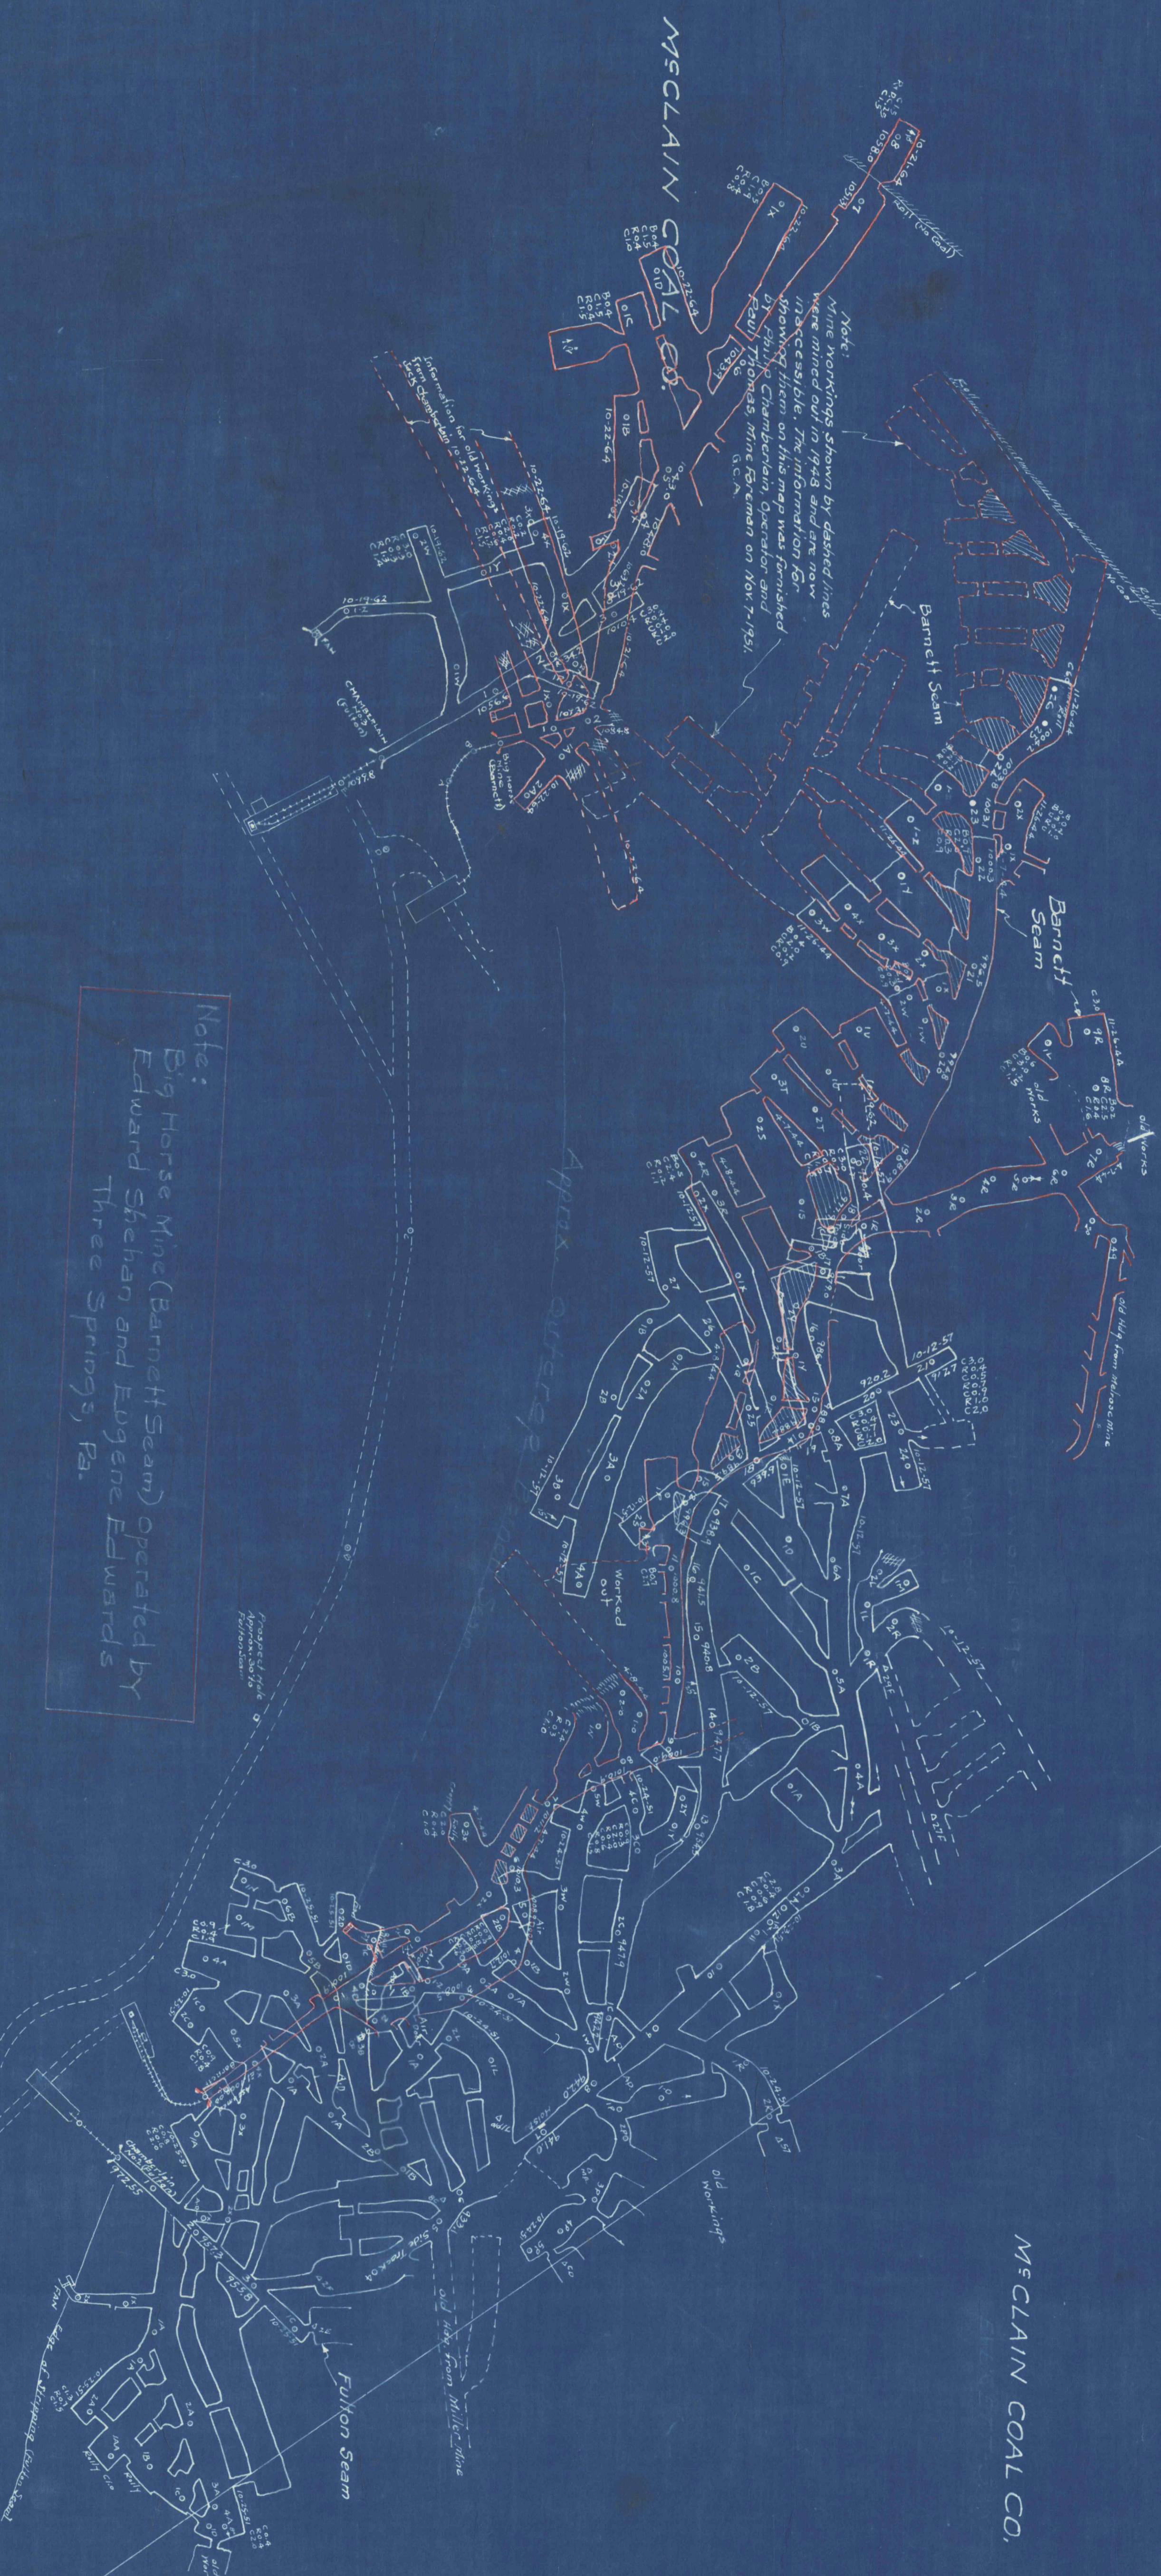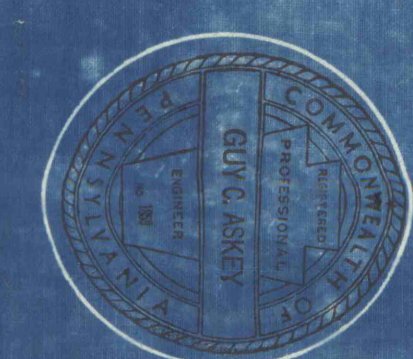

Note:
Big Horse Mine (Barnett Seam) operated by
Edward Shehan and Eugene Edwards
Three Springs, Pa.

H. & B. T. R. & CO.