


PORTION OF
BARNETT WORKINGS
ON PROPERTY OF
KAY COAL MINING CO

12" Water
6" Power

HEW SLOPE TO FULTON SEAM

KELLY-BARNETT
AIRCOURSE

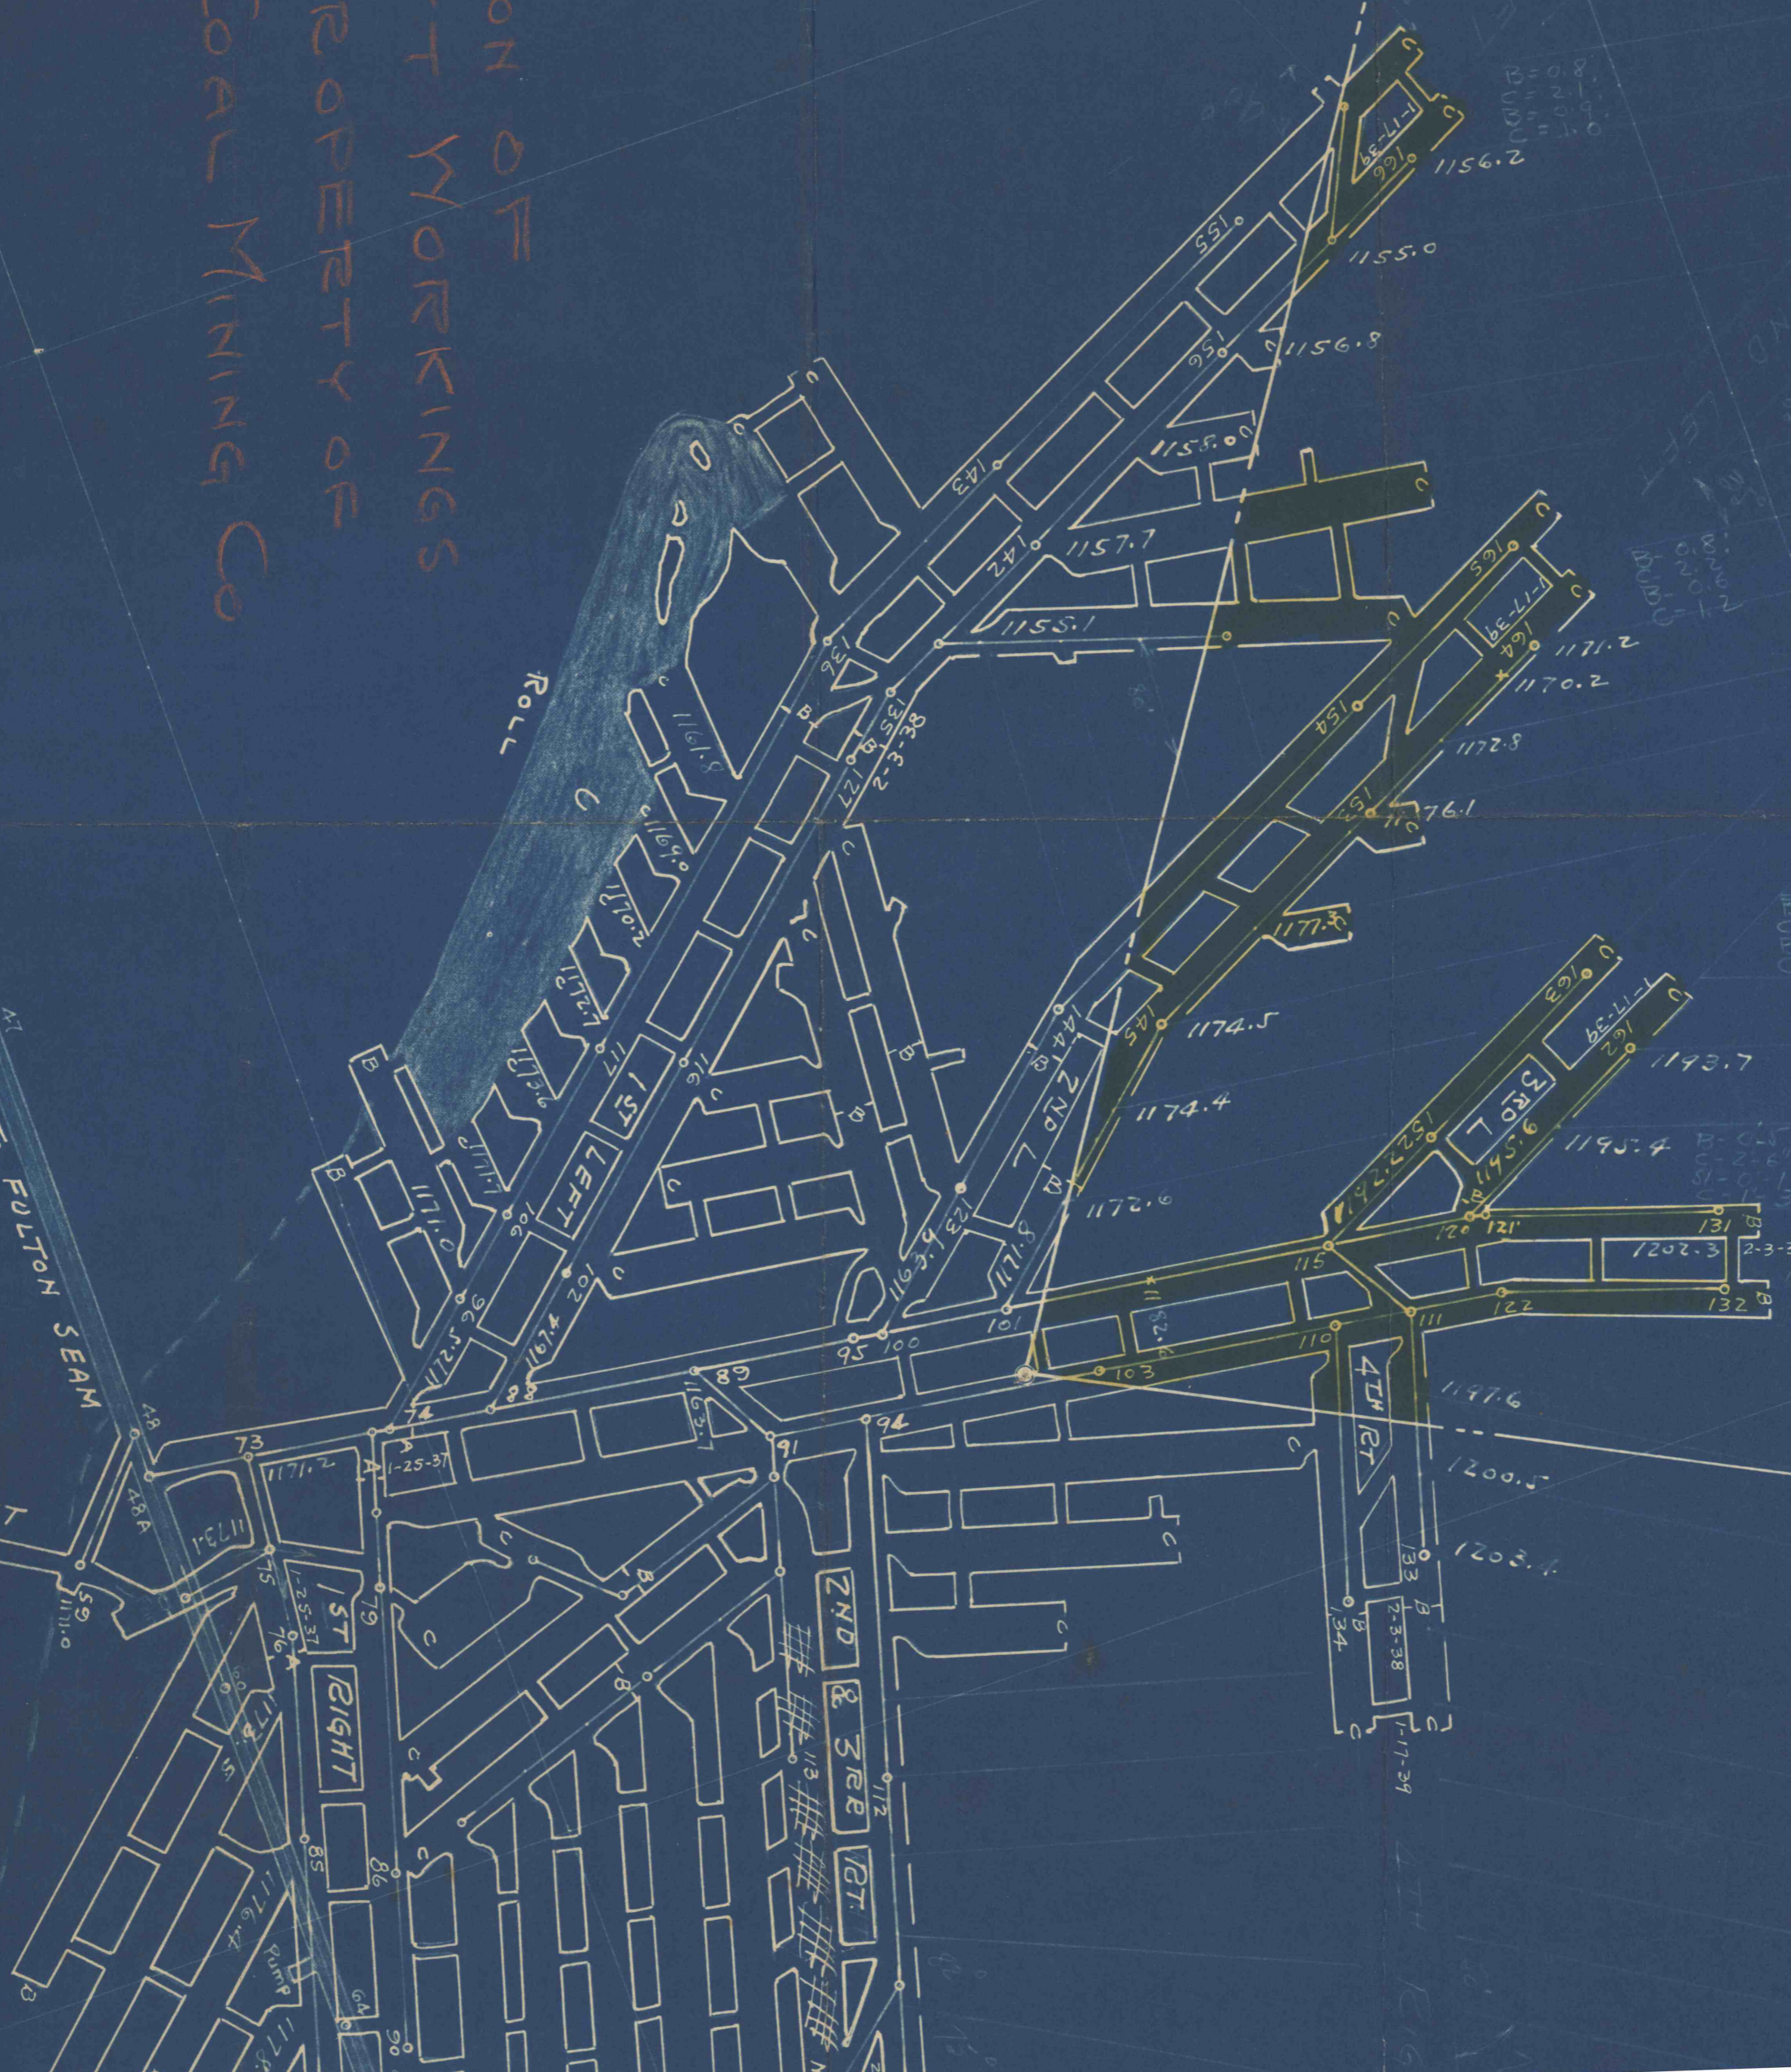

FIRST LEFT
SECOND
THIRD LEFT
N 71° 00' E

4TH RIGHT
5TH RIGHT