

MAP OF BACON N^o 5-6 & 9


OWNED BY
E. FICHELBERGER & CO.
Broad Top Township, Bedford County

KELLY SEAM

MINES
Nos. 5, 6, 9
No. 1

OPERATORS
Wm. H. Farlin


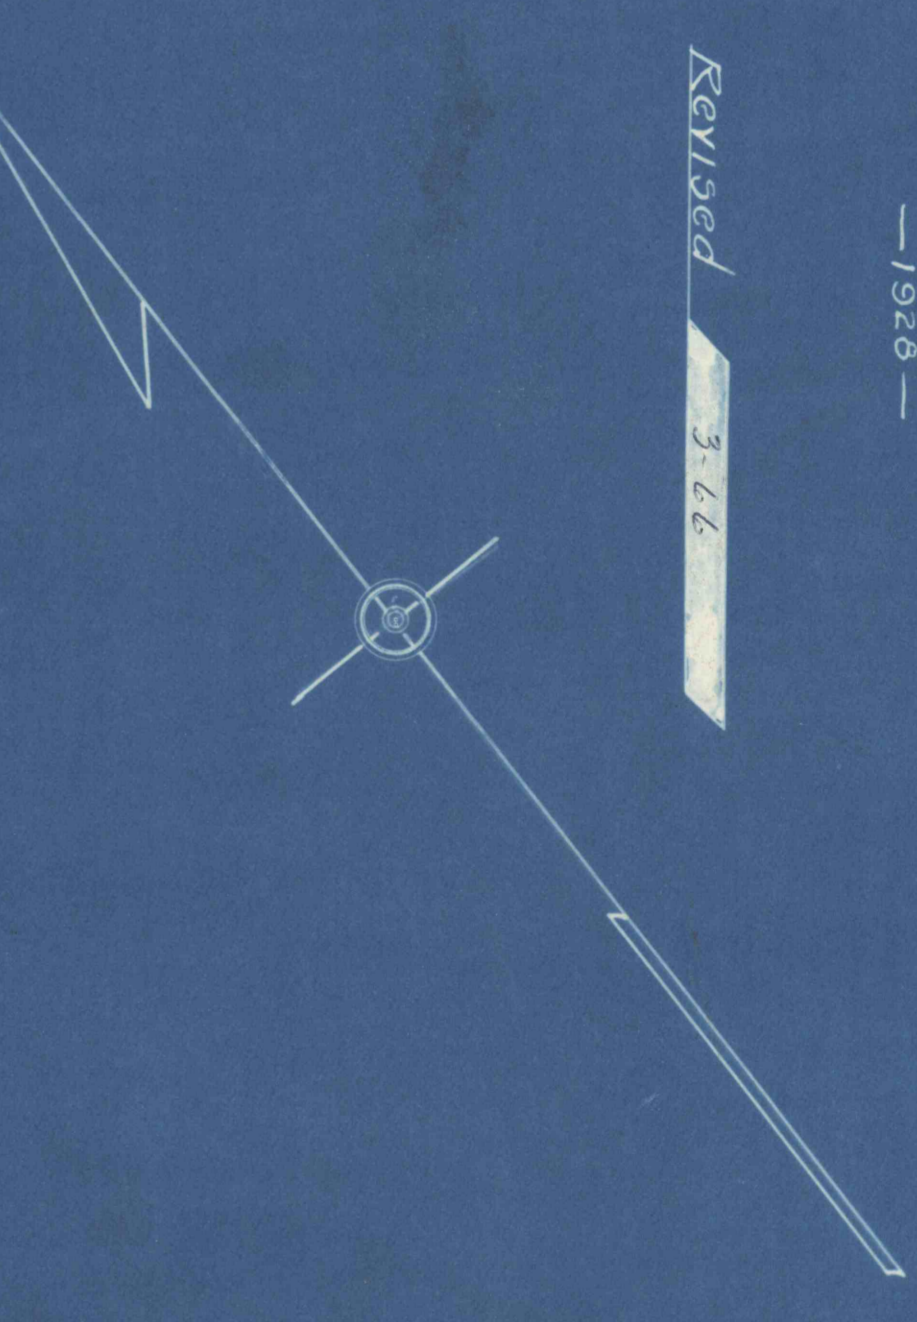

WIGTON TRACT

COLONIAL TRACT