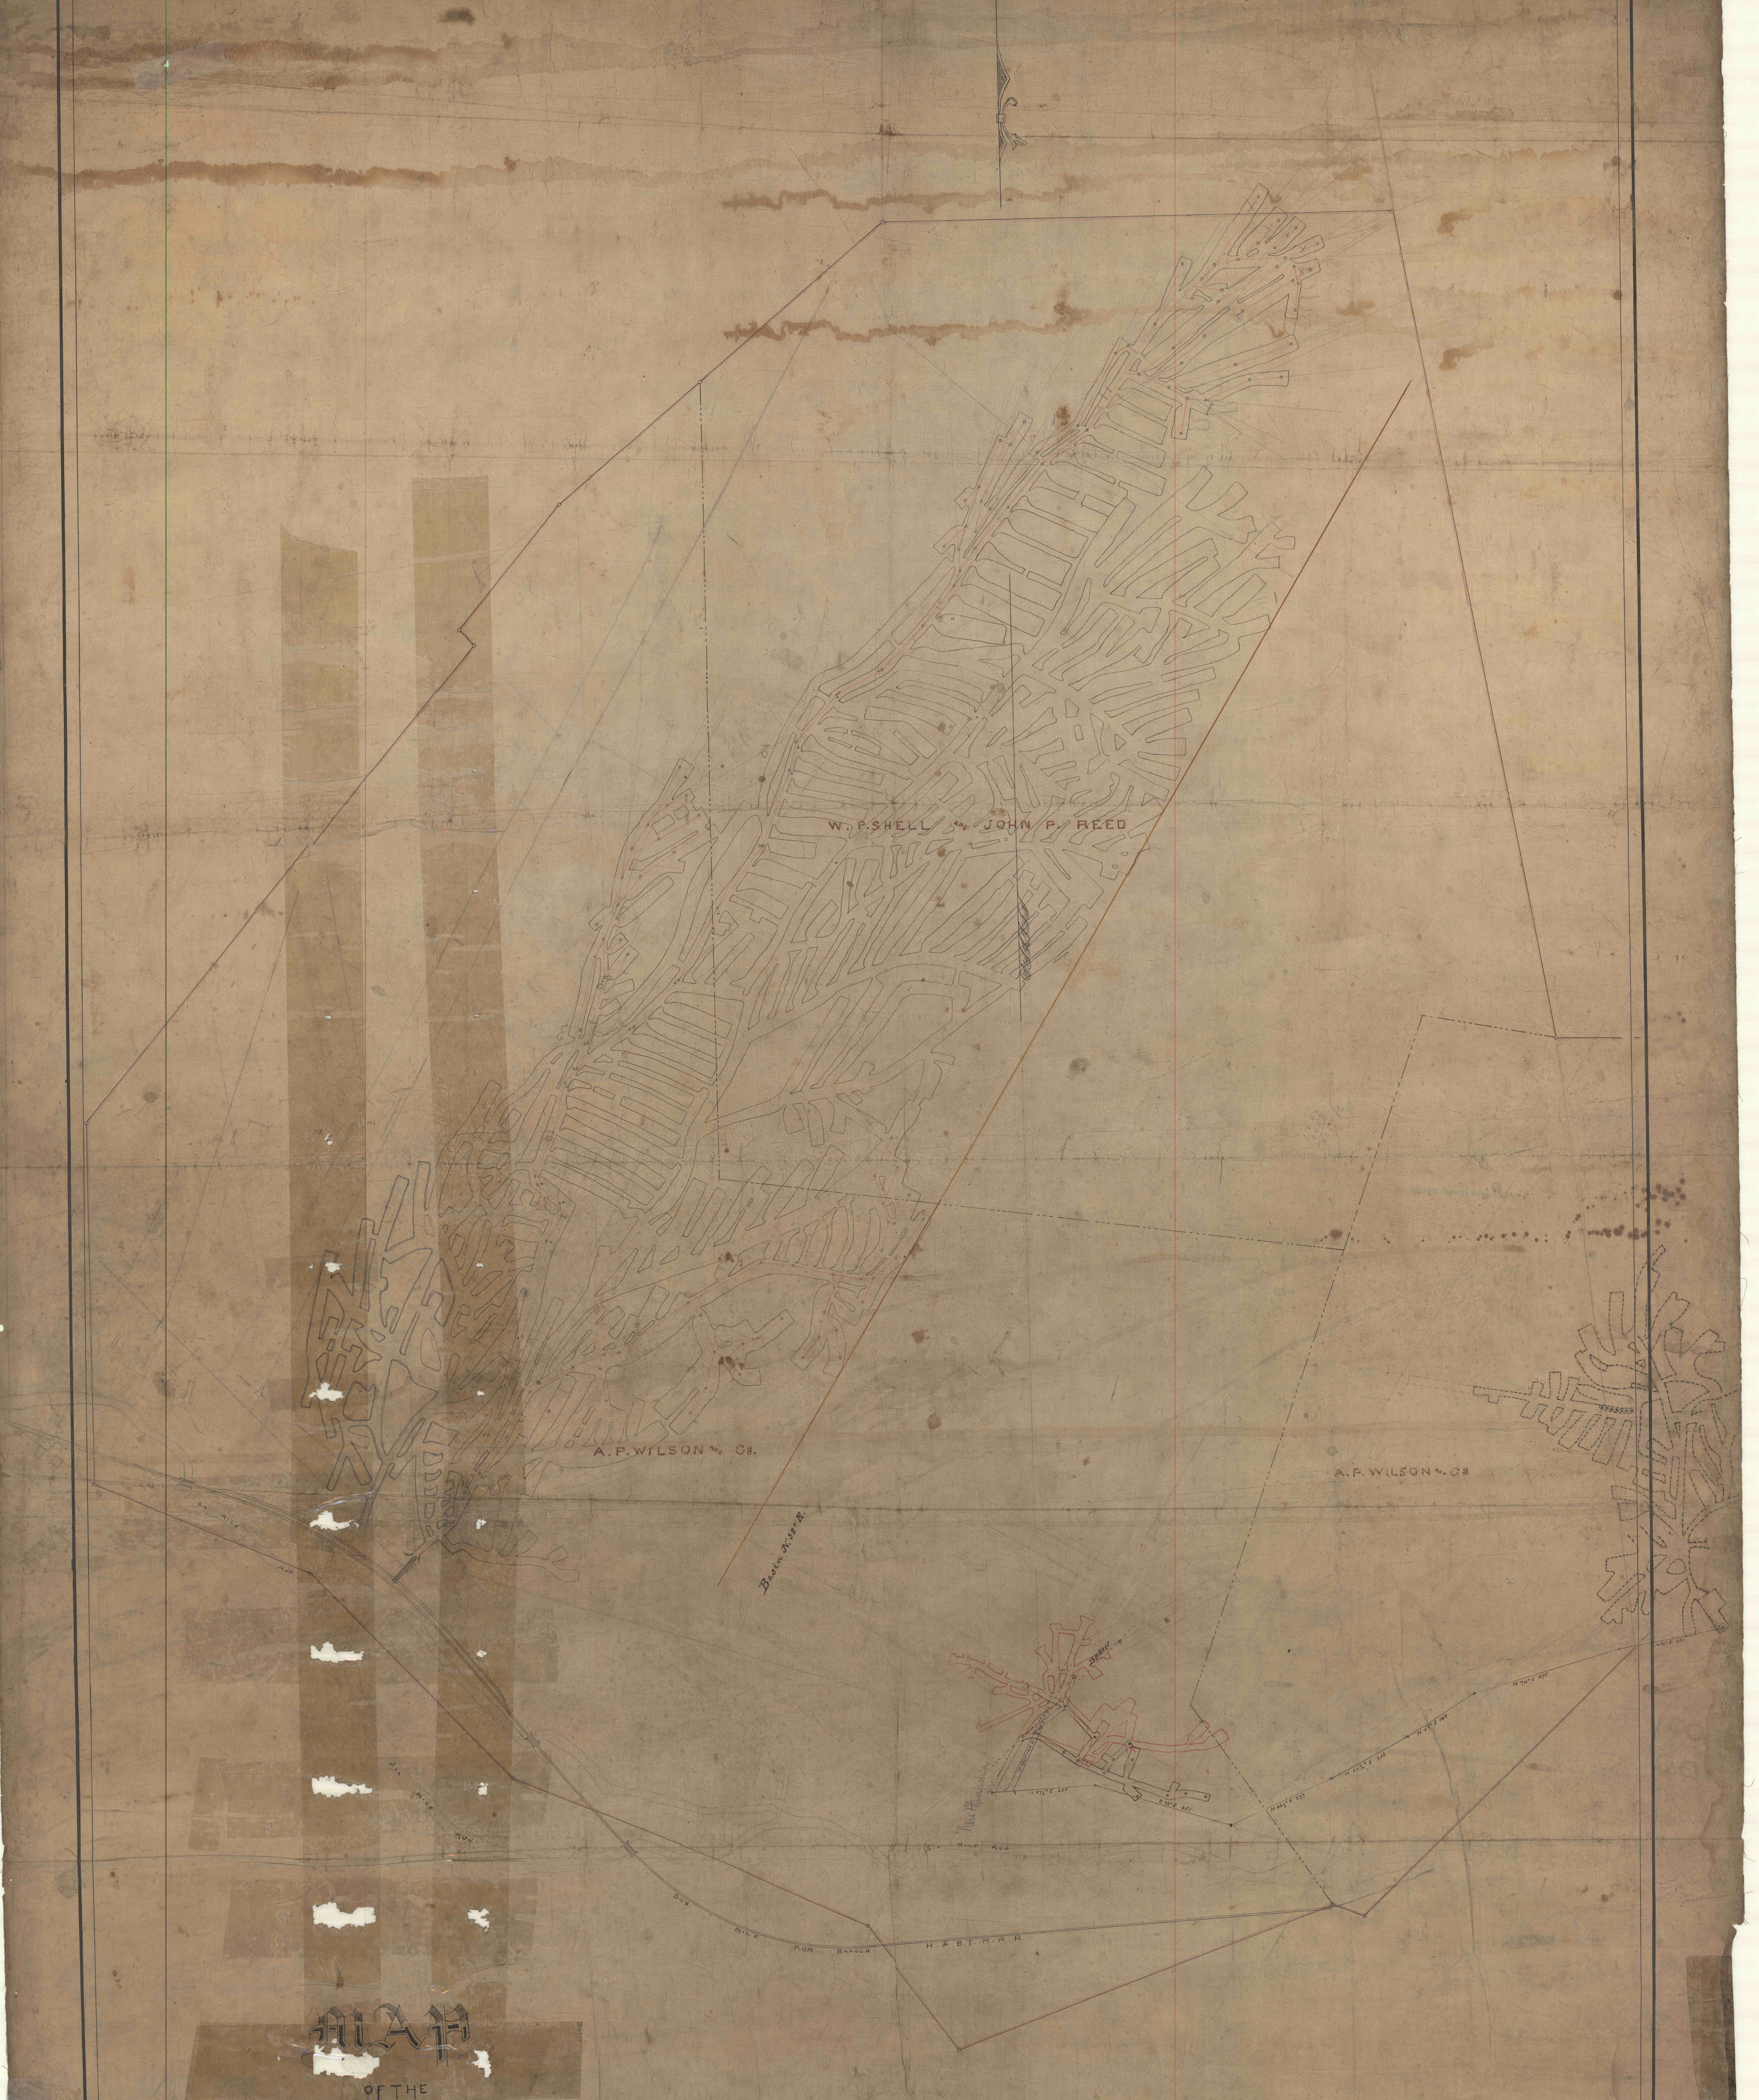

MAP

OF THE

New Hampshier Mine

IN

BEDFORD COUNTY

THE PROPERTY OF

WHITEHEAD AND CO.

Scale 100 ft = 1 inch.

Spencer & Fraser. Engrs.