

# MAP OLD WORKINGS ON KELLY SEAM E. EICHELBERGER & CO.


BROADTOP TOWNSHIP — BEDFORD COUNTY  
Scale: 1" = 100'

1944

AND NEW WORKINGS OF BACON No. 7  
OPERATED BY: MARTIN, MCKINTY, REA & MCKNIGHT (1950)

Revised to: 1964  
OPERATED BY: HERMAN M. CLEVENGER (1964)


Note: Kelly Seam workings shown on this map were traced from old maps by C. S. KERRY, R. H. ROY, et al, furnished by George Eichelberger 7-3-44.

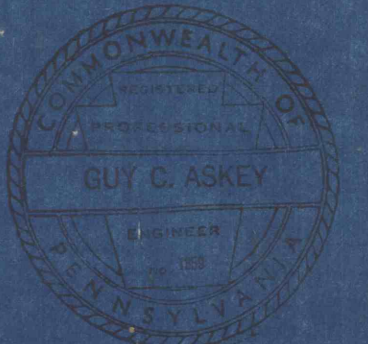

RIDDLESBURG MATERIALS CORP.

E. EICHELBERGER & CO.  
Wigton Tract

LANGDON COAL CO.

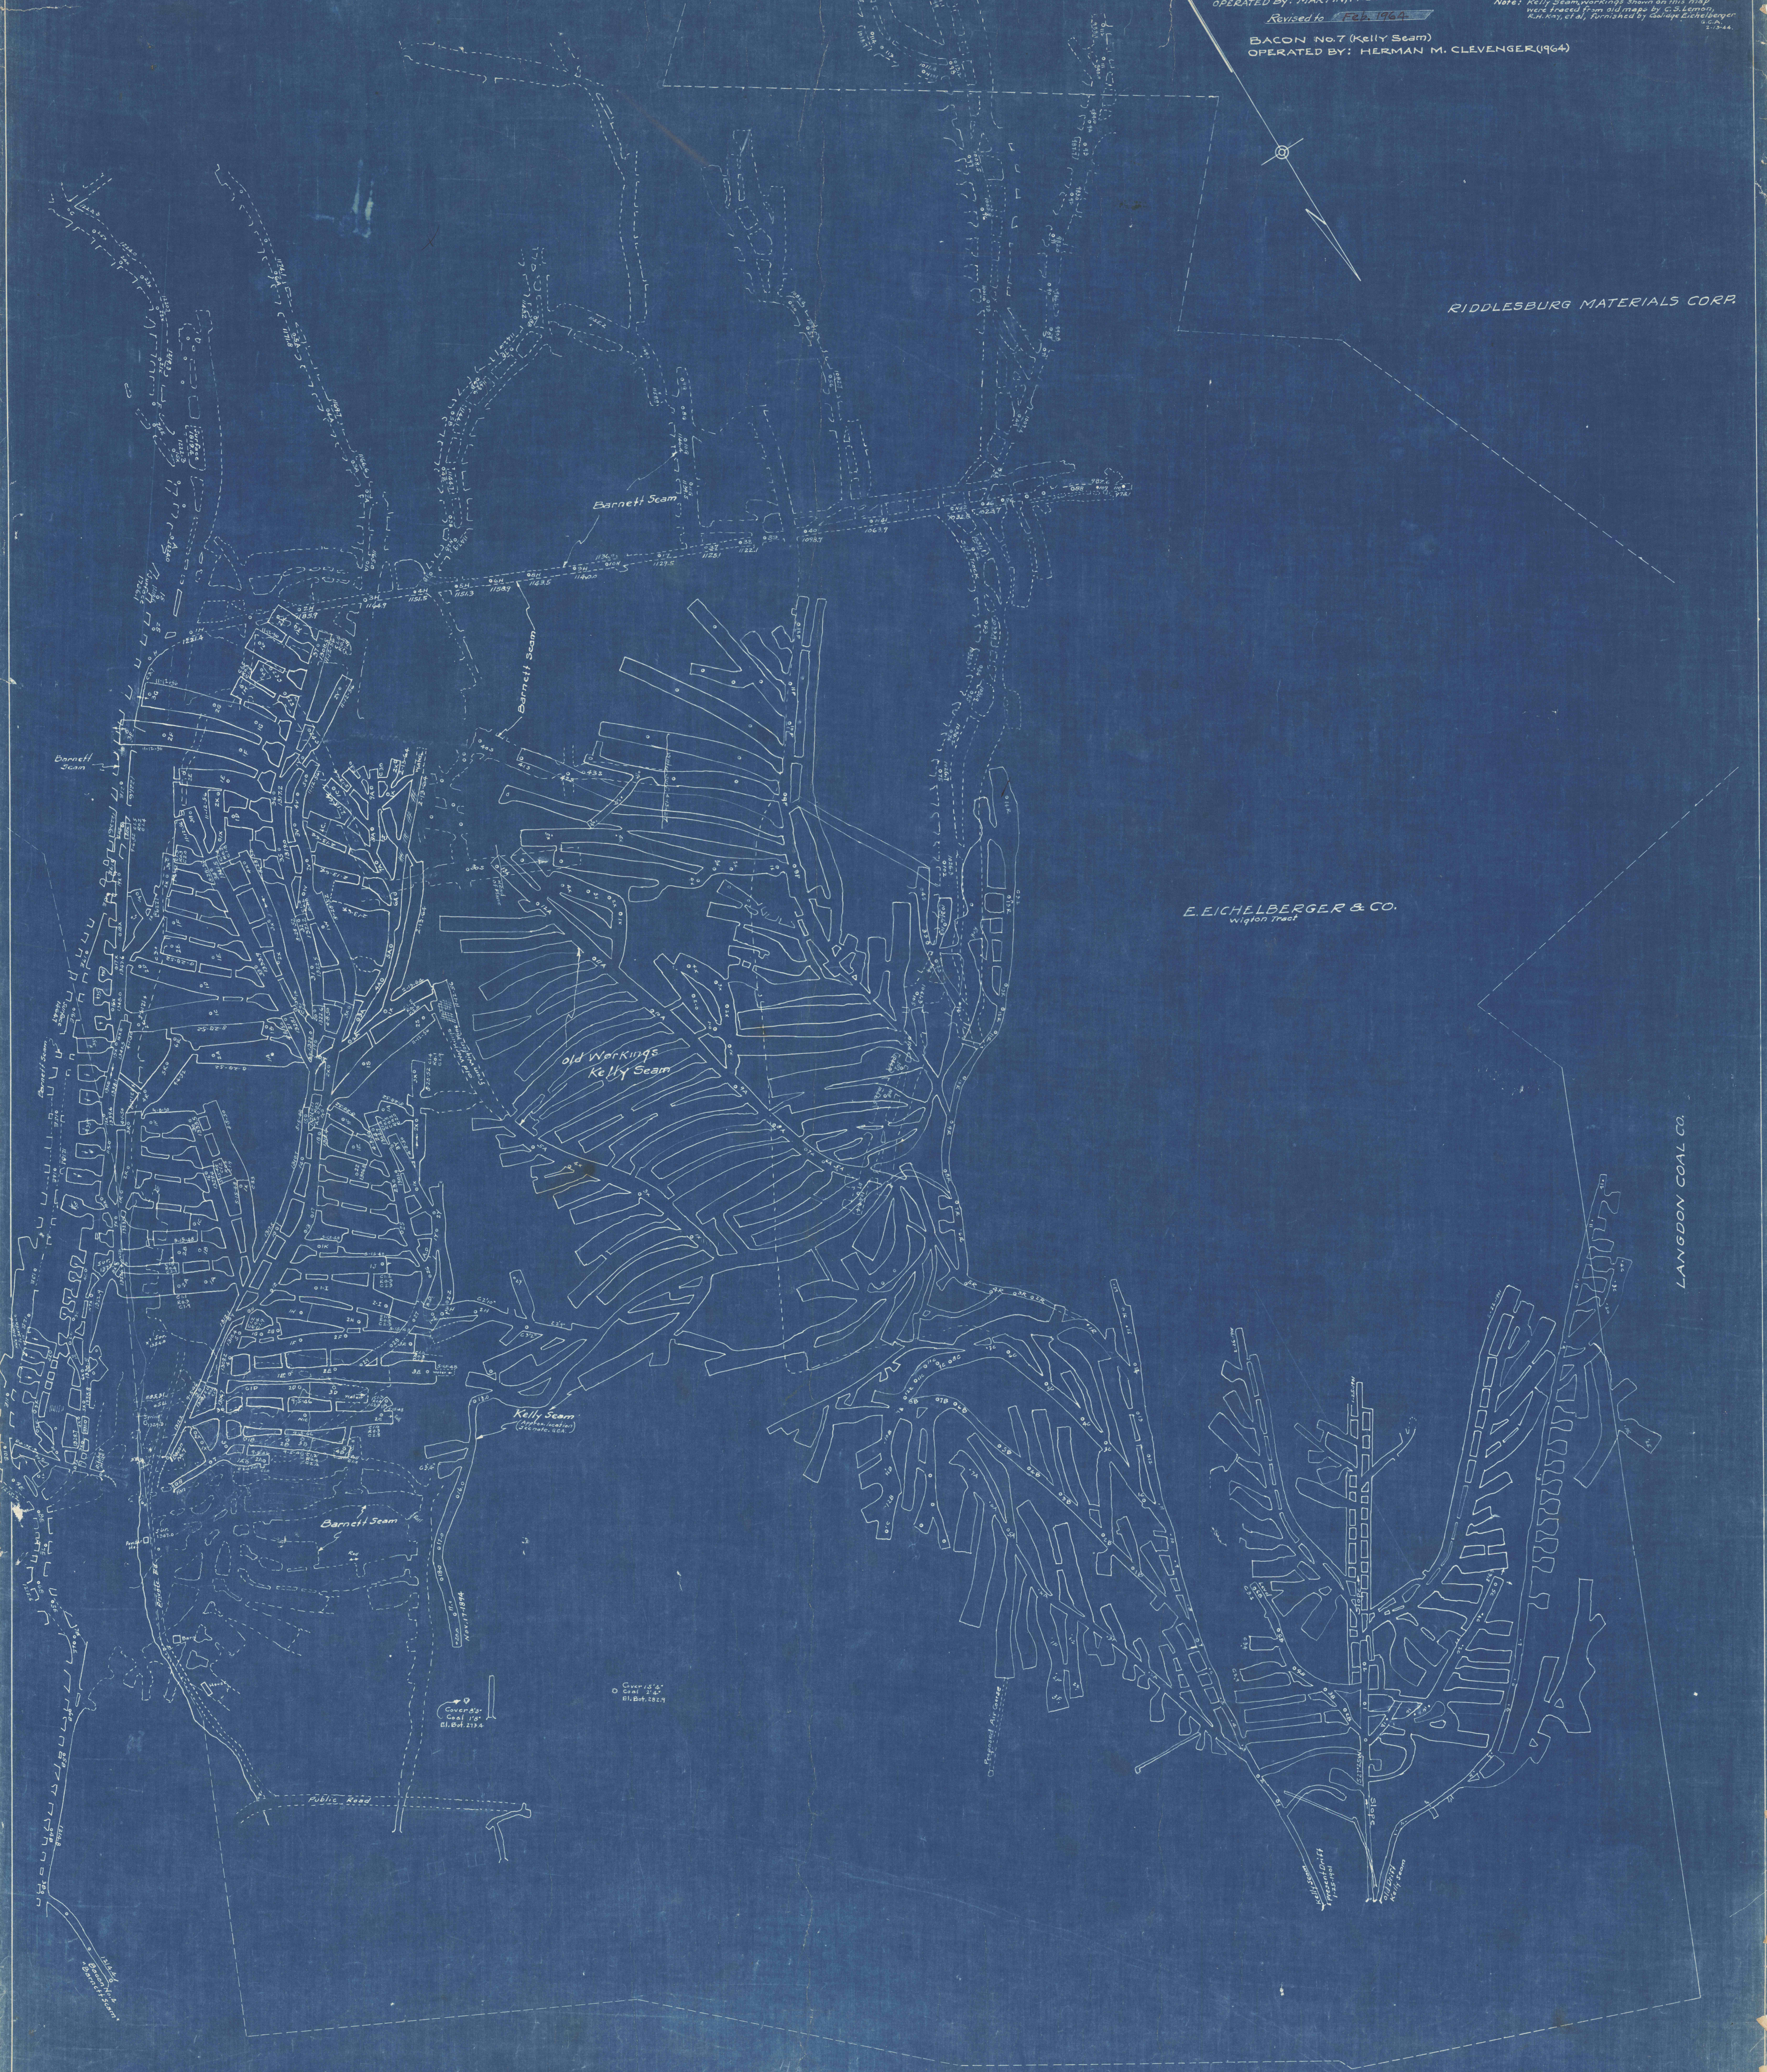

Cover 254  
Coal 194  
Bl. Bol. 2174

Cover 254  
Coal 194  
Bl. Bol. 2174

Public Road