

FINLEY MAN MINES
Operated on lands of
SIX MILE RUN COAL CO.

BEDFORD COUNTY, PENNSYLVANIA.


P. E. Womelsdorf, Mining Engineer.

G. F. Dierker, Assistant Engineer.

SCALE 1 INCH = 100 FEET.

1910

*Note: All property lines on this map were surveyed
and taken from old deed maps.*

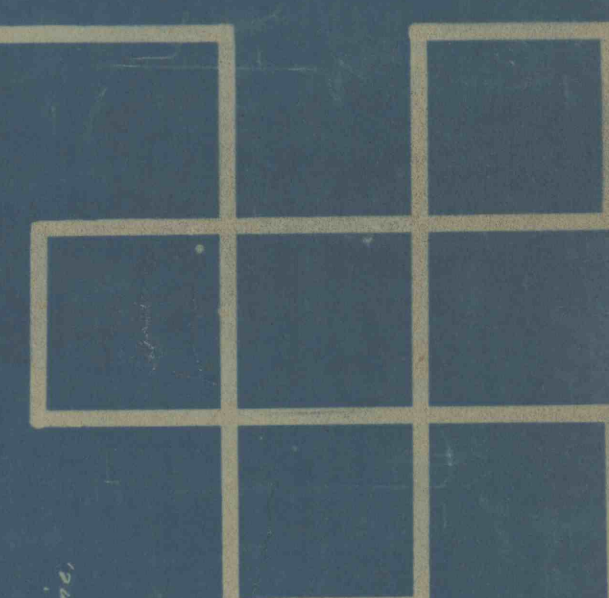

H. & B. T. R. R. Co.

*Surveyed by P. E. Womelsdorf, Mining Engineer.
G. F. Dierker, Assistant Engineer.
Bedford County, Pa.
1910.*