


4041.9
JULY 1913

4041.8
JULY 1913

4041.3
JULY 1913

4041.10
JULY 1913

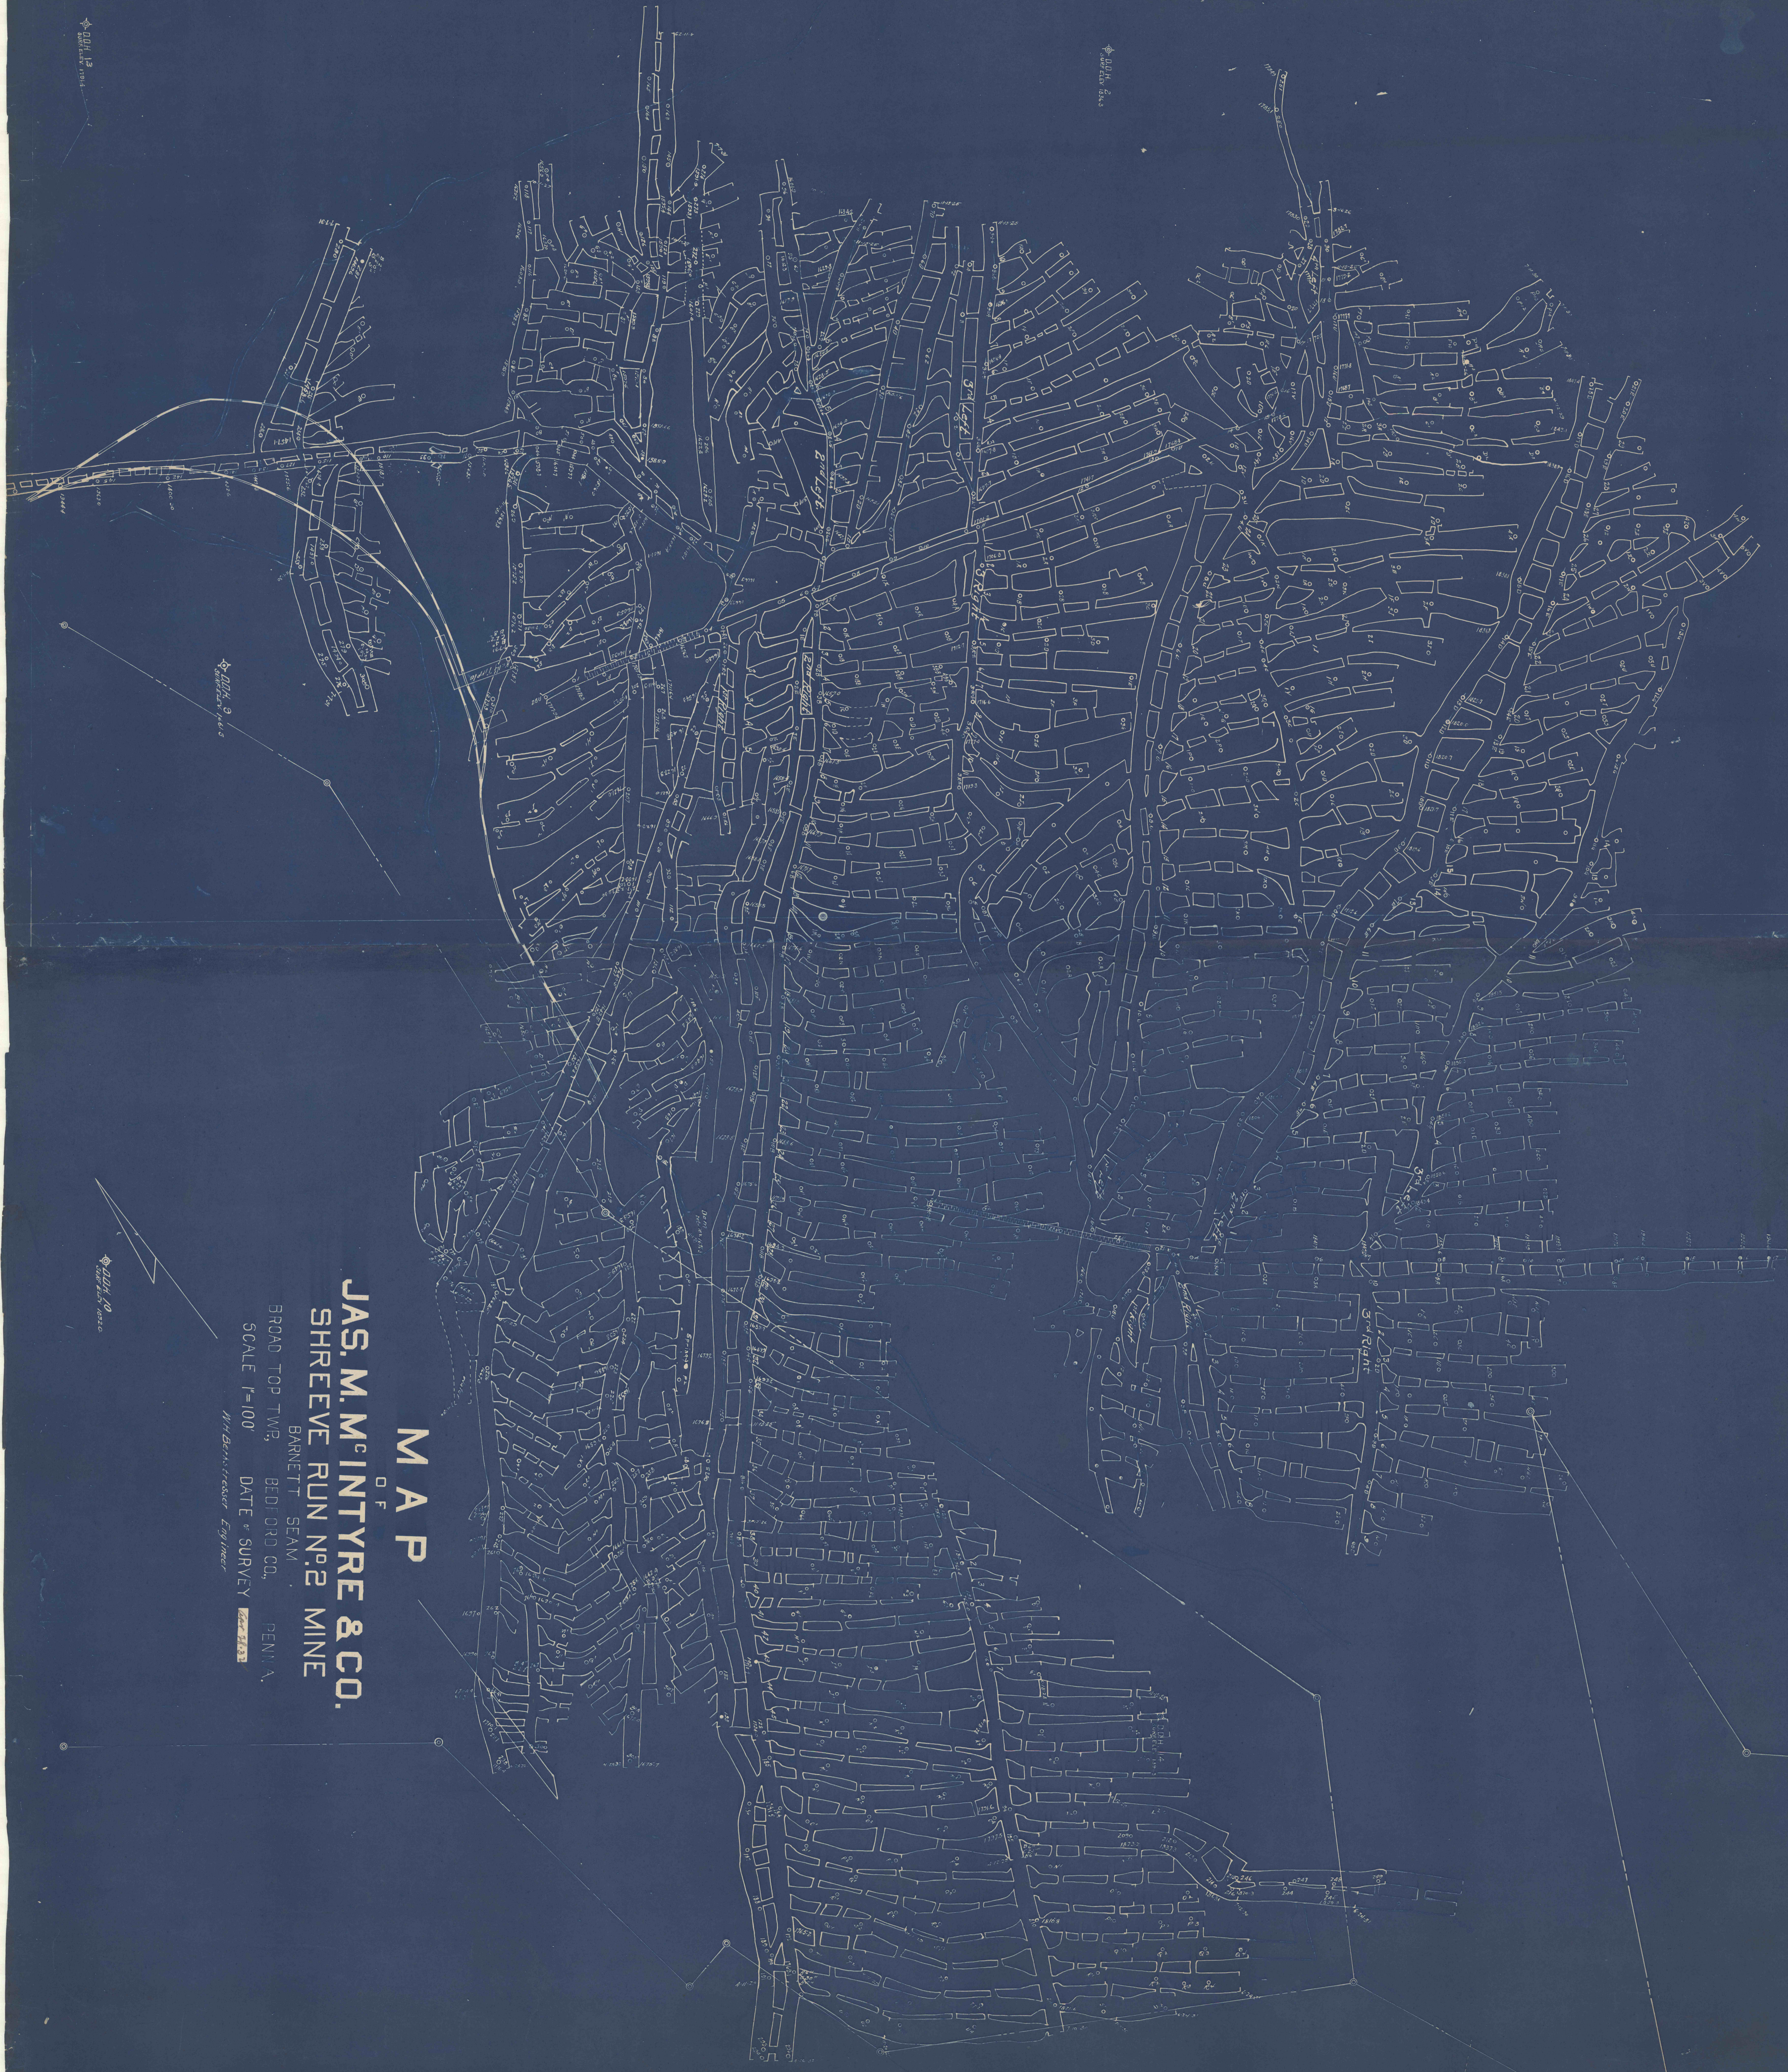

MAP
 OF
JAS. M. MCINTYRE & CO.
SHREEVE RUN NO. 2 MINE
 BARNETT SEAM
 BROAD TOP TWS, BEDFORD CO., PENN'A.
 SCALE 1"=100' DATE OF SURVEY 1913
 Wm. Bennett, Engineer