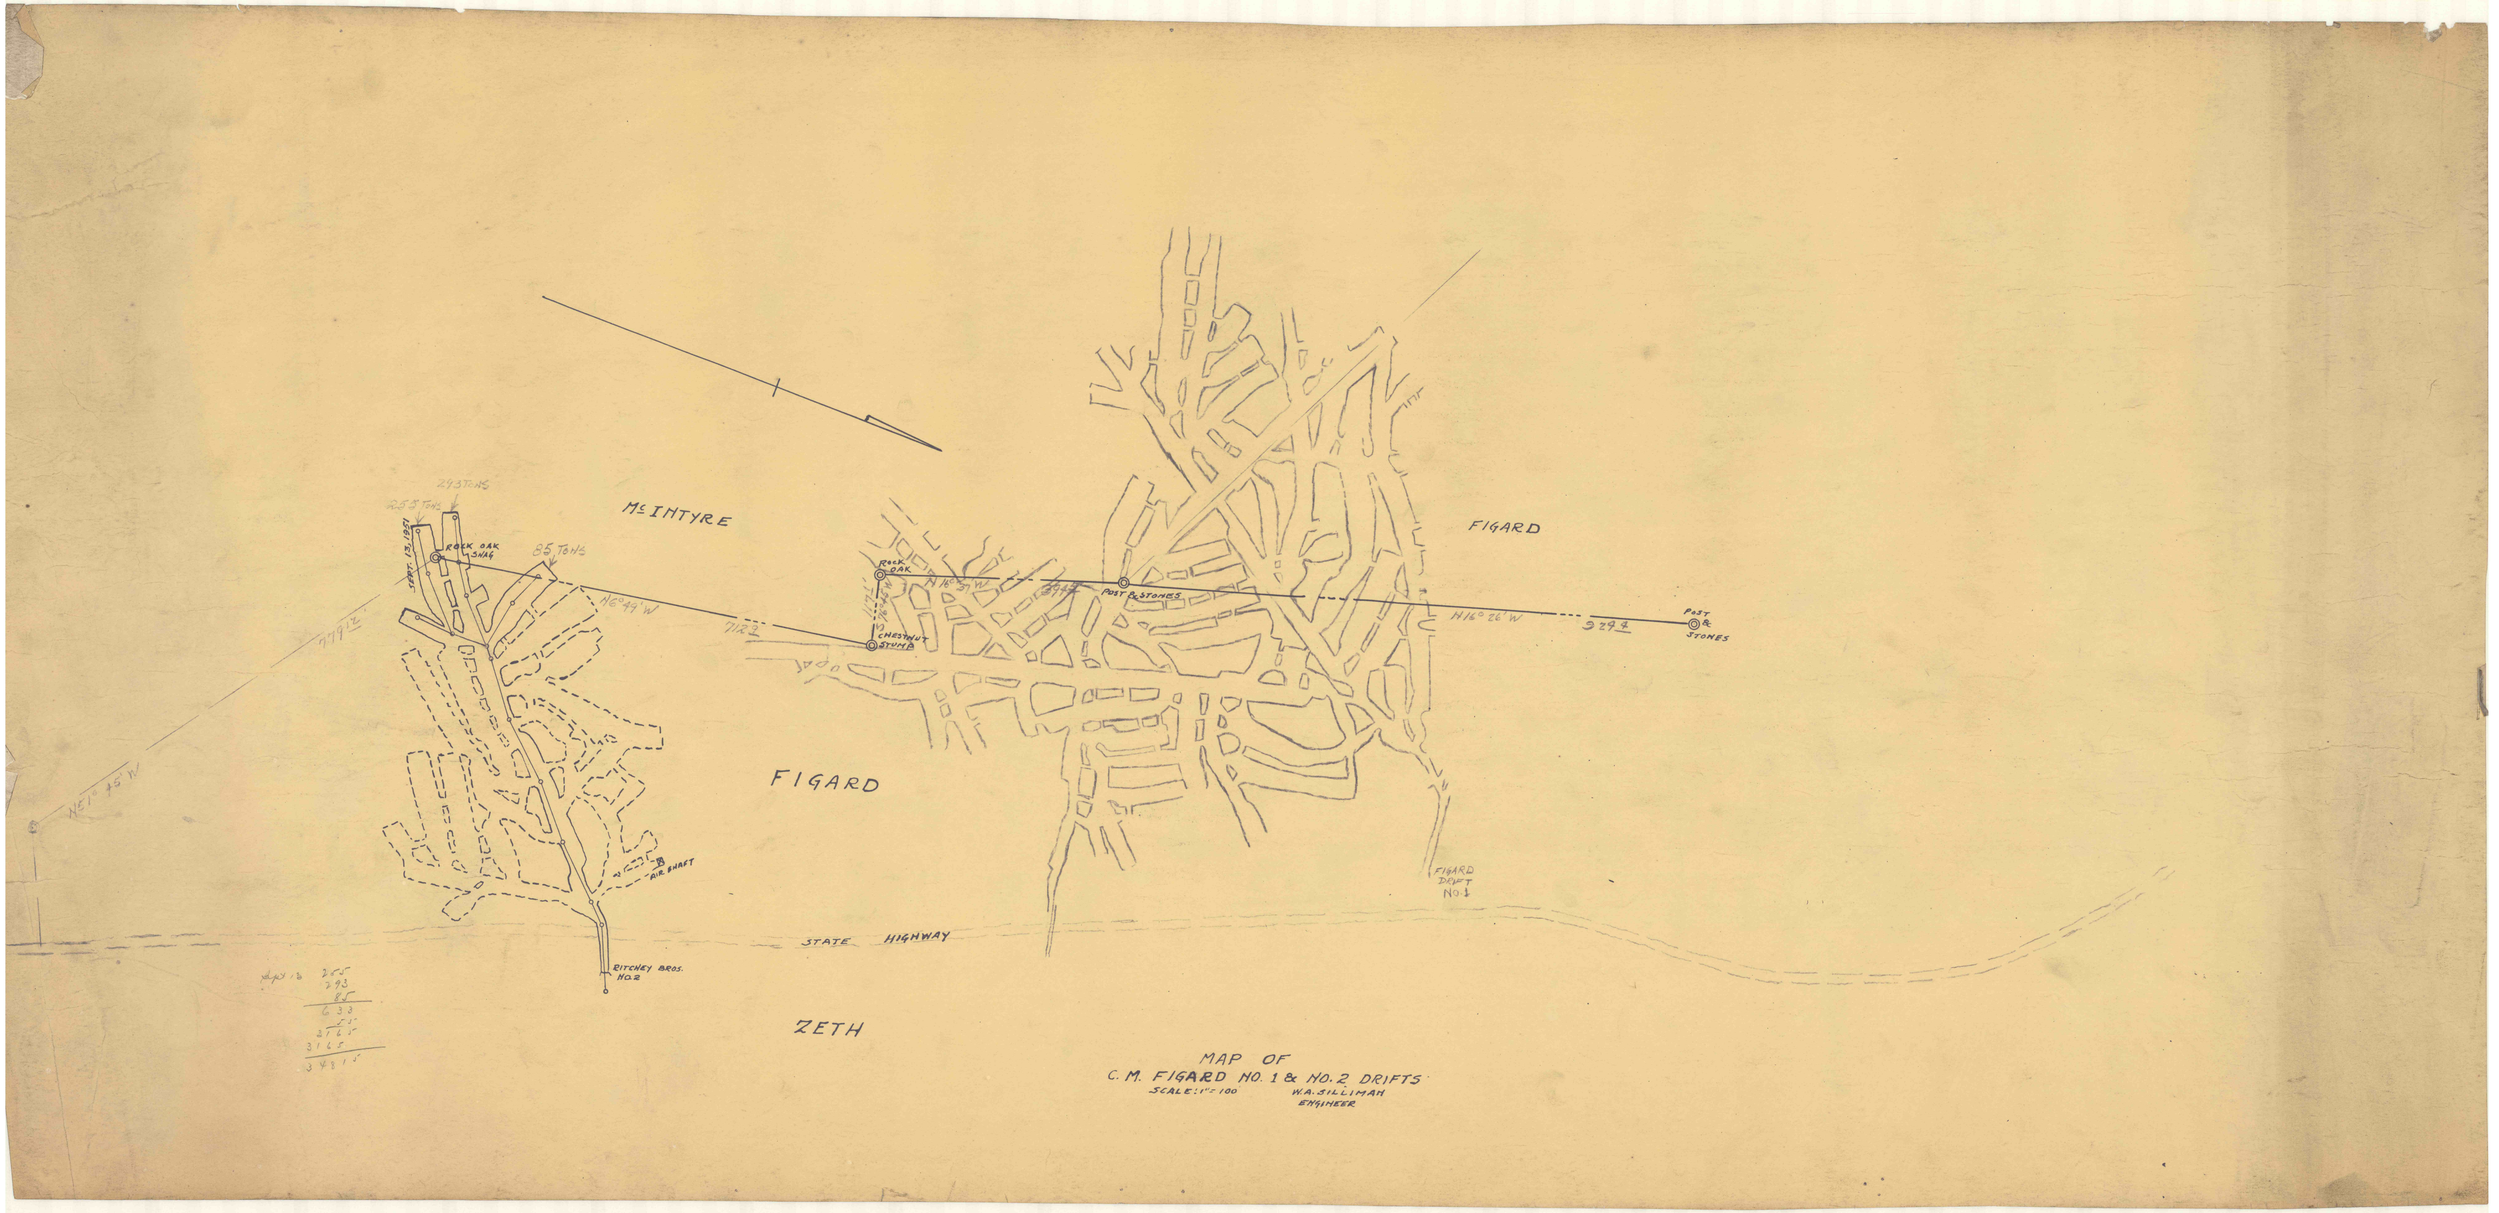
McINTYRE
FIGARD
FIGARD
ZETH
ROCK OAK SNAG
85 TONS
293 TONS
255 TONS
SEPT. 13, 1951
N16°49'W
712'
N16°51'W
N16°26'W
3294'
3779'
NE1°45'W
ROCK OAK
CHESTNUT STUMP
POST & STONES
POST & STONES
OAK
OAK
FIGARD DRIFT NO.1
AIR SHAFT
RITCHEY BROS. NO.2
STATE HIGHWAY
MAP OF
C. M. FIGARD NO. 1 & NO. 2 DRIFTS
SCALE: 1" = 100
W.A. SILLIMAN
ENGINEER