


Map Showing Barnett Workings on W.M. McIntyre Property in Broad Top Twp. Bedford County Penna. July 1926  
1"=100' E. Gernie Engr.

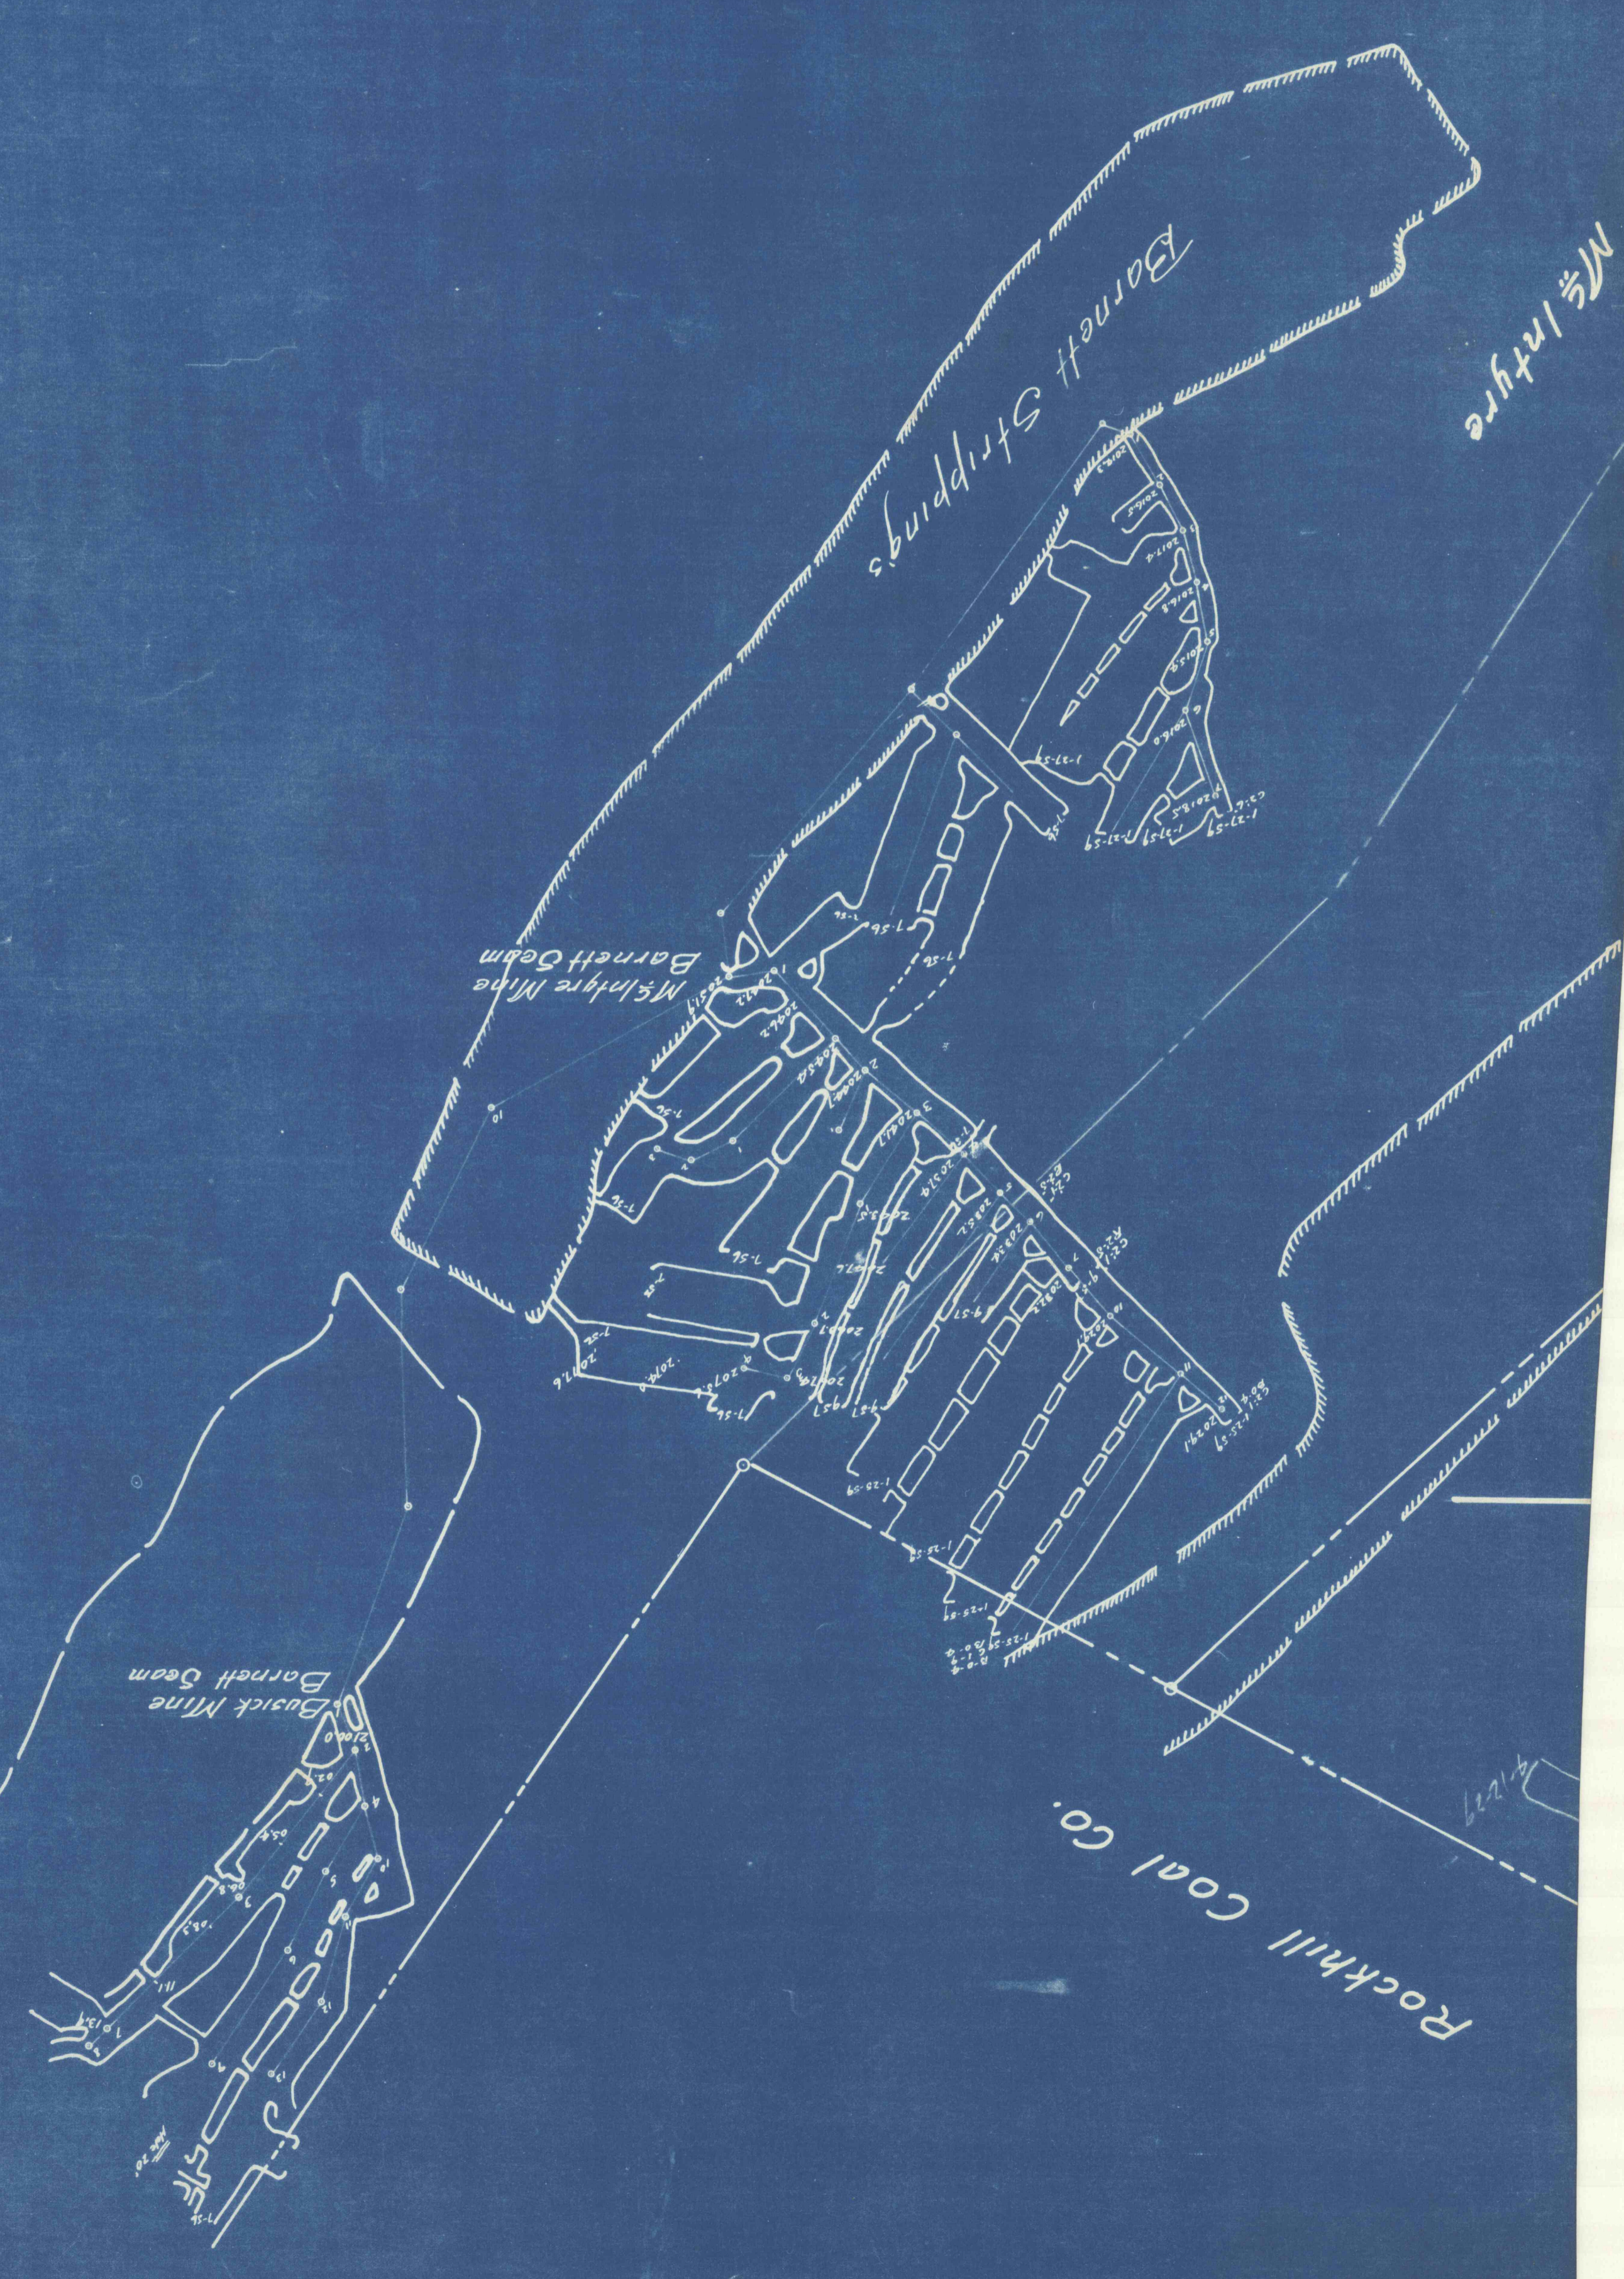

Rockhill Coal Co.