
 
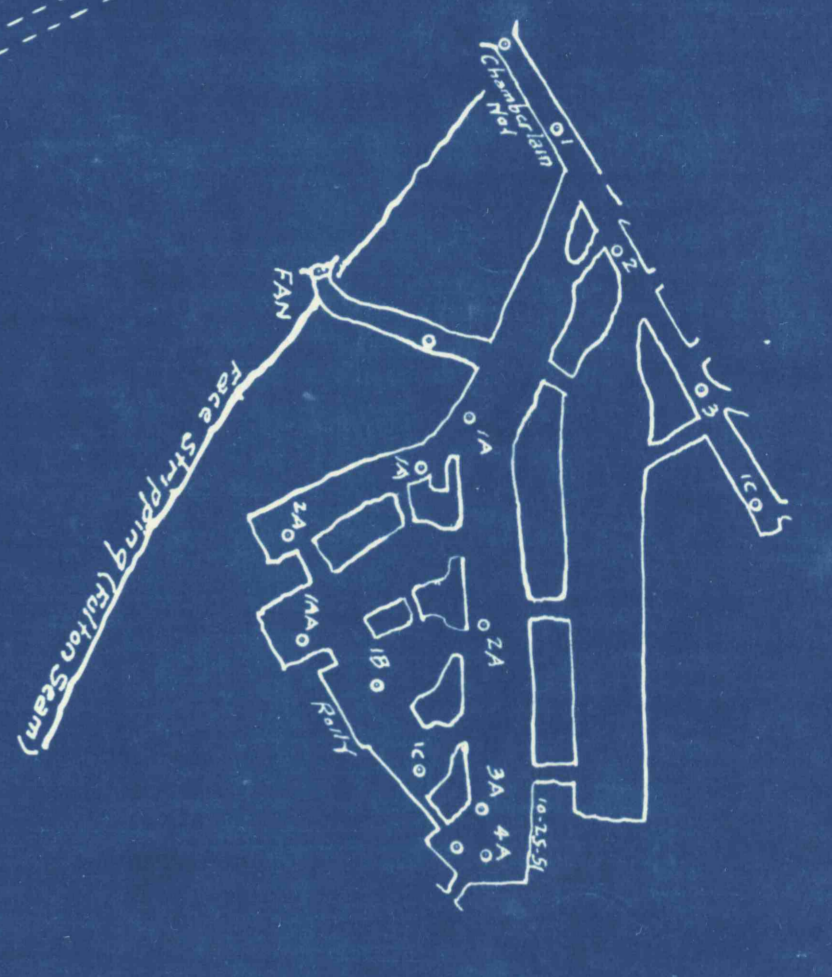


# BROAD TOP NO. 1

OWNED AND OPERATED BY  
**WARREN H. REED**  
CARBON TOWNSHIP-HUNTINGDON COUNTY  
Scale 1"=100'

— 1984 —  
GUY S. ASKEY P.E.  
Bedford, Pa.

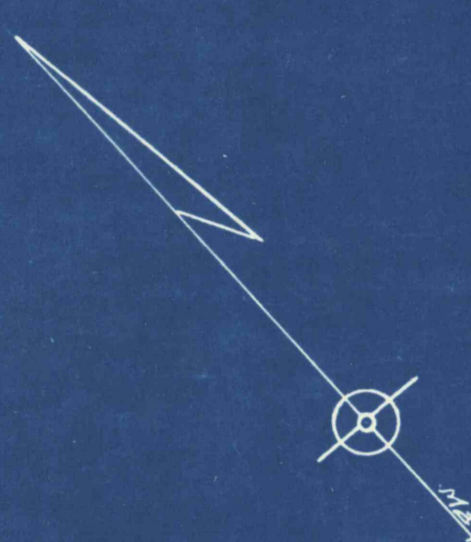

HARRY C. MCCLAIN

WARREN H. REED

HARRY C. MCCLAIN

WARREN H. REED

Note - Old workings of Barnett and Fulton Seams were traced from a blue print of 1903 to 1916 by P.E. Wm. McDowell and G. H. Dunlap with respect to the Barnett area.

Approx. Hillside Road