


H. & B. T. R. R. CO.

MAP of MILLER MINES

COALMONT, HUNTINGDON CO., PENNA.
APRIL 24, 1906
Sept. 29, 1906

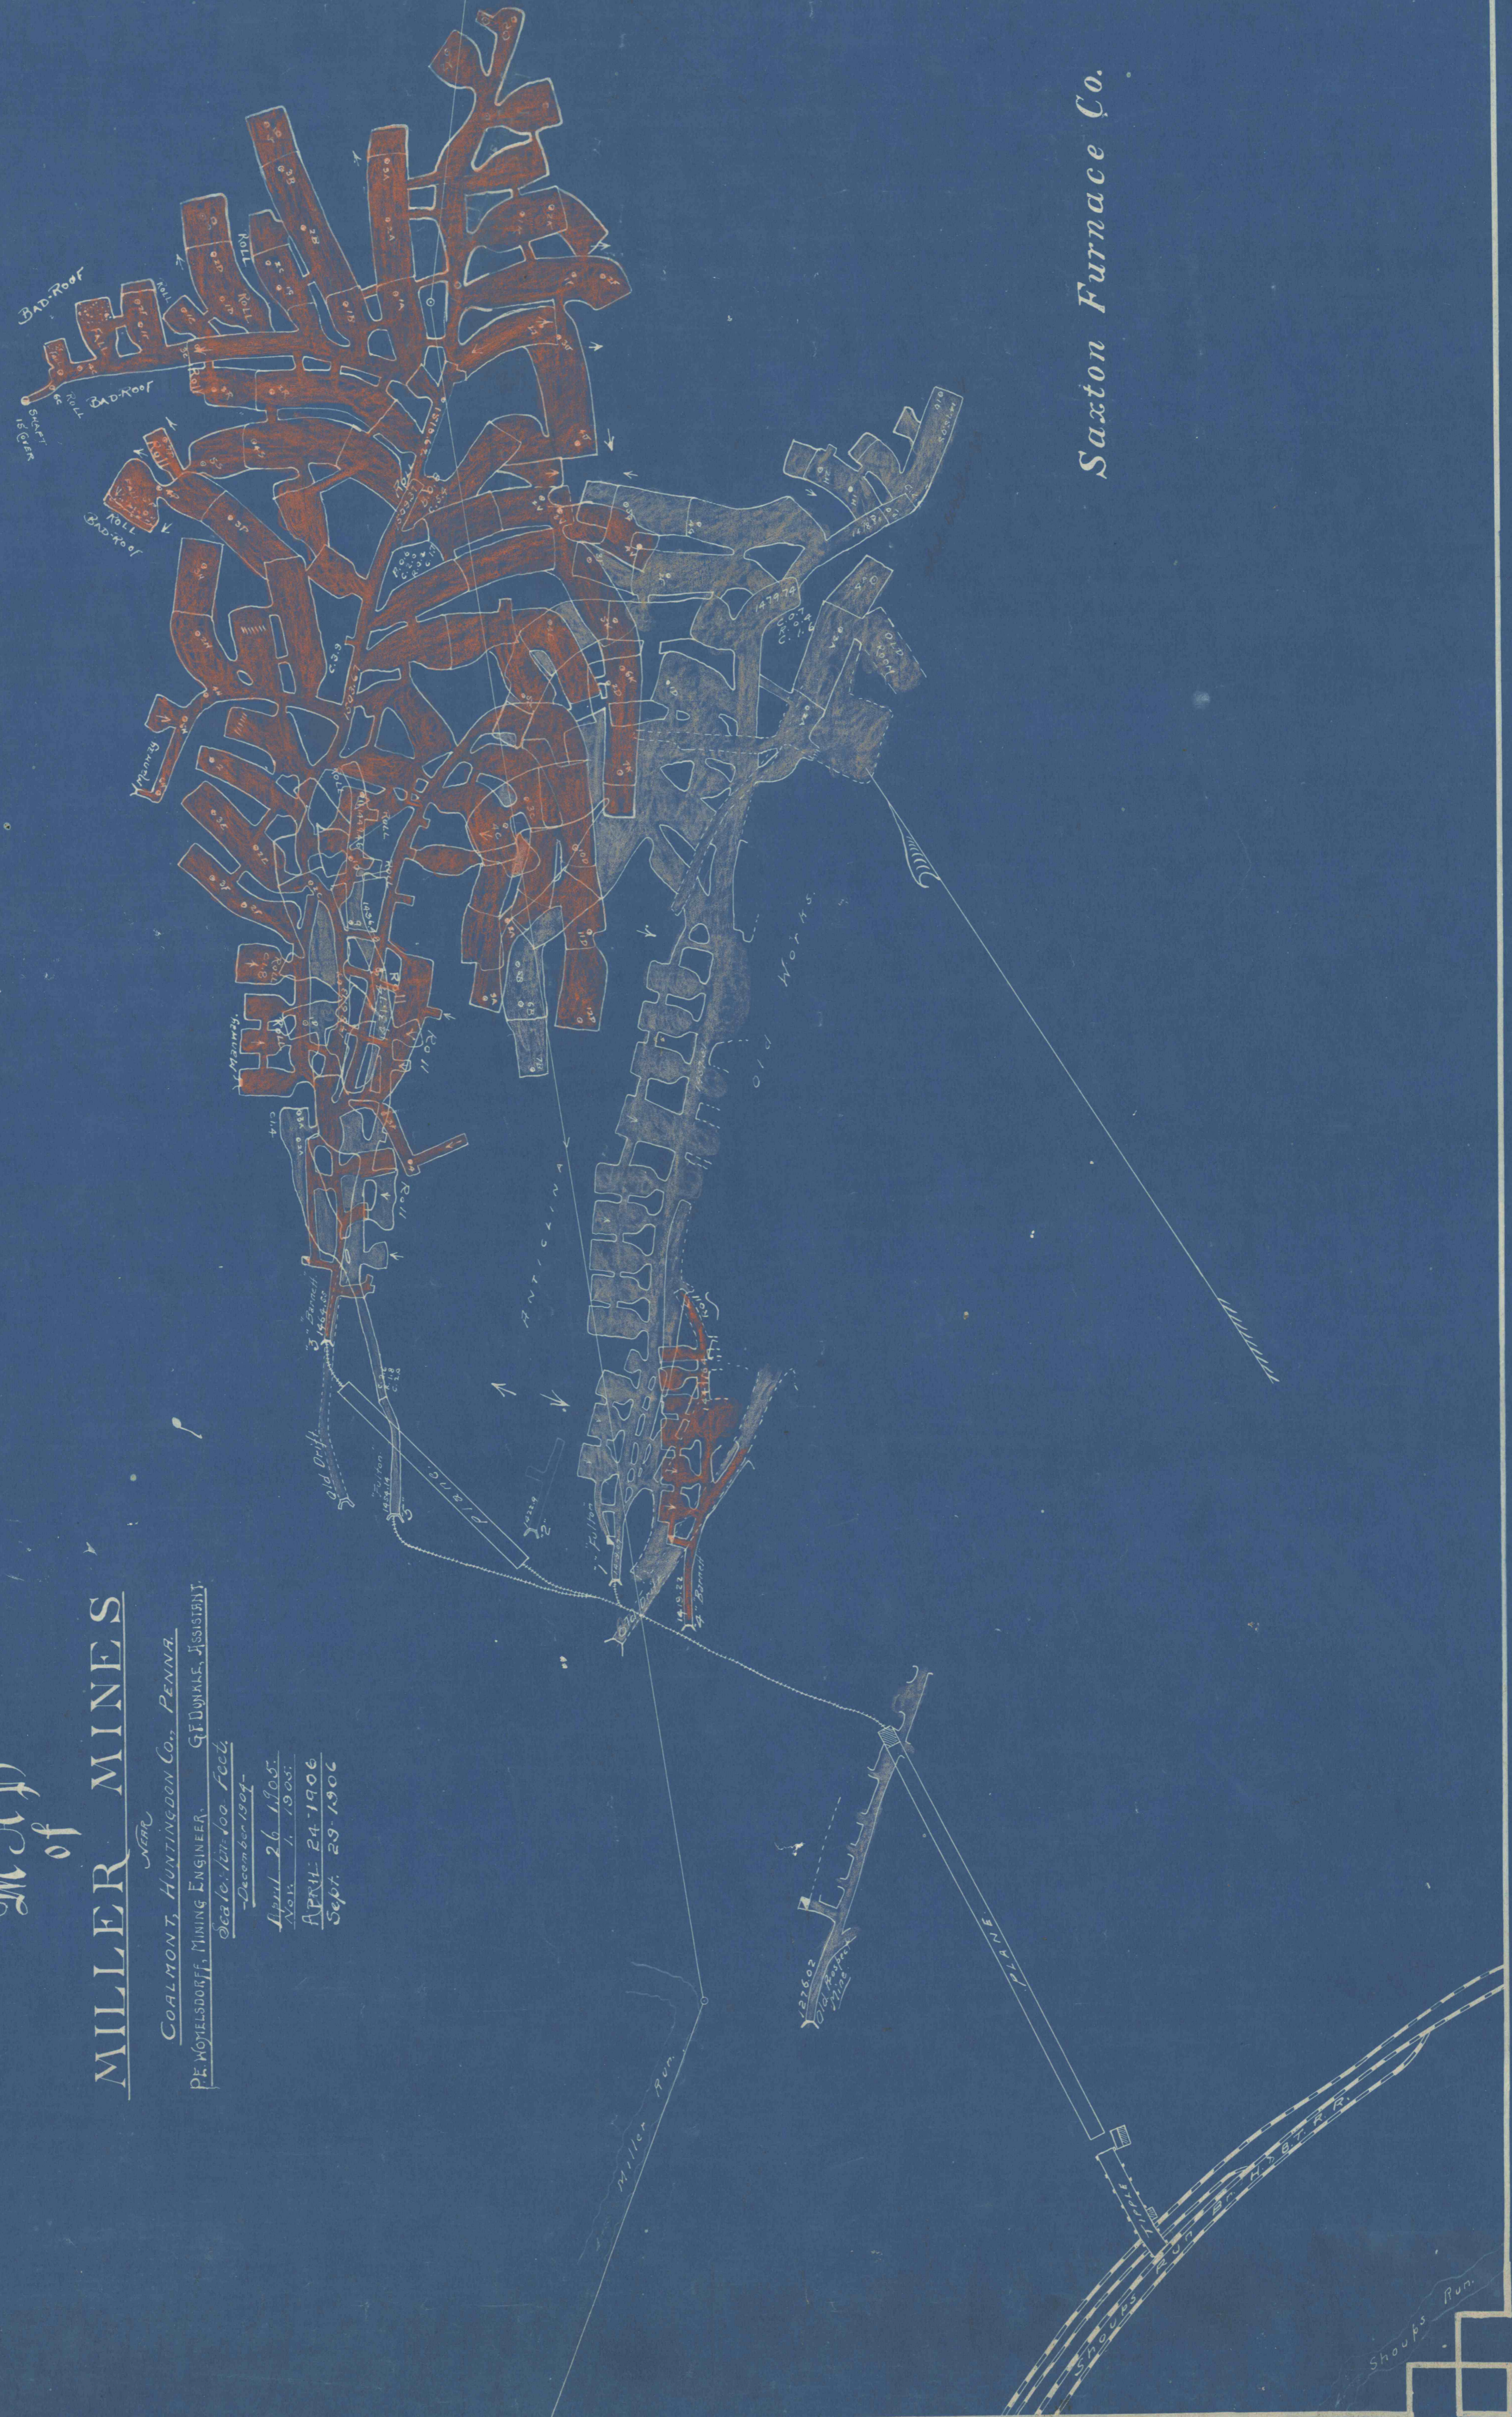

Saxton Furnace Co.