
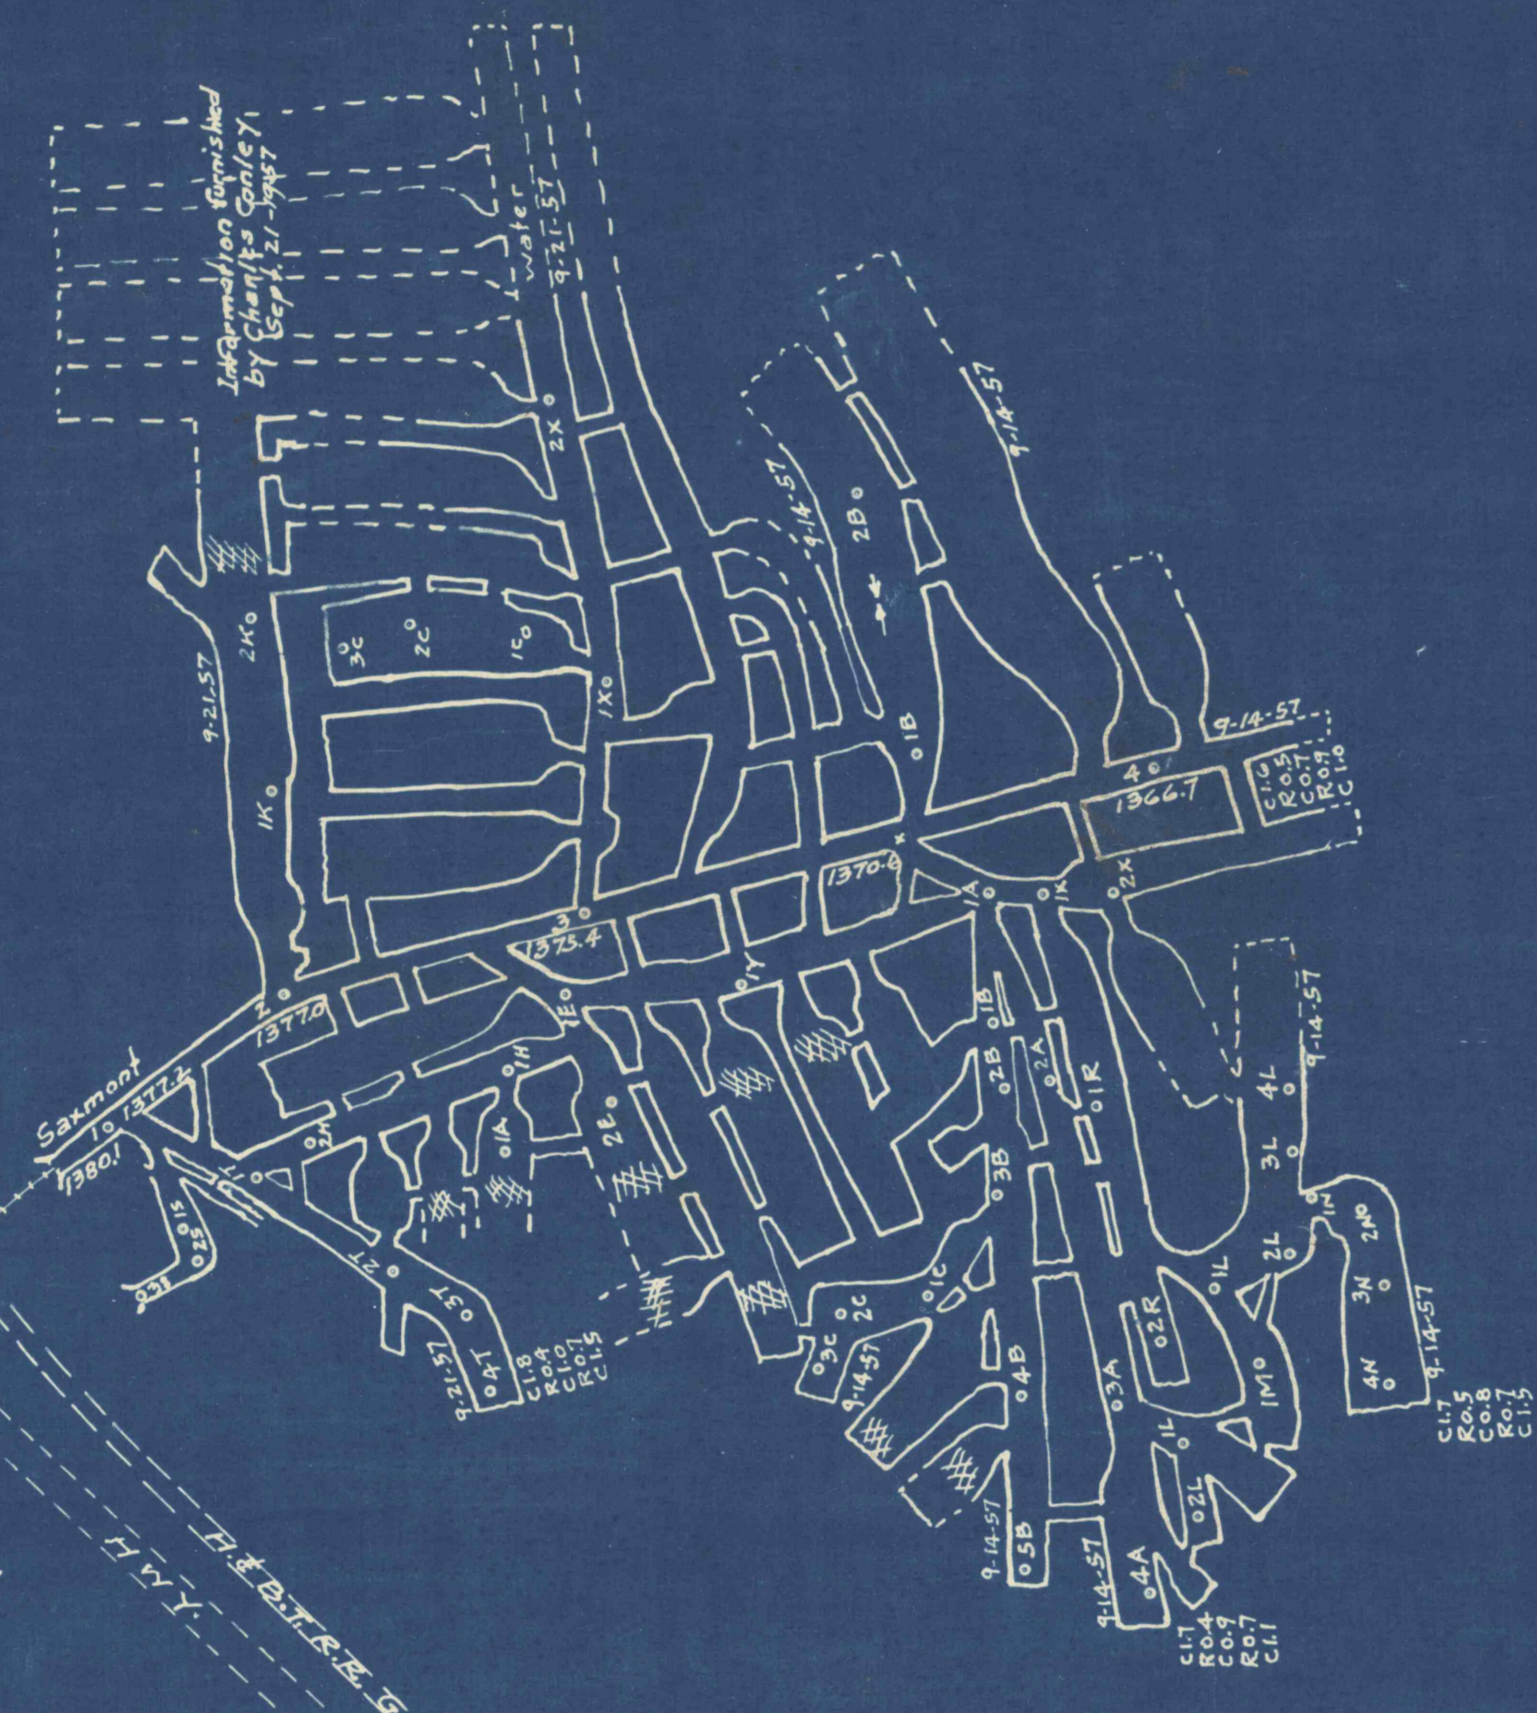


LENORE COAL CO.
(Mining Rights 1914)

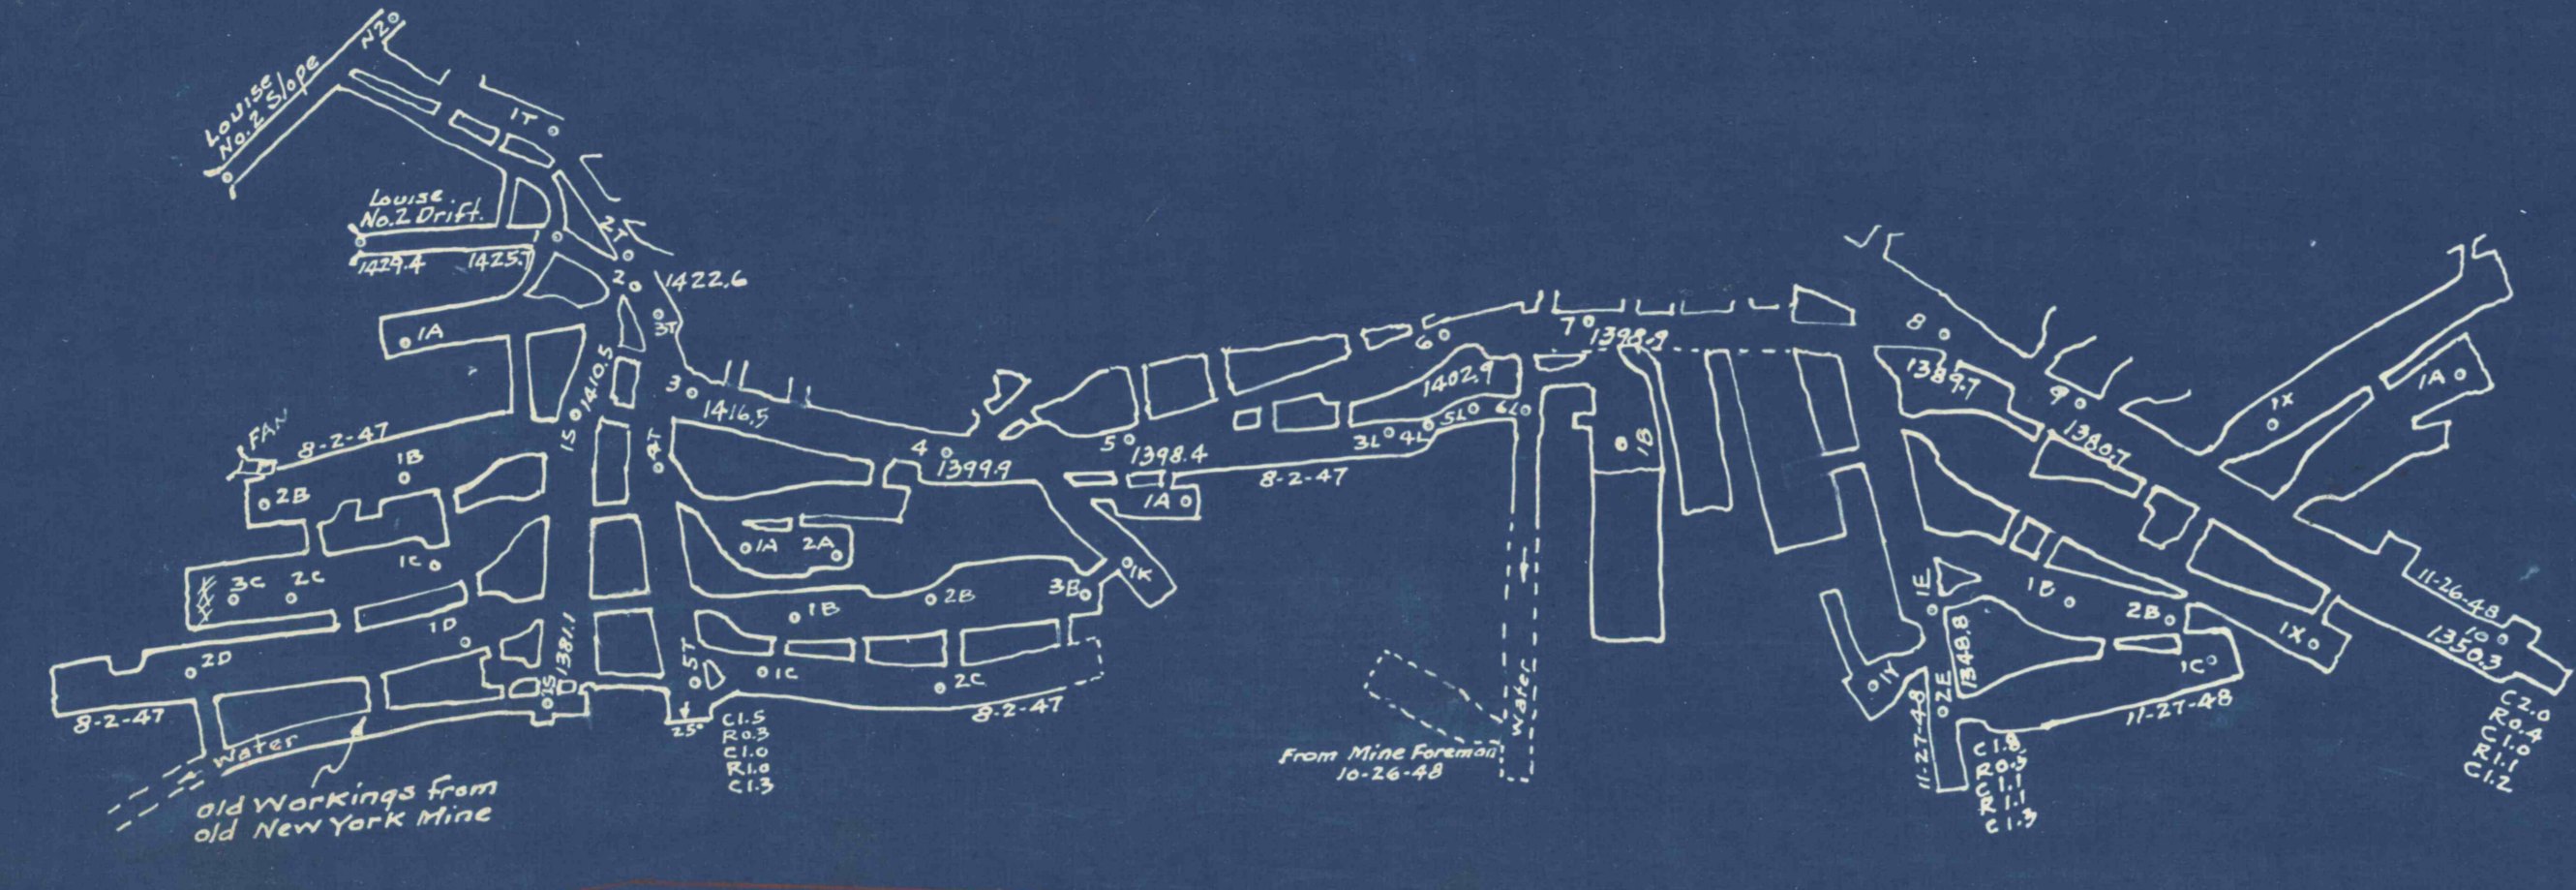

WILLIAM W. REED
(John Hamilton Tract)

NEW ENTERPRISE STONE & LIME CO.
(Mining Rights 1914)

JOHN LANGDON EST.

WILDAY GRACE COAL CO.

SAXMONT MINE


Operated by
CONLEY BROTHERS COAL CO.
BROAD TOP TWP - BEDFORD CO. PA.

Scale: 1"=100'

- 1957 -

Guy C. Askey, Min. Engr.
Bedford, Pa.

Revised to 9-21-57

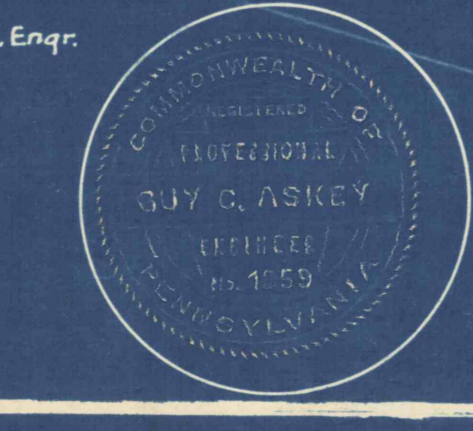

old New York mine

Approx. location

Mined out