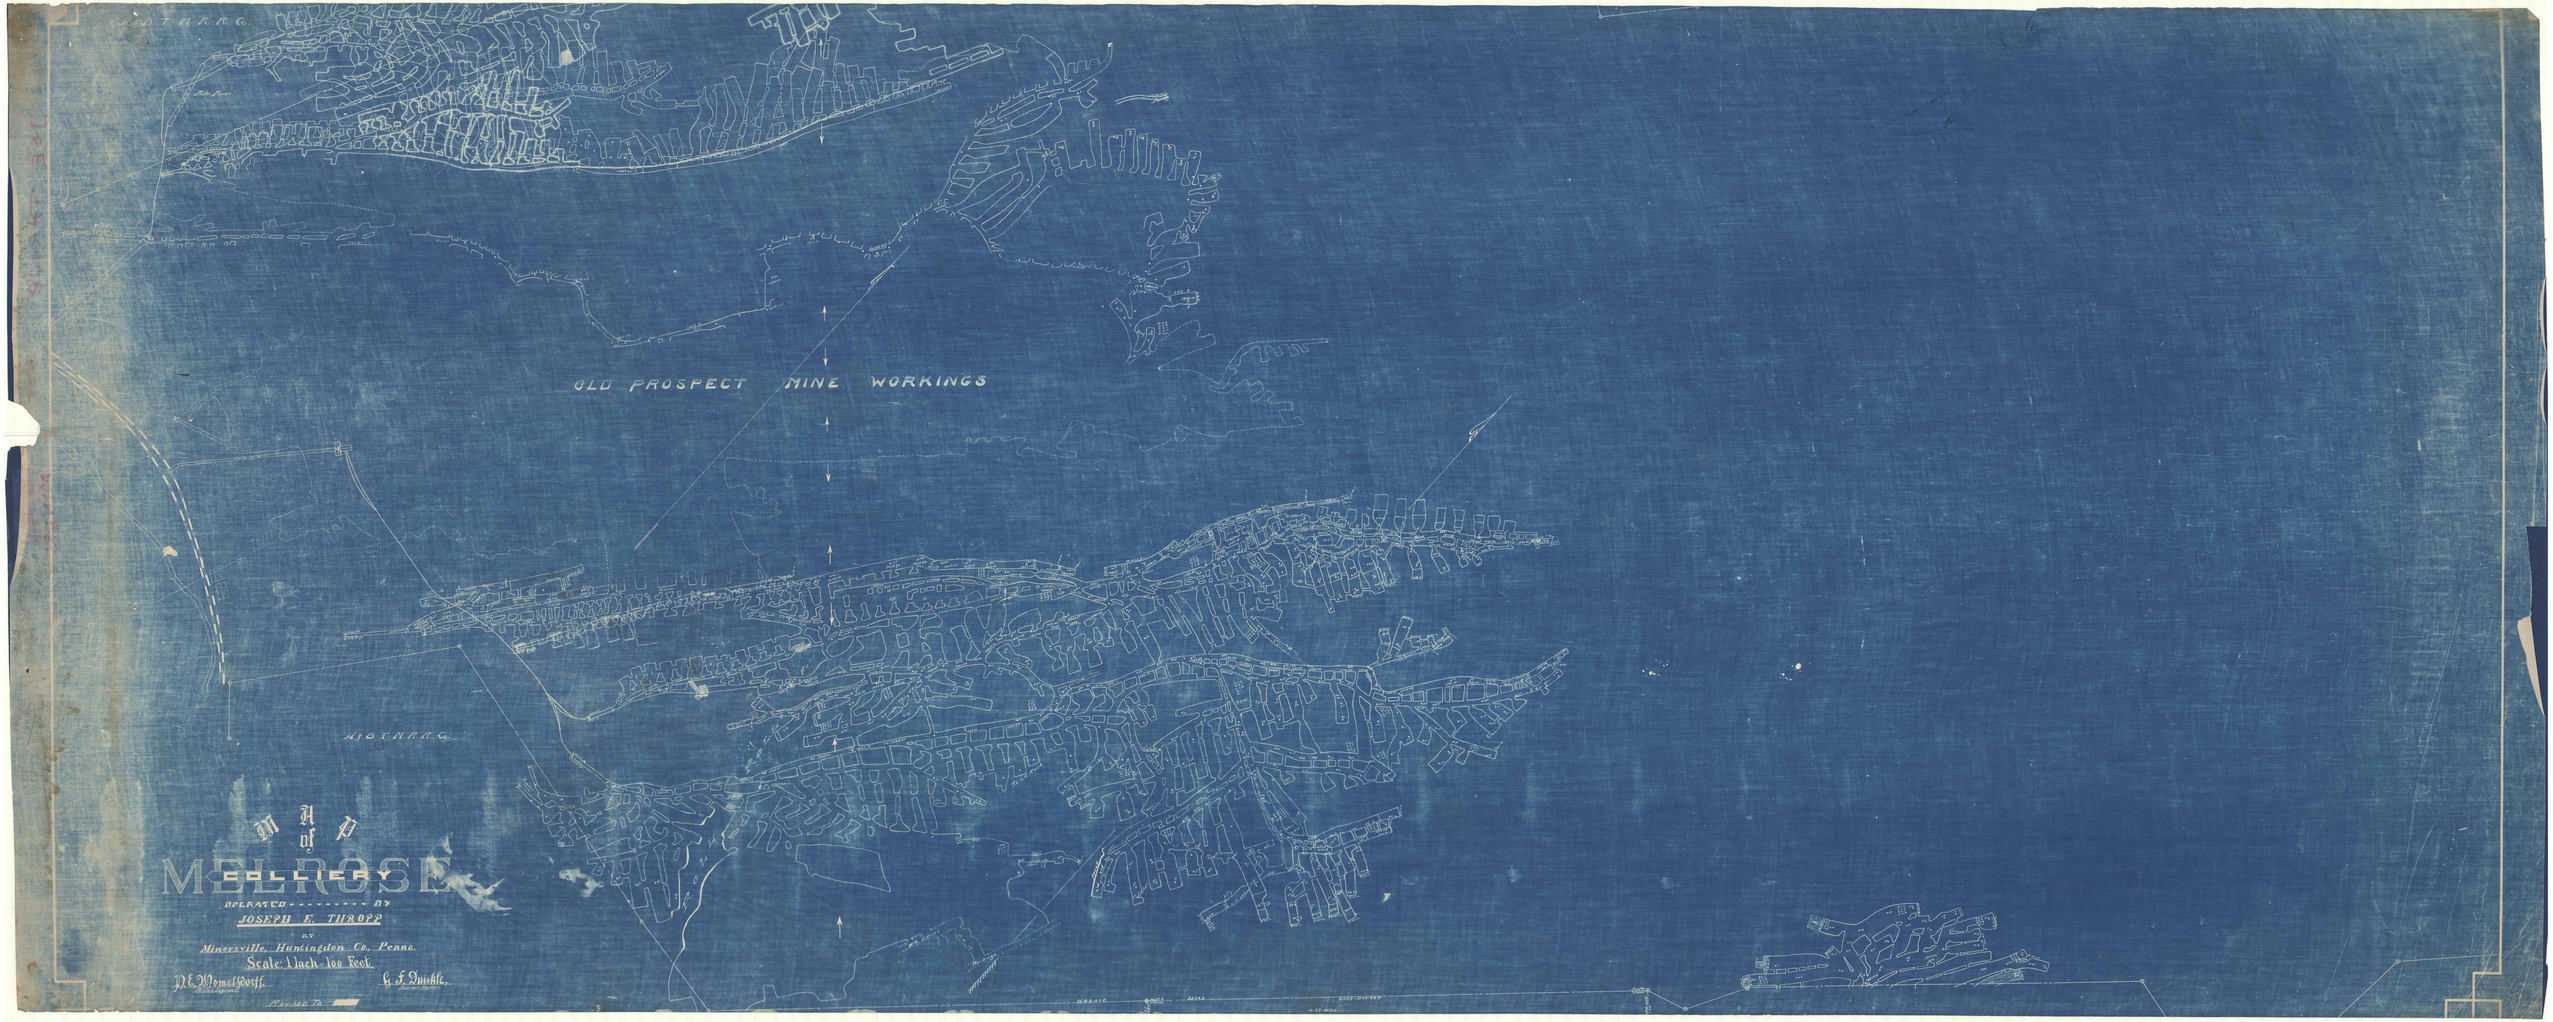
OLD PROSPECT MINE WORKINGS
MELROSE
COLLIERY
OPERATED BY
JOSEPH E. THROPP
AT
Minersville, Huntingdon Co., Penna.
Scale: 1 Inch = 100 Feet
N. E. Momelsdorff
G. F. Dunkle
Revised To