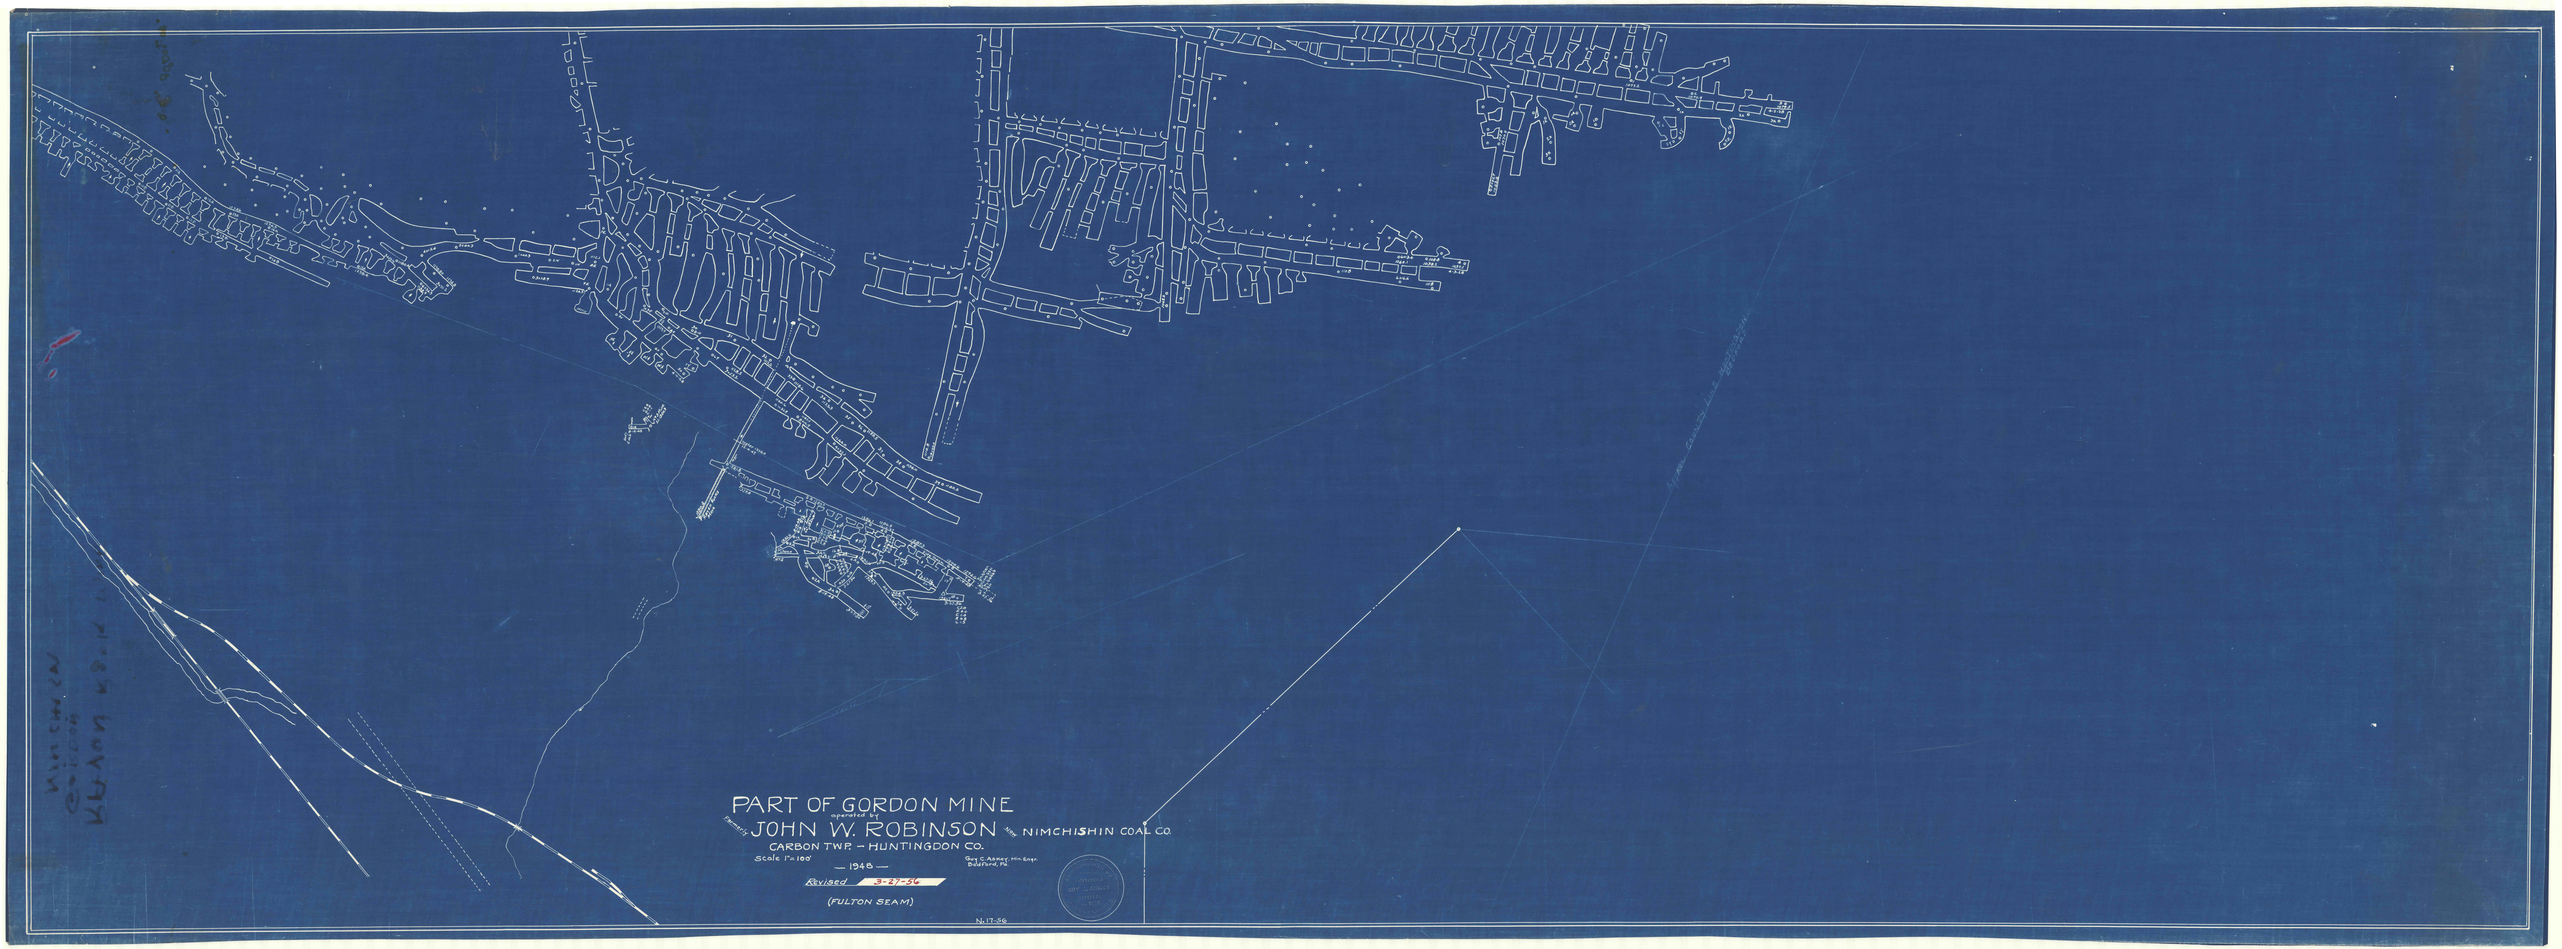
PART OF GORDON MINE
operated by
JOHN W. ROBINSON
NIMCHISHIN COAL CO.
CARBON TWP. – HUNTINGDON CO.
Scale 1"=100'
— 1946 —
Geo. C. Abney Min. Engr.
Bedford, Pa.
Revised 3-27-56
(FULTON SEAM)
N. 17-56