


Plotted by J. W. Reed
JUDITH #3

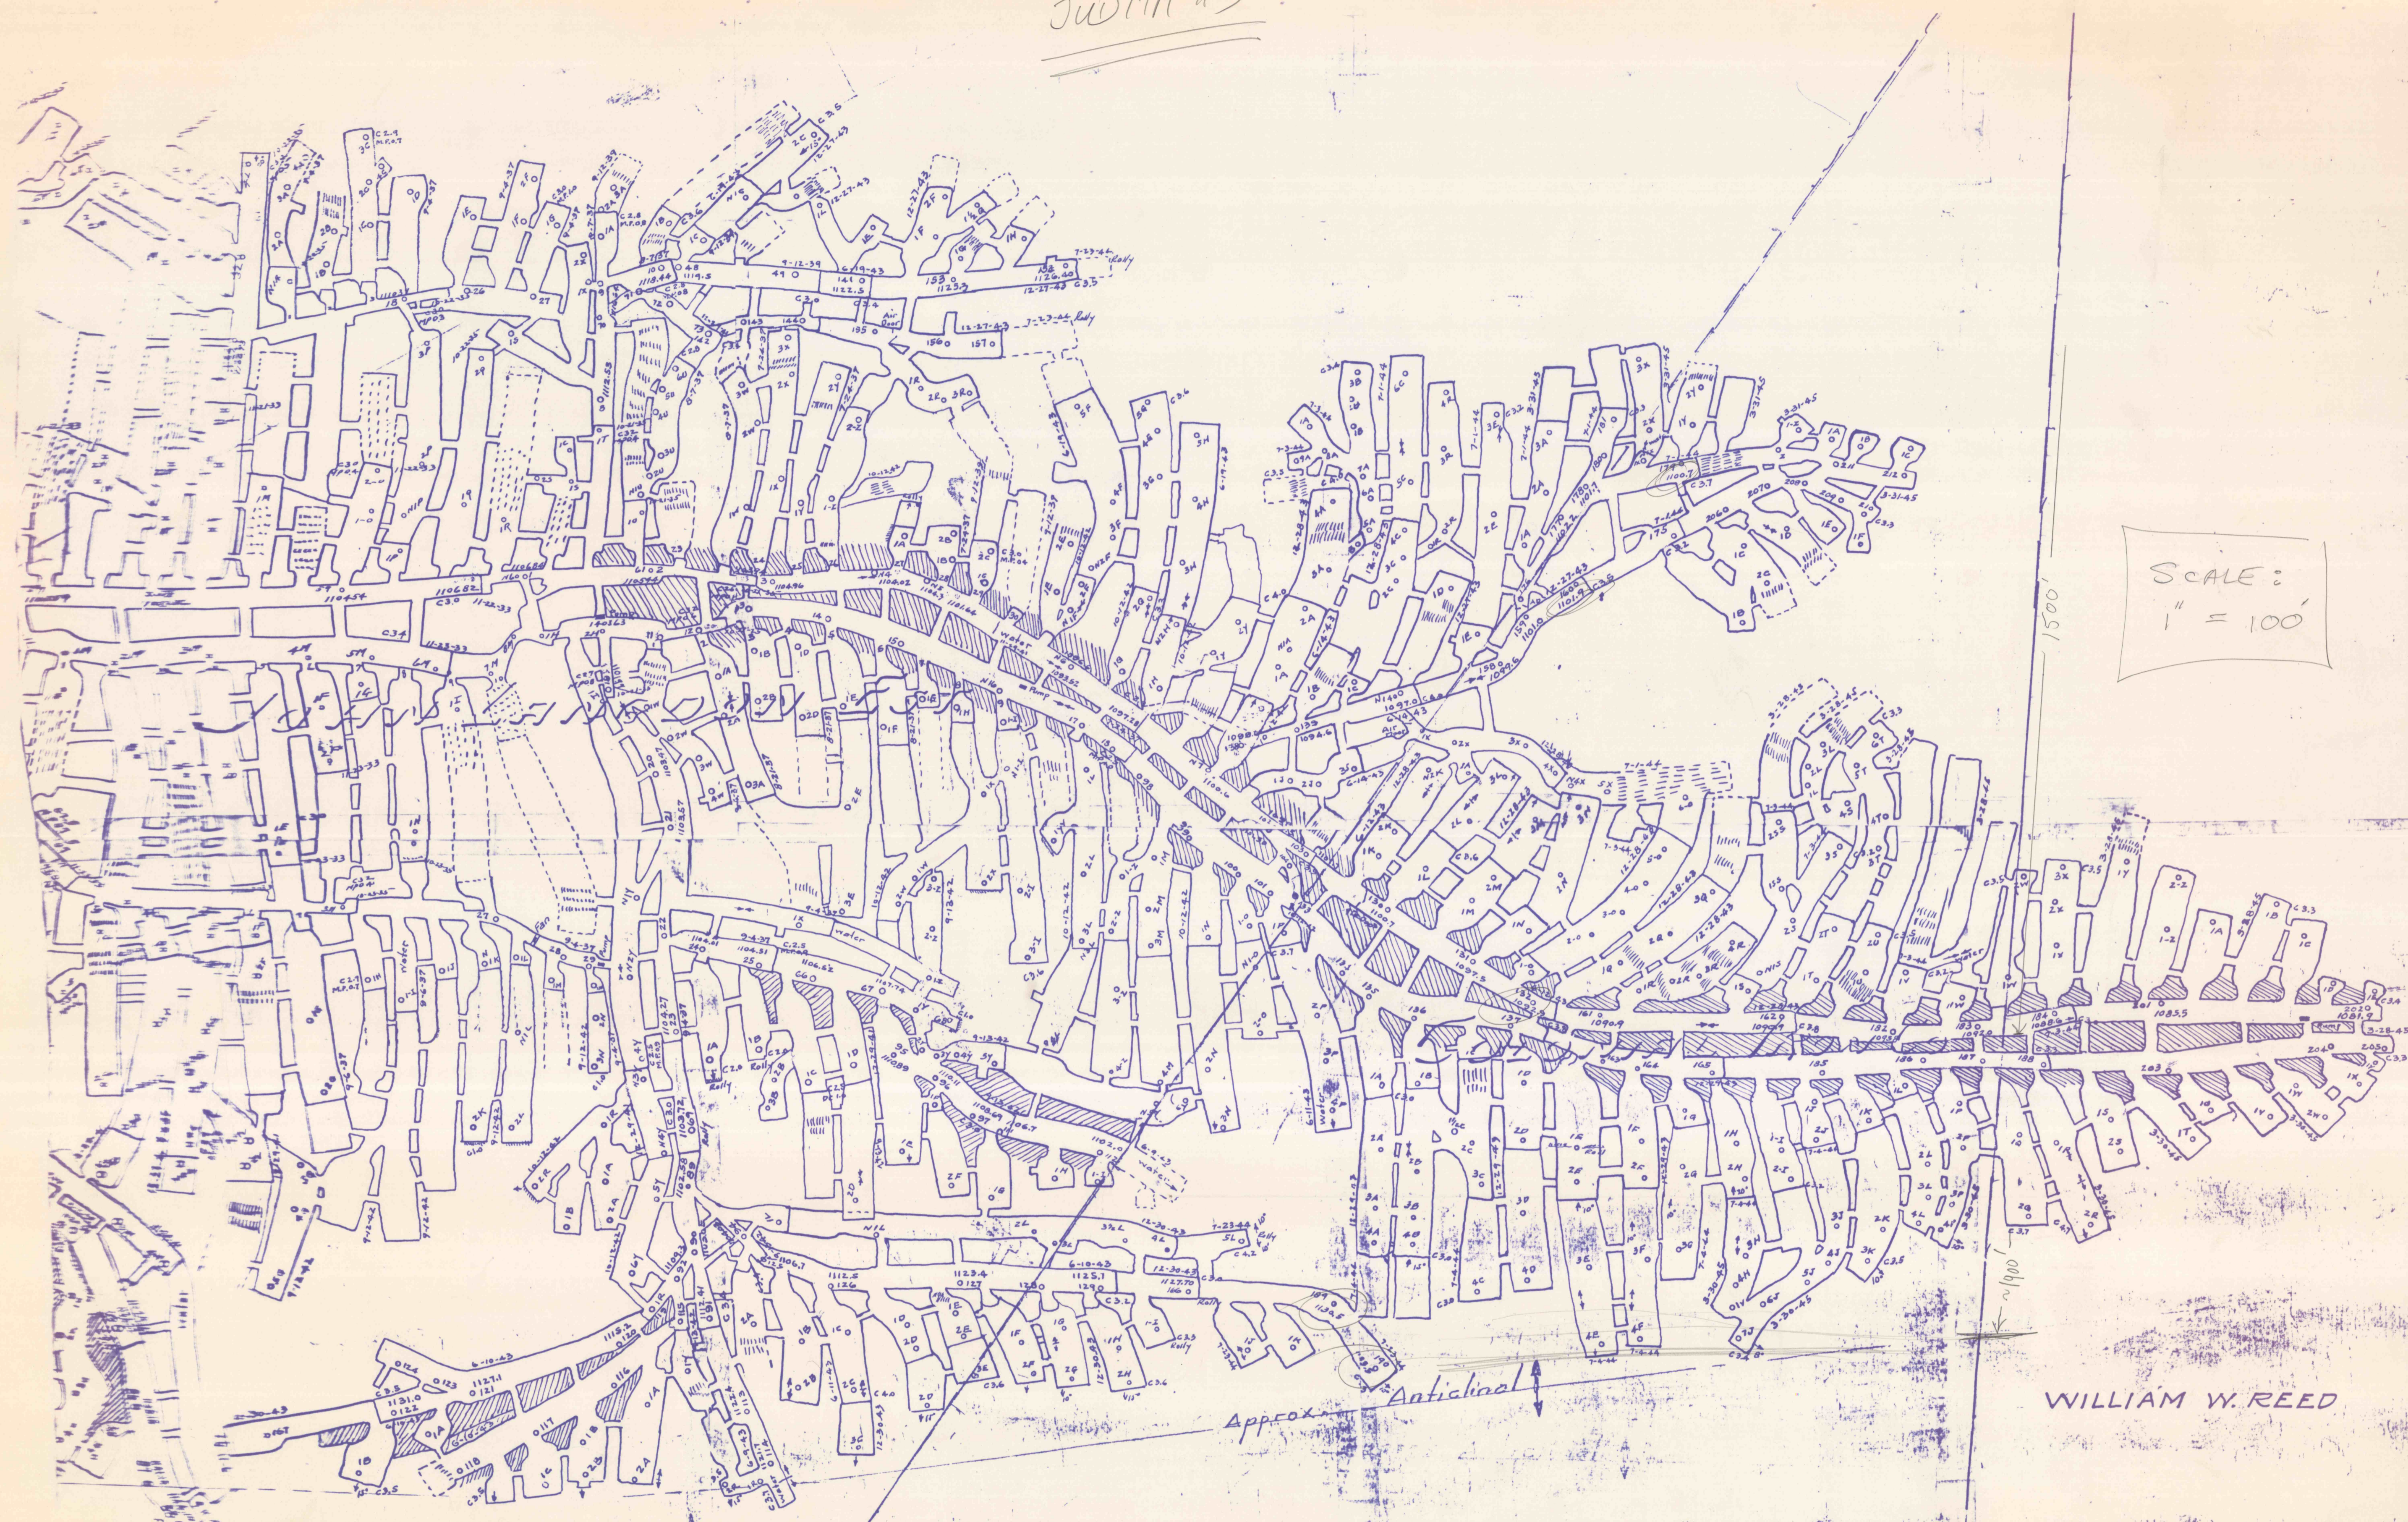

SCALE:
1" = 100'

Approx Anticline

PART OF
PATTON TRACT

WILLIAM W. REED

