RITCHEY MINE
ON
E. EICHELBERGER & CO. PROPERTY
BROADTOP TWP. BEDFORD CO.

Scale 1"=100'

Guy C. Askey, Min. Engr.
Bedford, Pa.

KELLY SEAM

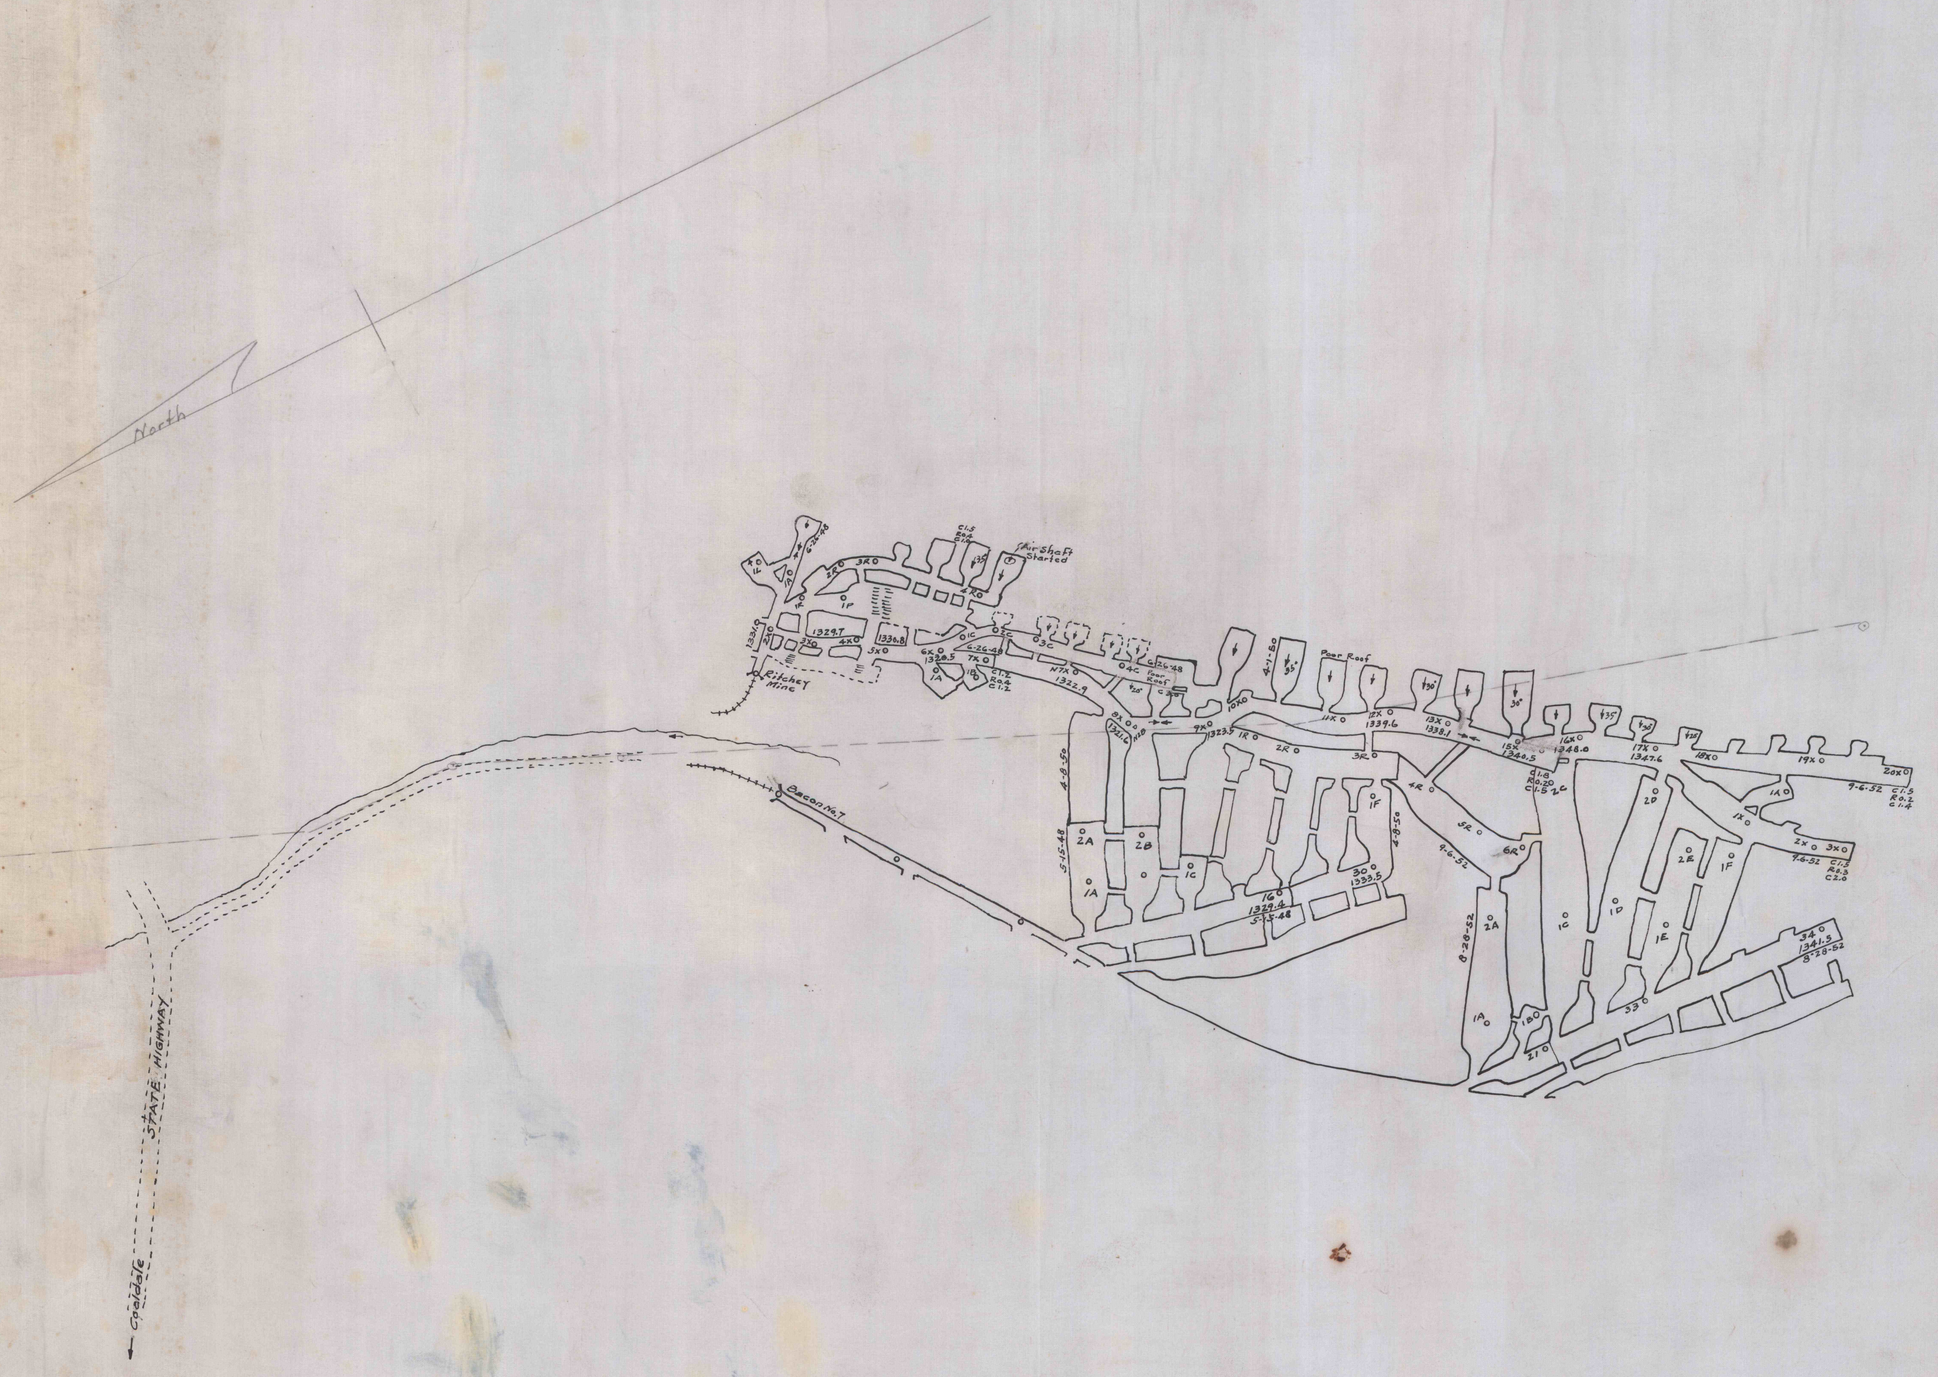

B-7, AT-3, N-58
G.C.A. 6-30-48