
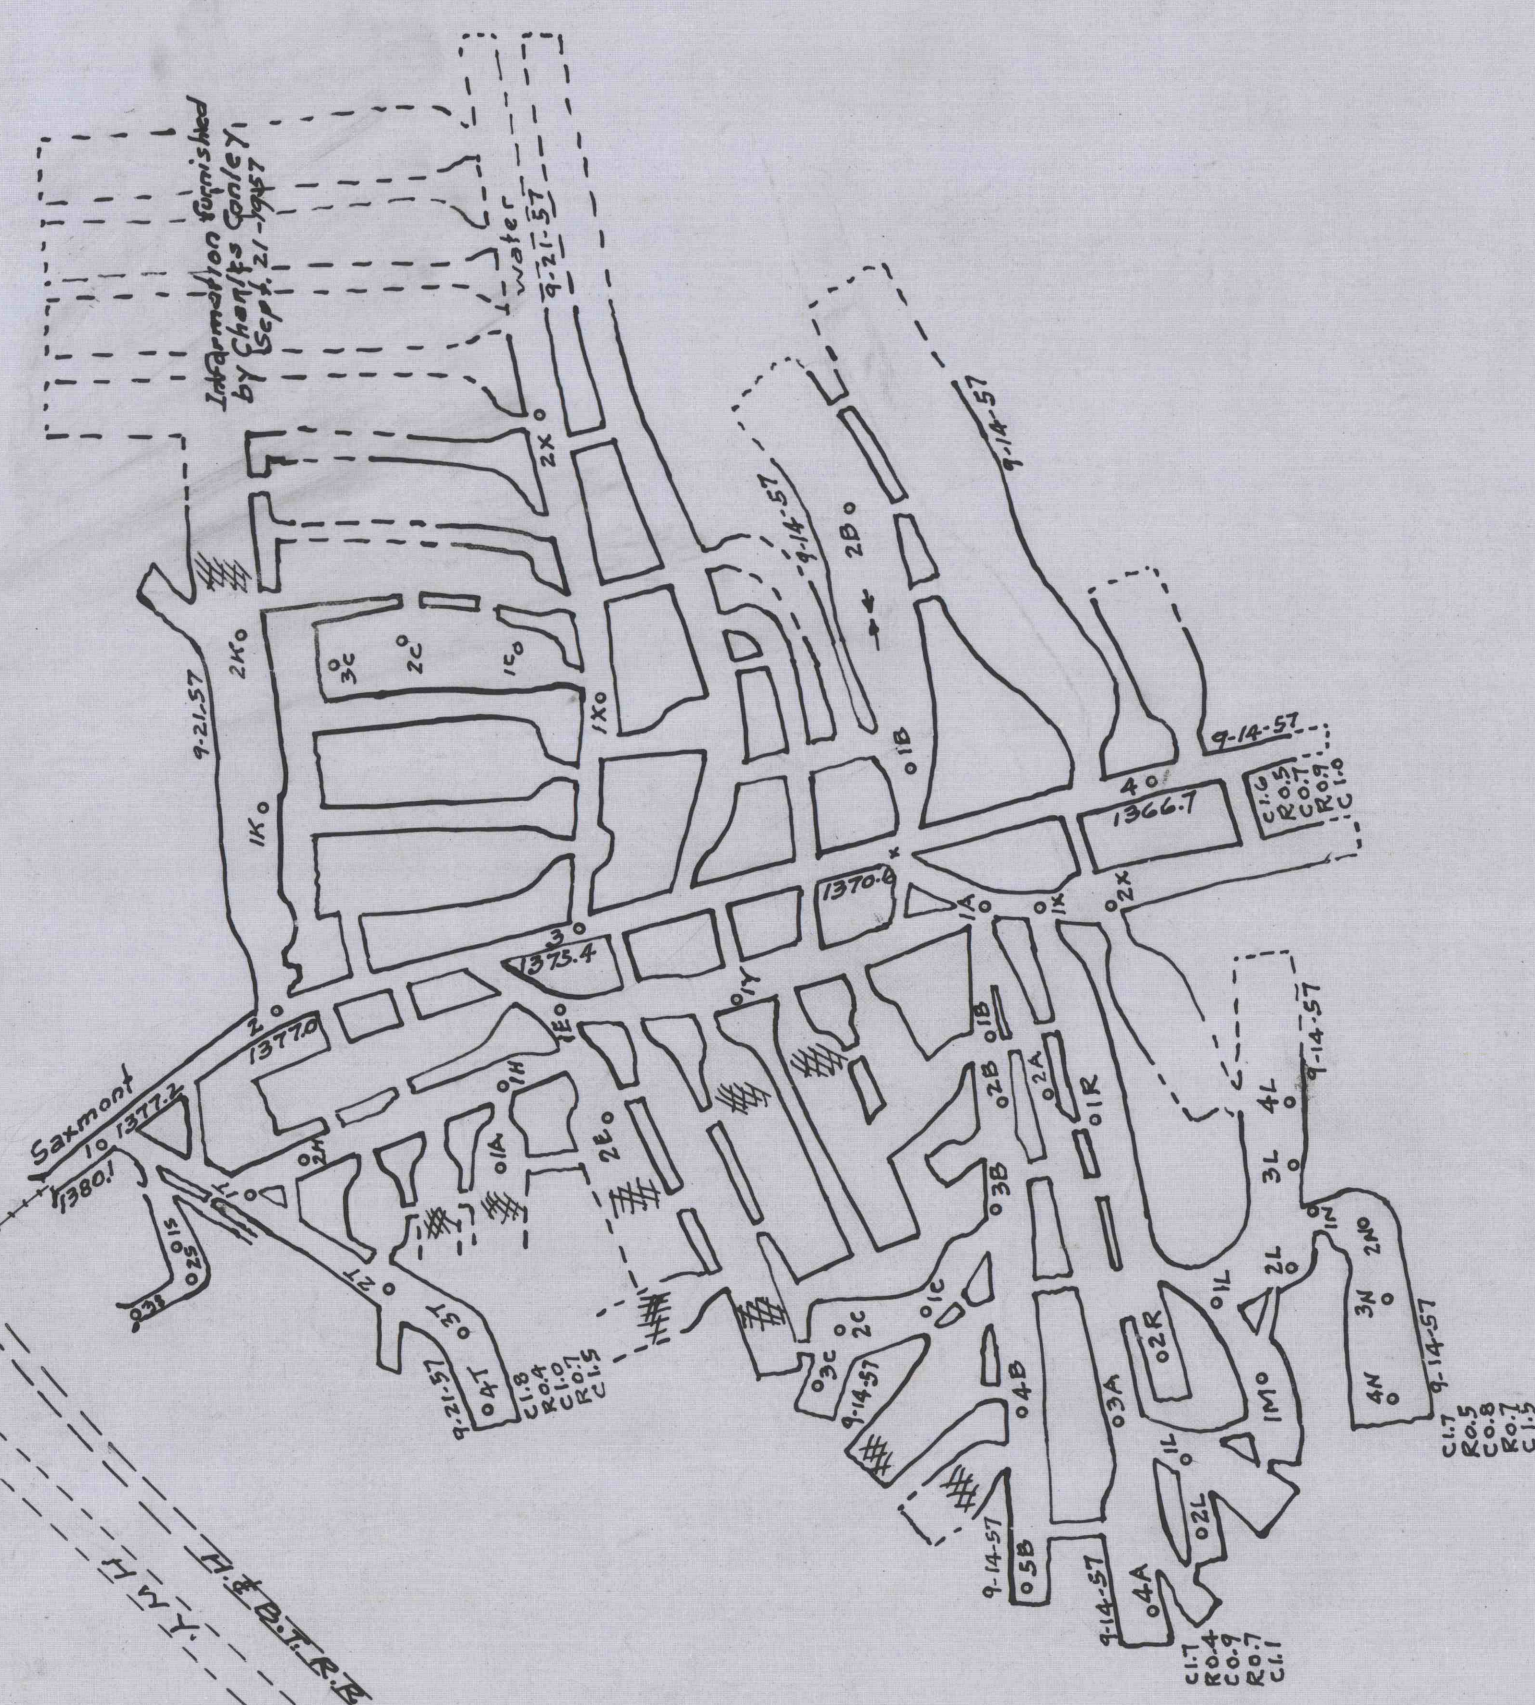


MIN
TOWN
24000

LEMORE COAL CO.
(George H. Lemoire)

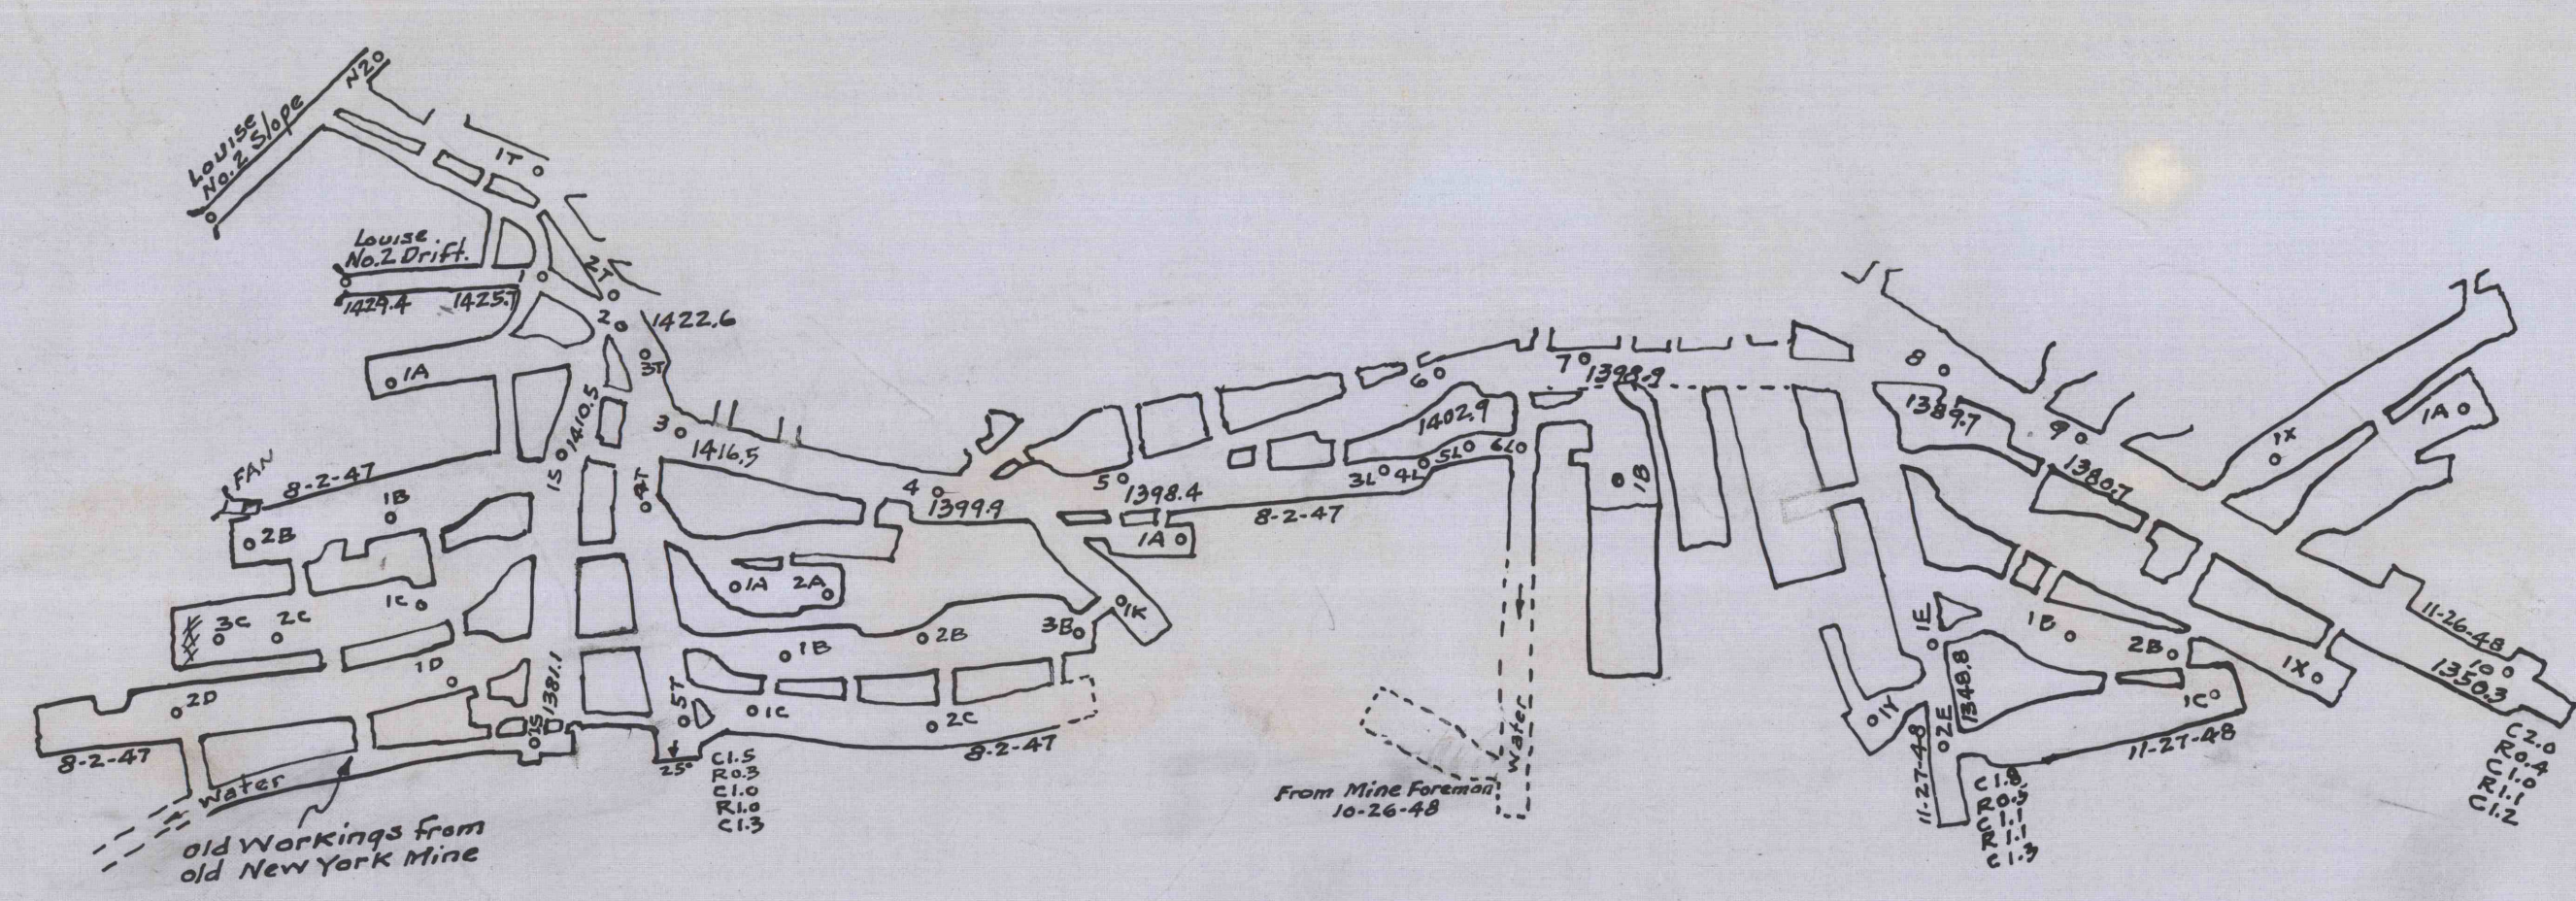

WILLIAM W. REED
(John Hamilton Tract)

NEW ENTERPRISE STONE & LIME CO.
(John Hamilton Tract)

JOHN LANGDON EST.

WILDAY GRACE COAL CO.

SAXMONT MINE

operated by
CONLEY BROTHERS COAL CO.
BROAD TOP TWR - BEDFORD CO. PA.

Scale: 1"=100'

-1937-

GUY C. ASKEY, Min. Engr.
Bedford, Pa.

Revised to

