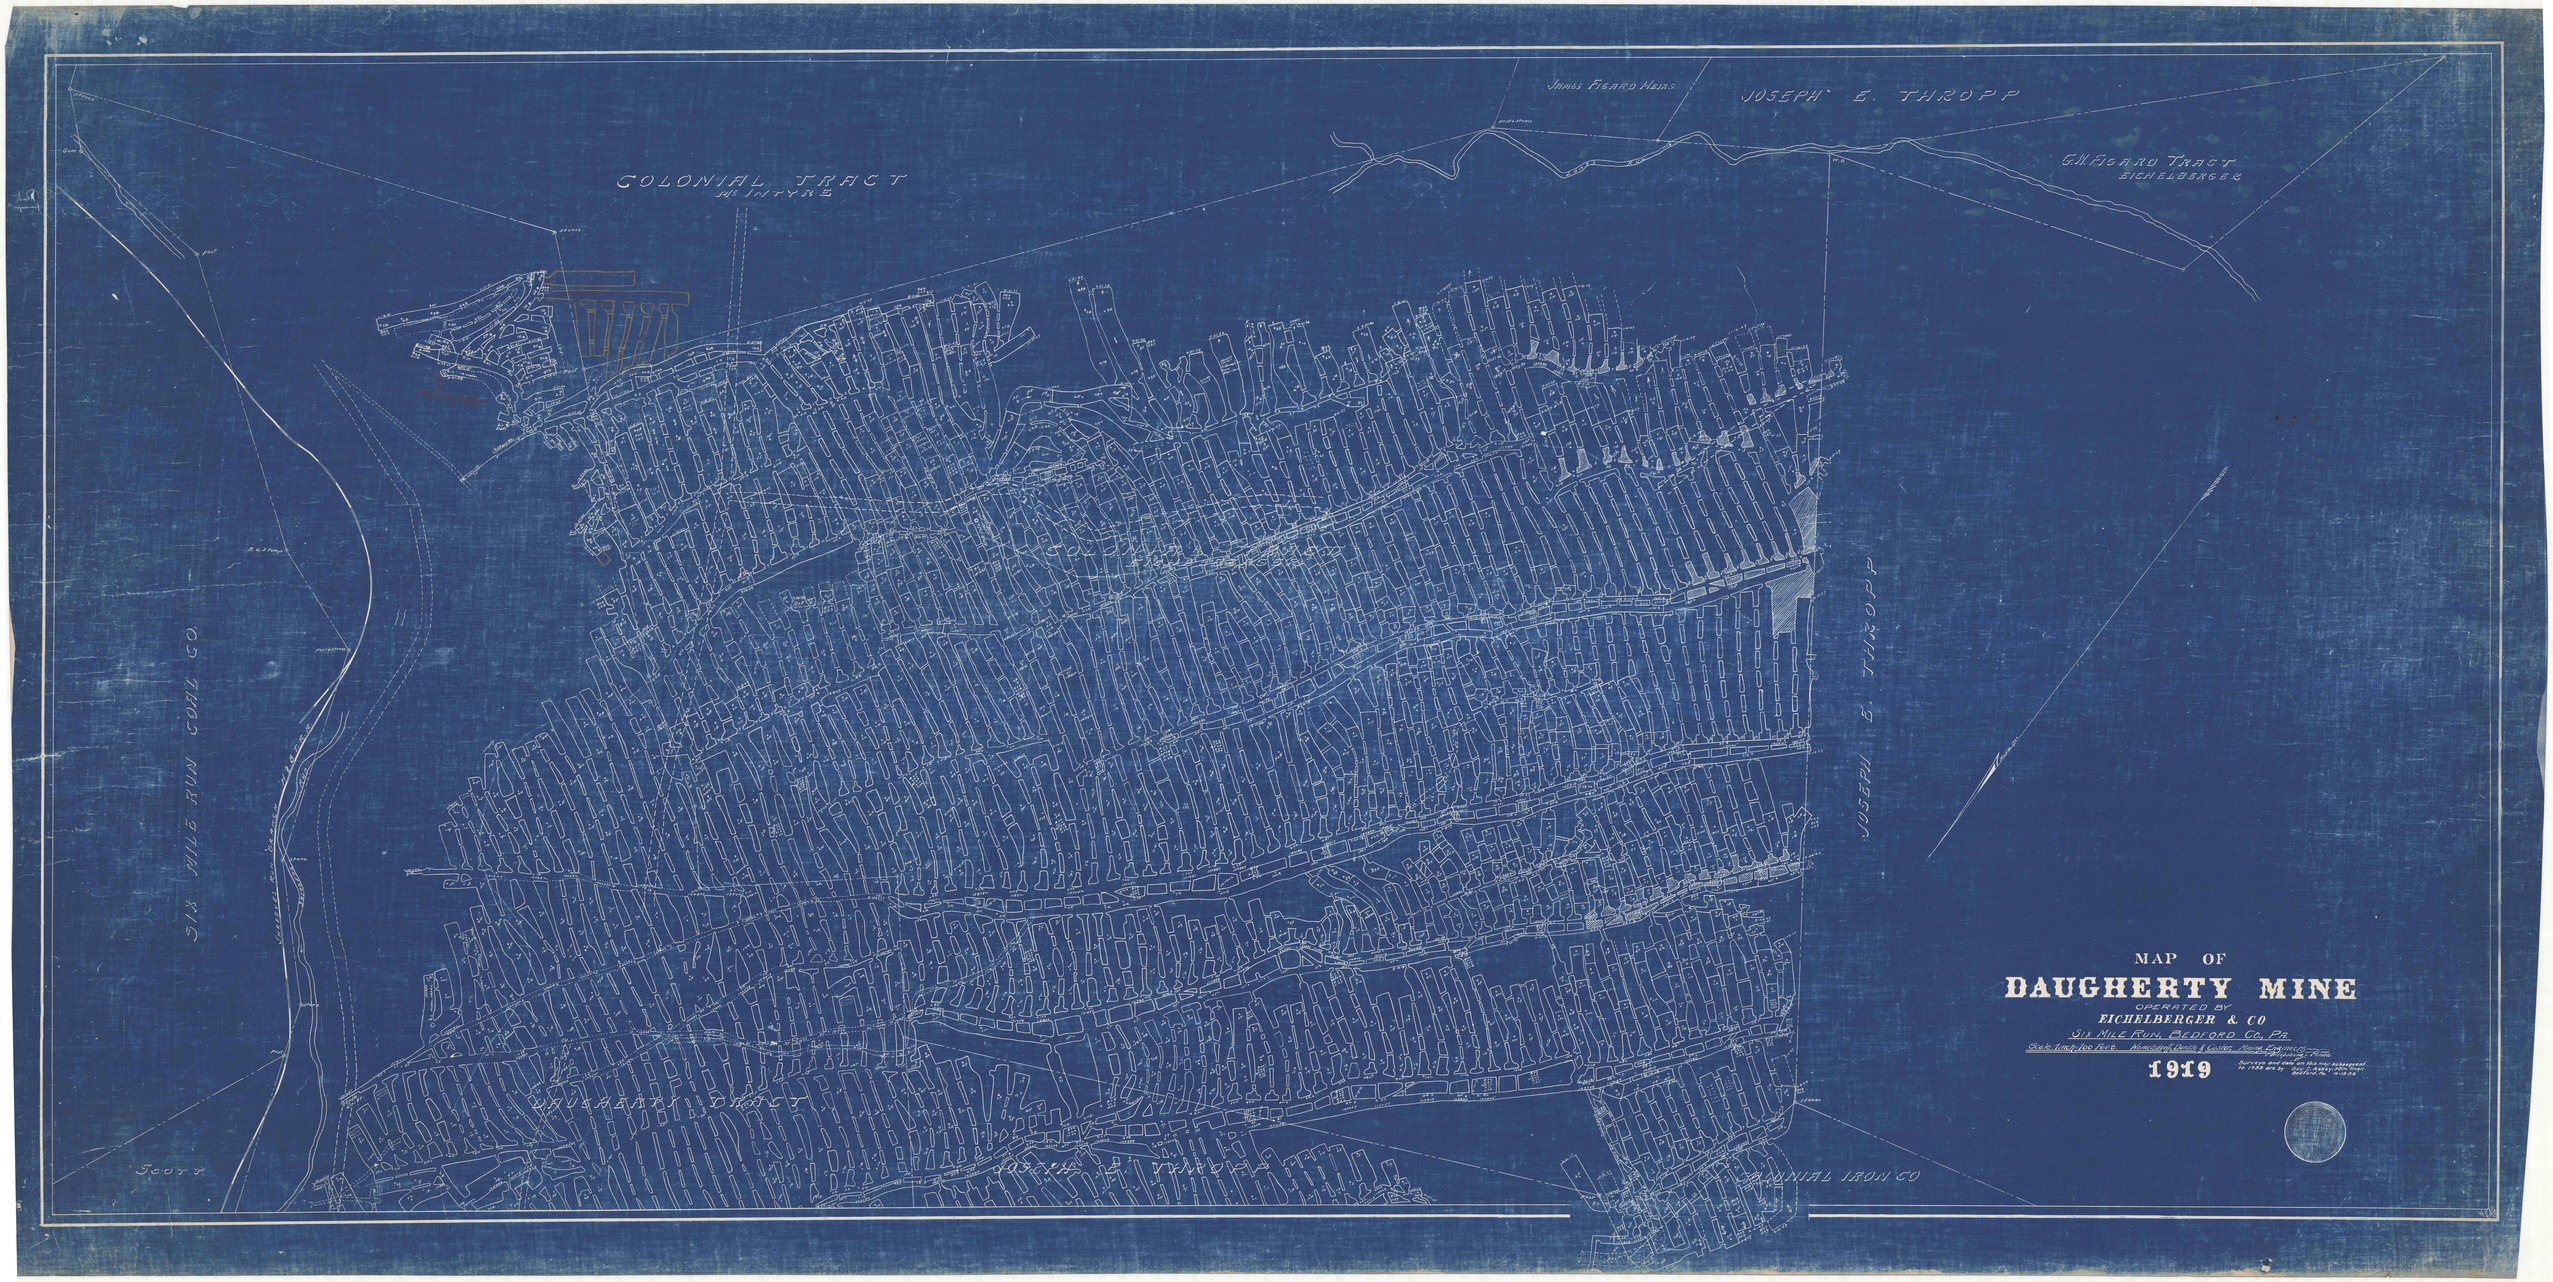

MAP OF

DAUGHERTY MINE

OPERATED BY

EICHELBERGER & CO

SIX MILE RUN, BEDFORD CO. PA.

Scale 1 inch = 100 Feet. Number of Drills 1 County Mining Engineer

1919

Surveys and data on this map subsequent to 1918 are by [illegible] Bedford Pa. 1919-20