


AND NEW
MAP
OLD WORKINGS ON KELLY SEAM
E. EICHELBERGER & CO.

BROADTOP TOWNSHIP — BEDFORD COUNTY

Scale: 1" = 100'

— 1944 —

Guy C. Askey, Min. Engr.
Bedford, Pa.

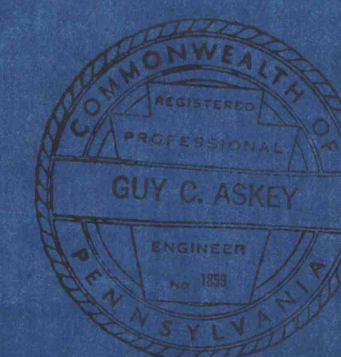

AND NEW WORKINGS OF BACON No. 7
OPERATED BY: MARTIN, MEINTYRE & MEINWIGT (1950)
Revised to **Feb. 1964**

Note: Kelly Seam workings shown on this map
were traced from old maps by S.S. Brown,
R.H. Kay, et al. Furnished by George Eichelberger,
1944.

BACON No. 7 (Kelly Seam)
OPERATED BY: HERMAN M. CLEVINGER (1964)

RIDDLESBURG MATERIALS CORP.

E. EICHELBERGER & CO.
Wigton Tract

LANGDON COAL CO.



Covered
Cave
Elev. 1000

Covered
Cave
Elev. 1000